
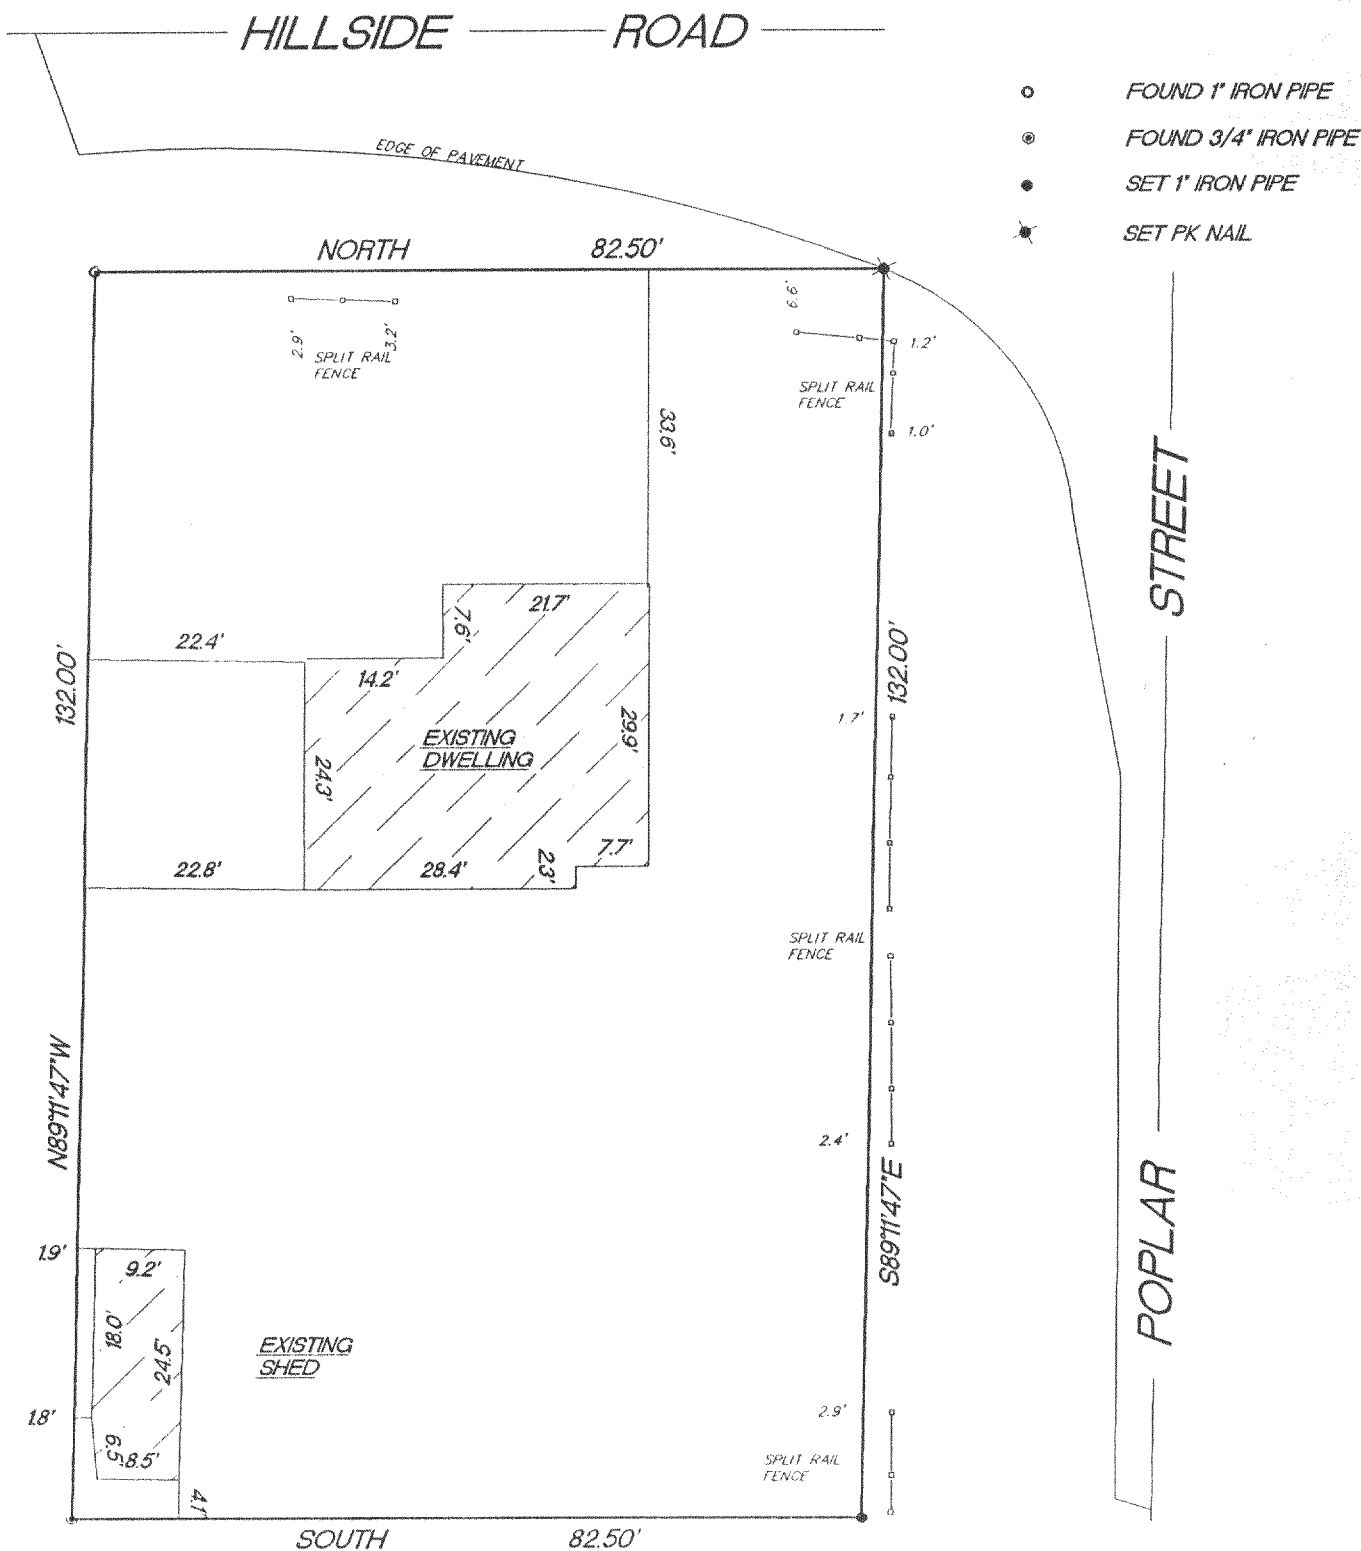


LOT 1, ROBINSON'S SUBDIVISION, located in Section 11, Town 1 North, range 17 East, Town of Linn, Walworth County, Wisconsin.

Survey address: N1714 Hillside Road

SCALE 1"=20'

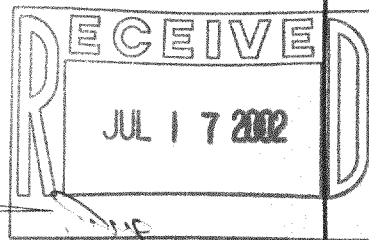

"This survey is made for the use of the present owners of the property, and also those who purchase, mortgage or guarantee the title thereto within one year from date hereof."

INC.

TERRANCE E.
PISARICK
S-1230
EAGLE,
WISCONSIN

LAND SURVEYOR

THIS IS NOT AN ORIGINAL SURVEY UNLESS THE SEAL IS RED.

5/28/02

DATE _____

TEP/DW

FIELD WORK BY

TEP

DRAWN BY

02071

JOB NUMBER

1281-1

117-2126