

PREPARED FOR:
JERRY POLEK
N1849 LORAMOO LN.
LAKE GENEVA, 53147


PLAT OF SURVEY

J.K. SURVEYING INC.
N3705 WILLOWBEND LANE
LAKE GENEVA, WI, 53147
262-248-3697

- OF -

LOT 2 CERTIFIED SURVEY MAP NO. 1211 LOCATED IN THE
SOUTHEAST 1/4 OF SECTION 11, T.1.N., R.17.E, WALWORTH
COUNTY, WISCONSIN.

LOT 1

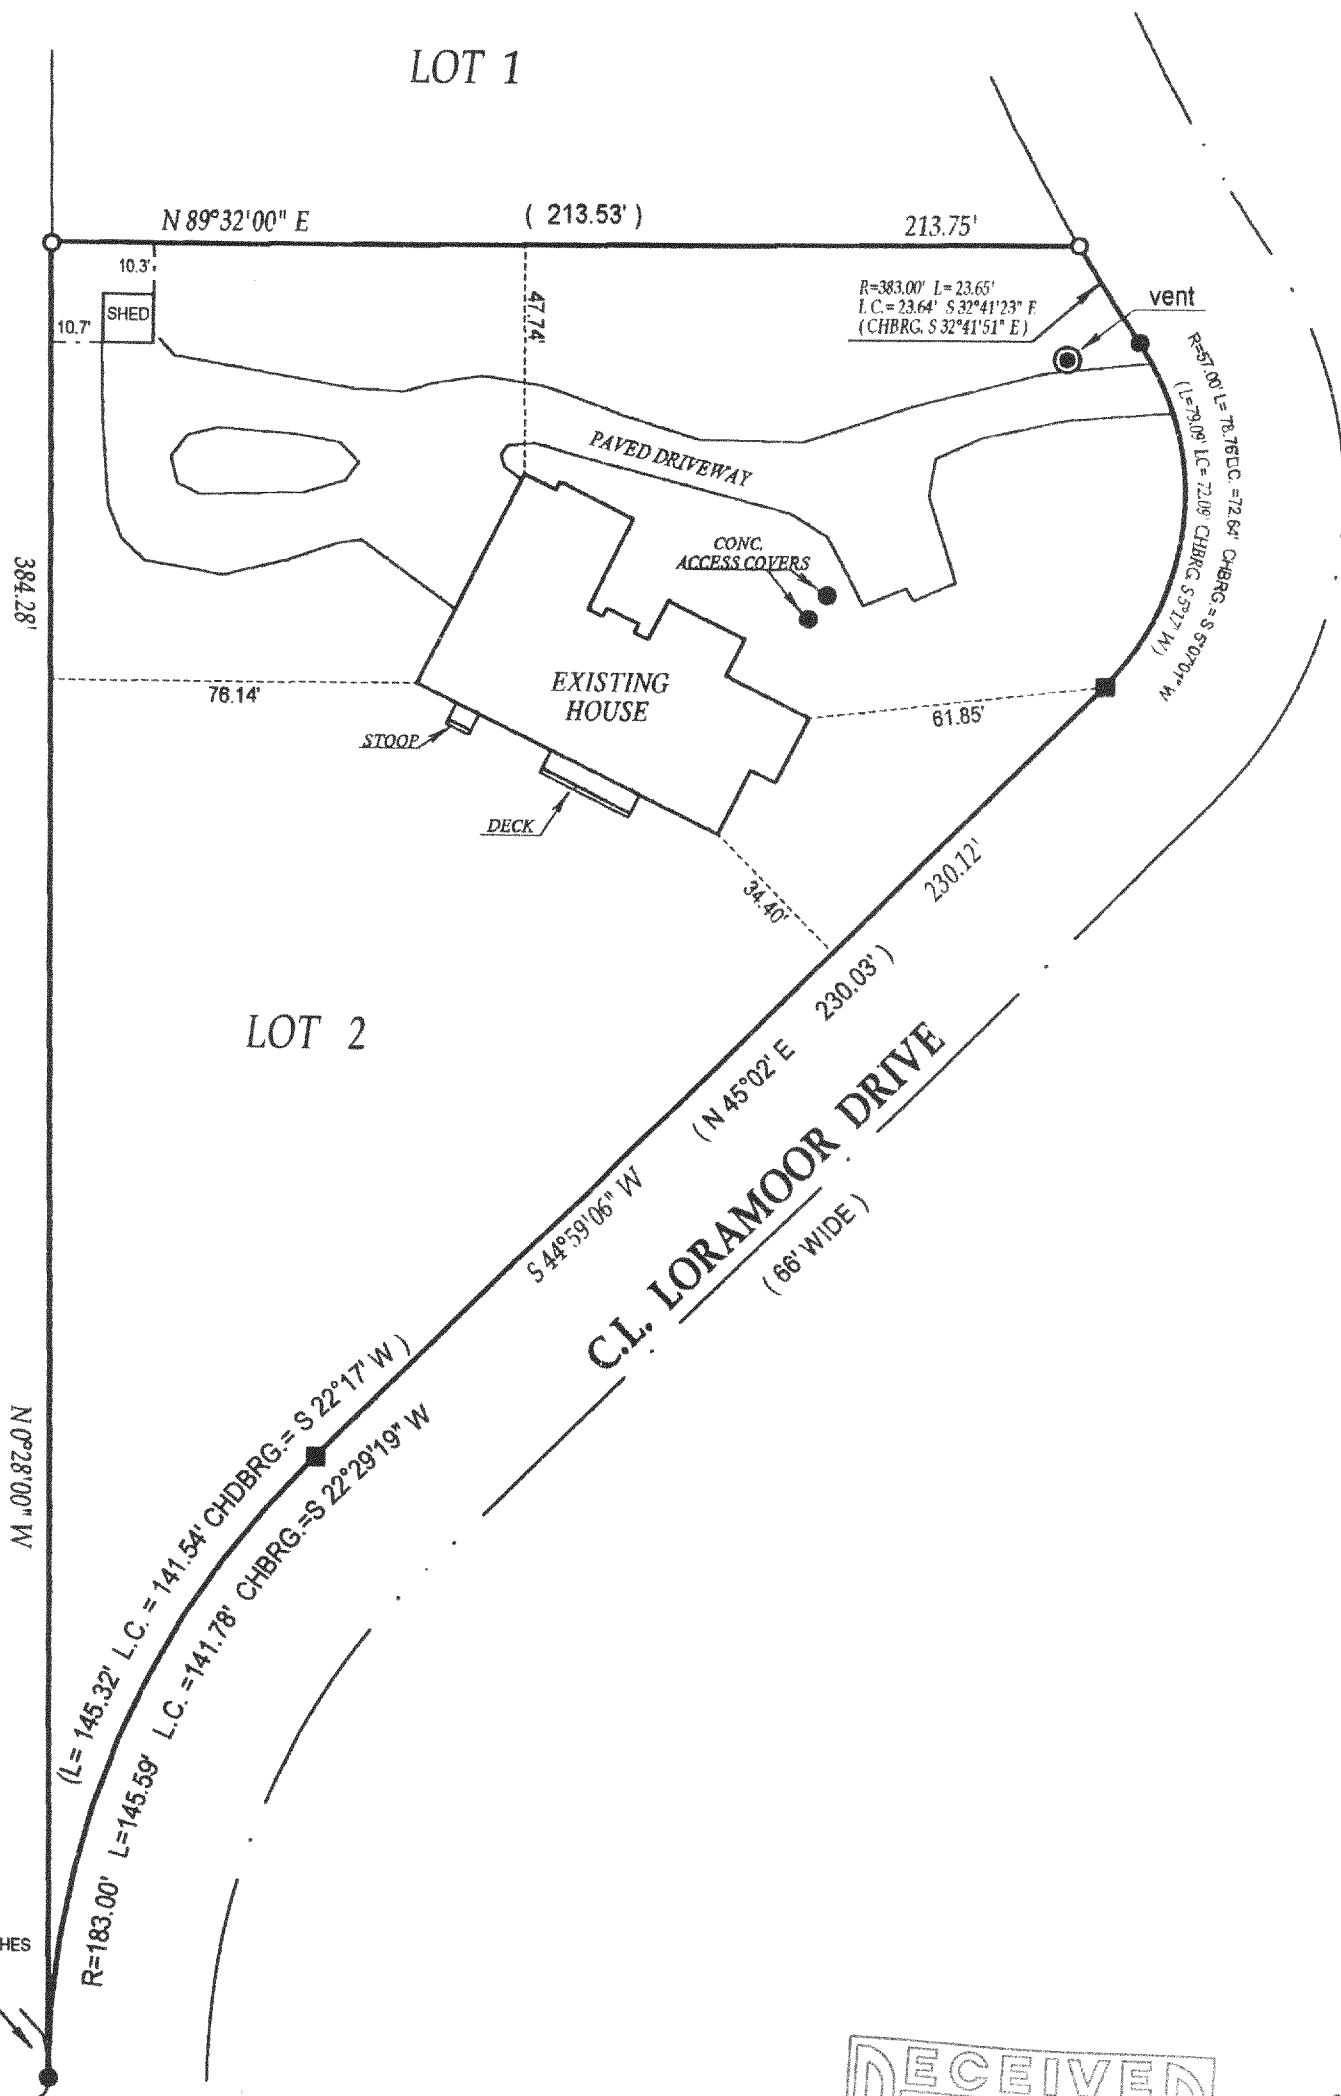

- () = recorded as
□ = found iron bar
○ = found iron pipe
● = set iron pipe
■ = set iron bar



DATE OF LAST REVISION 6/17/2002

COMPARE LEGAL DESCRIPTION ABOVE AND DRAWING WITH DEED. FOR BUILDING RESTRICTIONS AND EASEMENTS NOT SHOWN, REFER TO DEED, ABSTRACT SOURCES AND LOCAL MUNICIPAL CODES. NOTIFY THE SURVEYOR IMMEDIATELY OF ANY DISCREPANCY.

"I hereby certify that I have surveyed the above described property and that the above map is a true representation thereof and shows the size and location of all visible structures, apparent easements and encroachments if any."

This survey is made for the present owners of the property, and those who purchase, mortgage, or guarantee the title thereto, within one year from the date hereof.

DATED THIS 10 TH, DAY OF JUNE 20 02

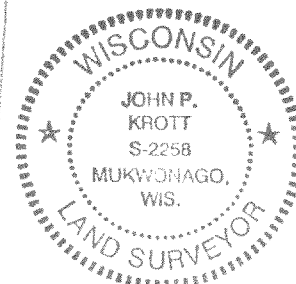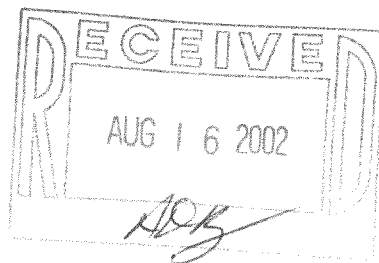

John P. Krott
JOHN KROTT S - 2258
Wisconsin Registered Land Surveyor
(original if signed in red)

SCALE 1" = 40'

JOB # 02-264

TAX ID # 1A121100002

117-2150