


Plat of Survey


of

Lots 24 and 26 and the North 1/2
of Lot 28 of Shore Haven,
located in the Northeast 1/4 of Section 18,
Town 1 North, Range 17 East, Town of Linn,
Walworth County, Wisconsin.



Surveyed for: Vincent Falcone
N1566 Shore Haven
Fontana, Wisconsin. 53125

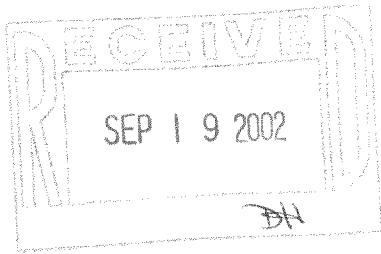

ISA-25

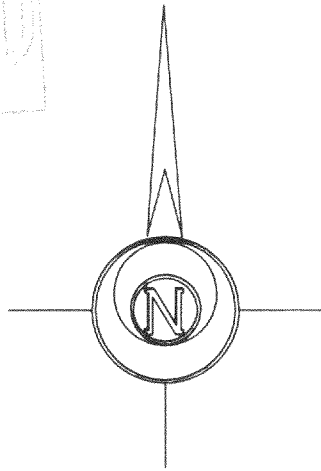

Bearings are assumed.

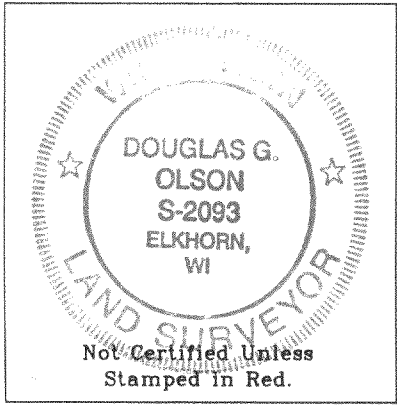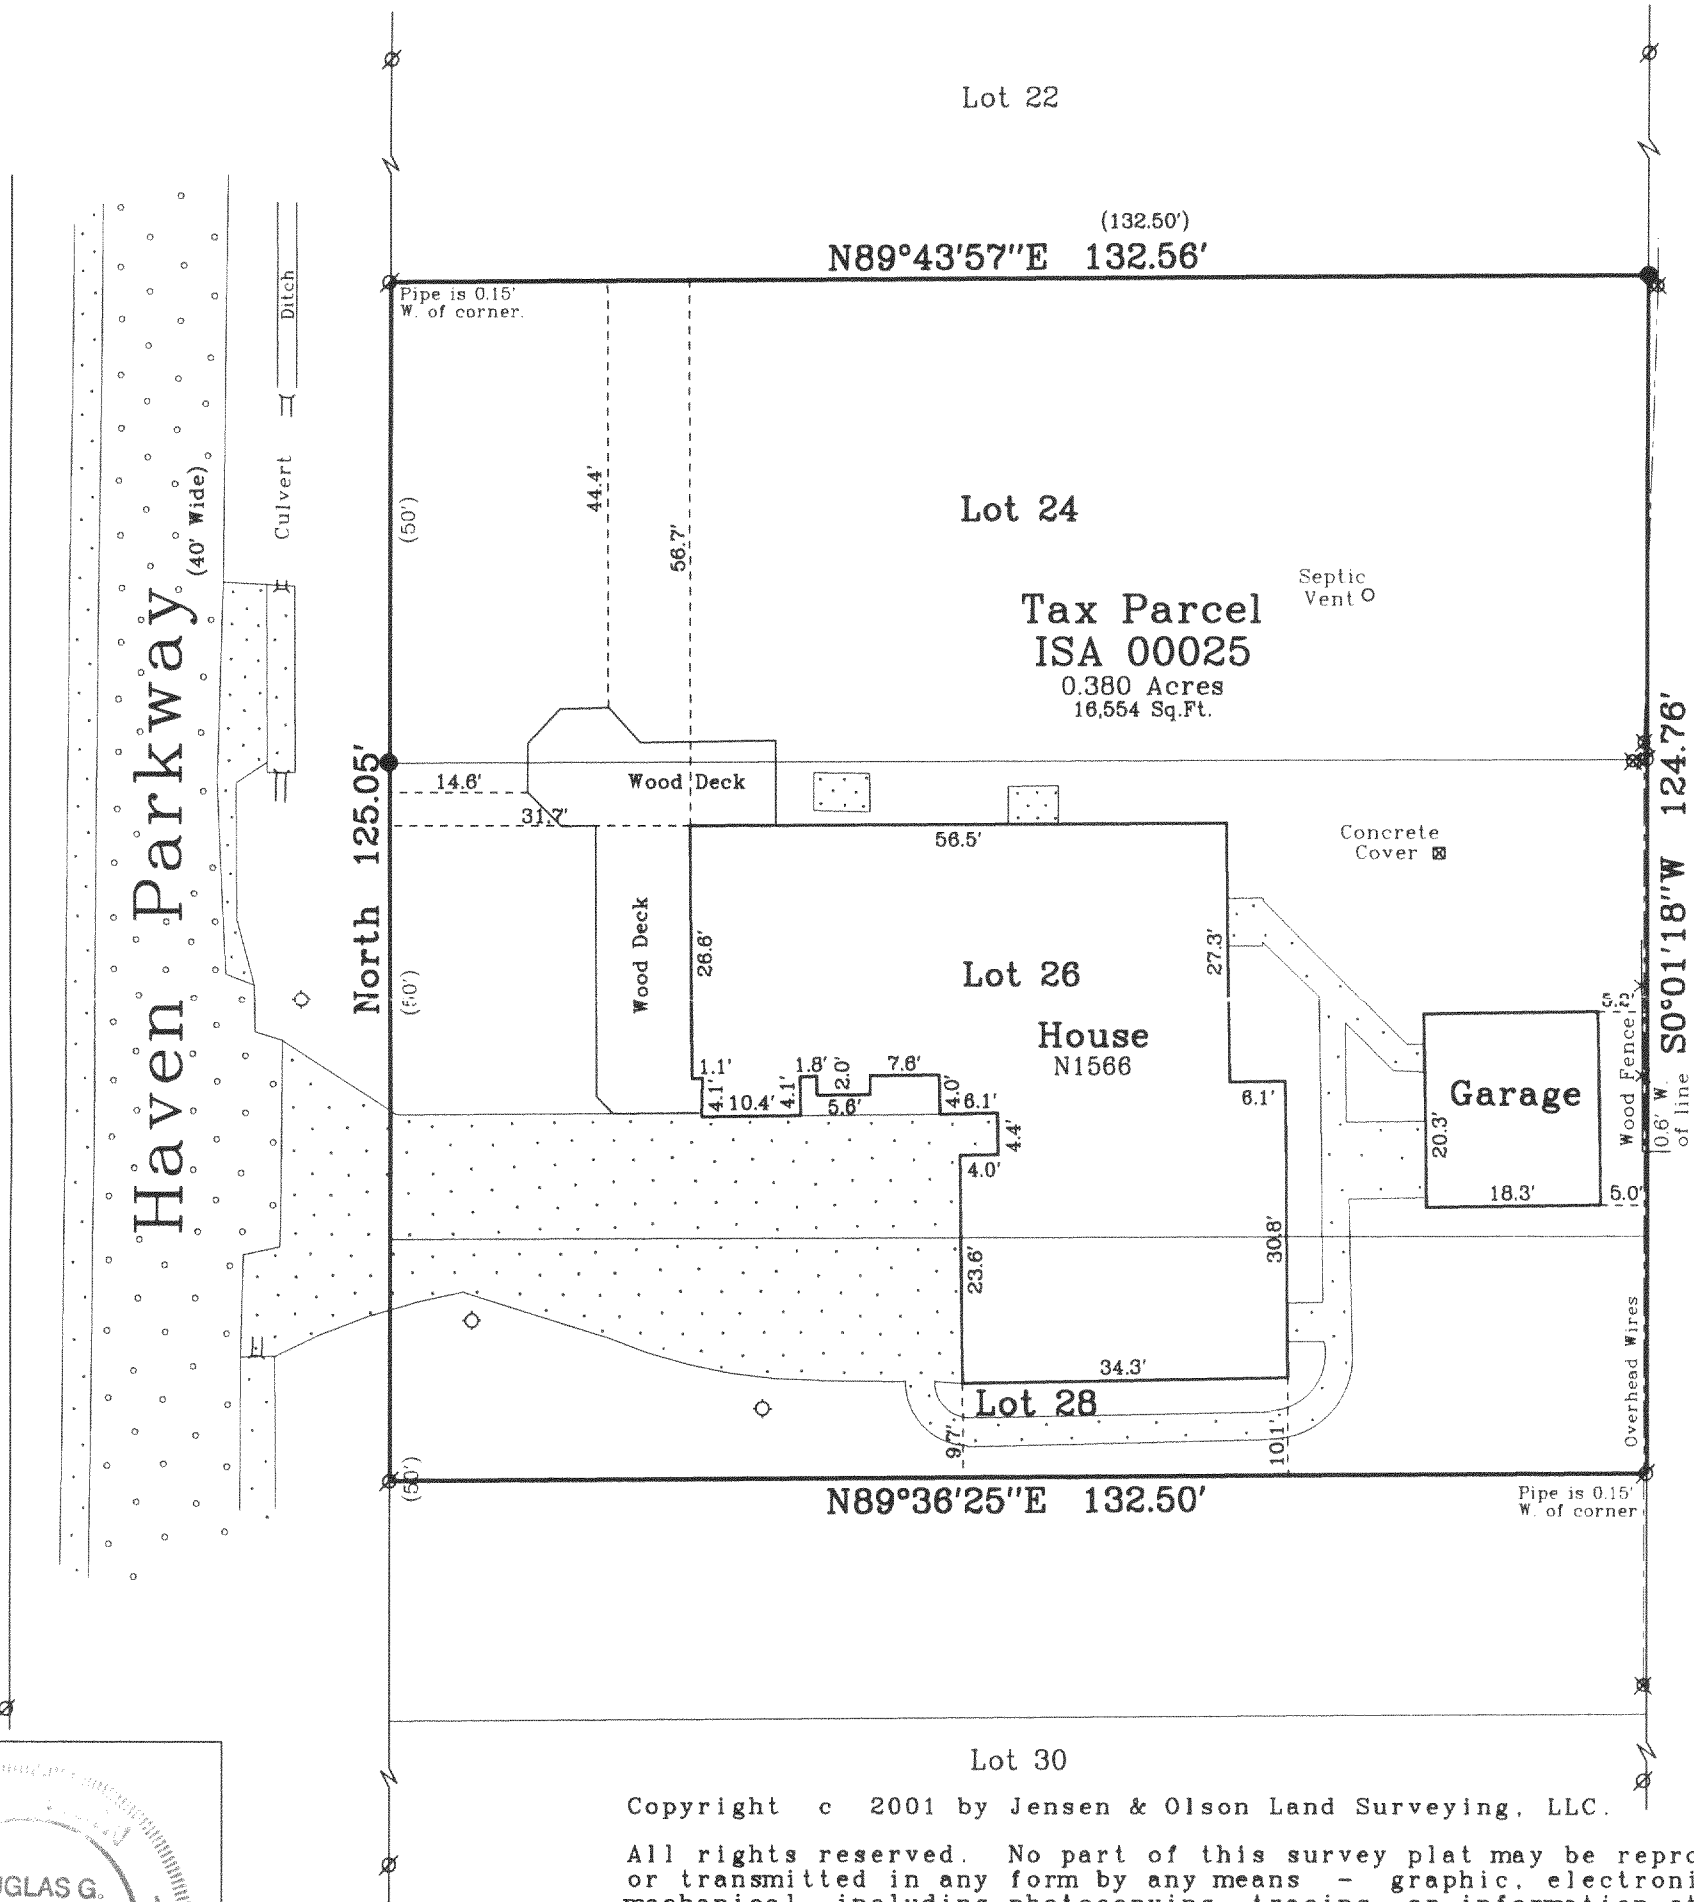

Copyright c 2001 by Jensen & Olson Land Surveying, LLC.

All rights reserved. No part of this survey plat may be reproduced or transmitted in any form by any means - graphic, electronic, or mechanical, including photocopying, tracing, or information storage and retrieval systems - without permission in writing from Douglas G. Olson, Jensen & Olson Land Surveying, LLC.

I, Douglas G. Olson, Wisconsin Registered Land Surveyor, do hereby certify that this survey was performed by me or under my direction in full compliance with the owner's/agent's instructions and Chapter A-E 7 of the Wisconsin Administrative Code "Minimum Standards for Property Surveys"; and that this map is an accurate representation thereof to the best of my knowledge and belief.

- Notes:
- 1) This survey plat is not certified unless signed and sealed in red ink.
 - 2) This survey is subject to Wisconsin lien laws. This Plat of Survey is the notice of intent to file lien. Lien waiver required.

Douglas G. Olson
Wisconsin Registered Land Surveyor - 2093

- Legend
- Found Iron Pipe
 - Set Iron Rod
 - Recorded Information
 - Concrete Surface
 - Asphalt Surface
 - Lamp
 - Culvert



Jensen & Olson Land Surveying, LLC

45 South Wisconsin Street P.O. Box 322
Elkhorn, Wisconsin. 53121
Telephone: (262) 723-3434
Facsimile: (262) 723-8044

Scale: 1" = 20'



Survey date: December 3, 2001.
Revisions:

Sheet 1 of 1 Sheets.

Job Reference Number:

2001.165 117-2167