


Detail
1"=30'


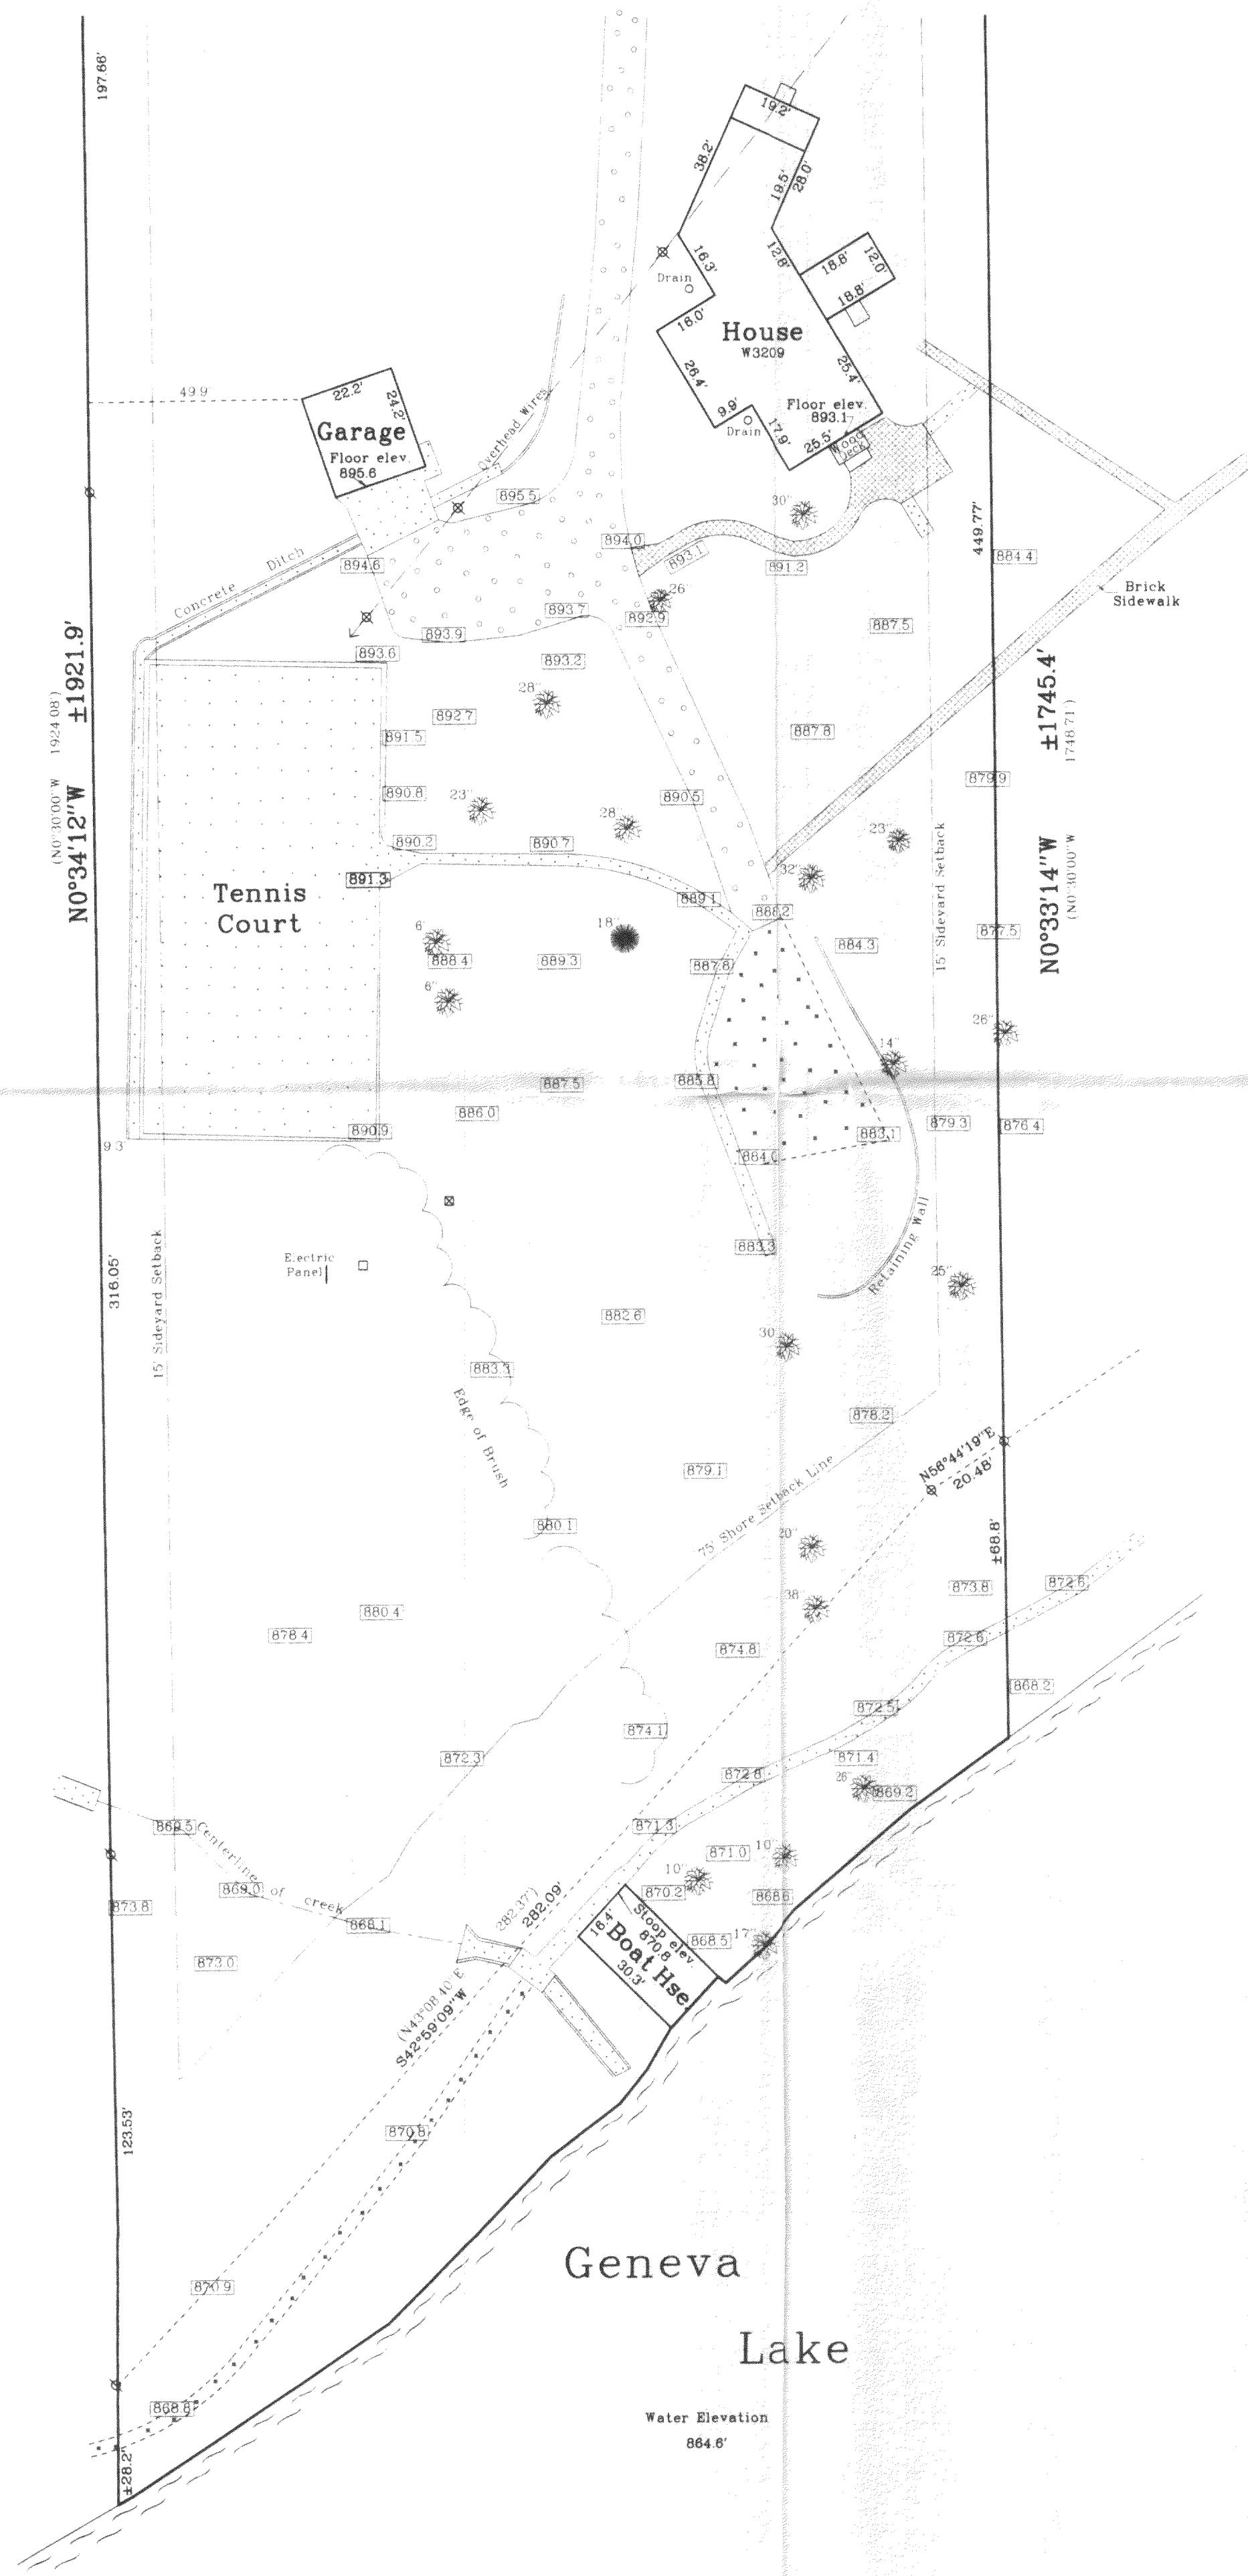


Plat of Survey

of
No. 46 Northwoodside

Lot 1 of Certified Survey Map No. 1174,
recorded in Vol. 5 of Certified Survey Maps of Walworth
County on Page 236 and located in the Northwest 1/4 of
Section 2, Town 1 North, Range 17 East, Town of Linn,
Walworth County, Wisconsin.

Surveyed for:
John Hagenah
512 Green Bay Road
Suite 301
Kennilworth, Illinois 60043

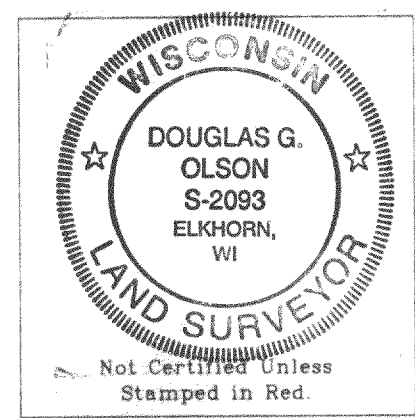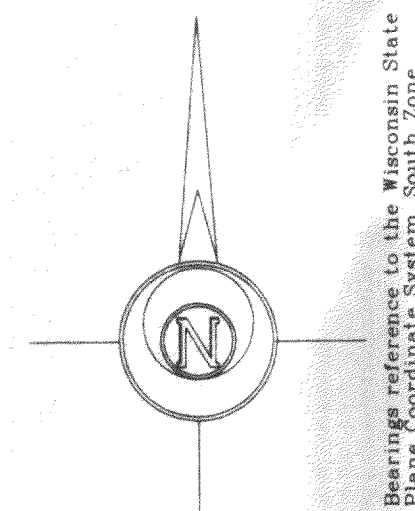


- Notes: 1) This survey plat is not certified unless signed and sealed in red ink.
2) This survey is subject to Wisconsin laws. This Plat of Survey is the notice of intent to file lien. Lien waiver required.


Copyright © 2001 by Jensen & Olson Land Surveying, LLC.
All rights reserved. No part of this survey plat may be reproduced or transmitted in any form by any means, graphic, electronic, or mechanical, including photocopying, tracing, or information storage and retrieval systems, without permission in writing from Douglas G. Olson, Jensen & Olson Land Surveying, LLC.

I, Douglas G. Olson, Wisconsin Registered Land Surveyor, do hereby certify that this survey was performed by me or under my direction in full compliance with the owner's/agent's instructions and Chapter A-E 7 of the Wisconsin Administrative Code, Minimum Standards for Property Surveyors, and that this map is an accurate representation thereof to the best of my knowledge and belief.

Douglas G. Olson
Wisconsin Registered Land Surveyor - 2093

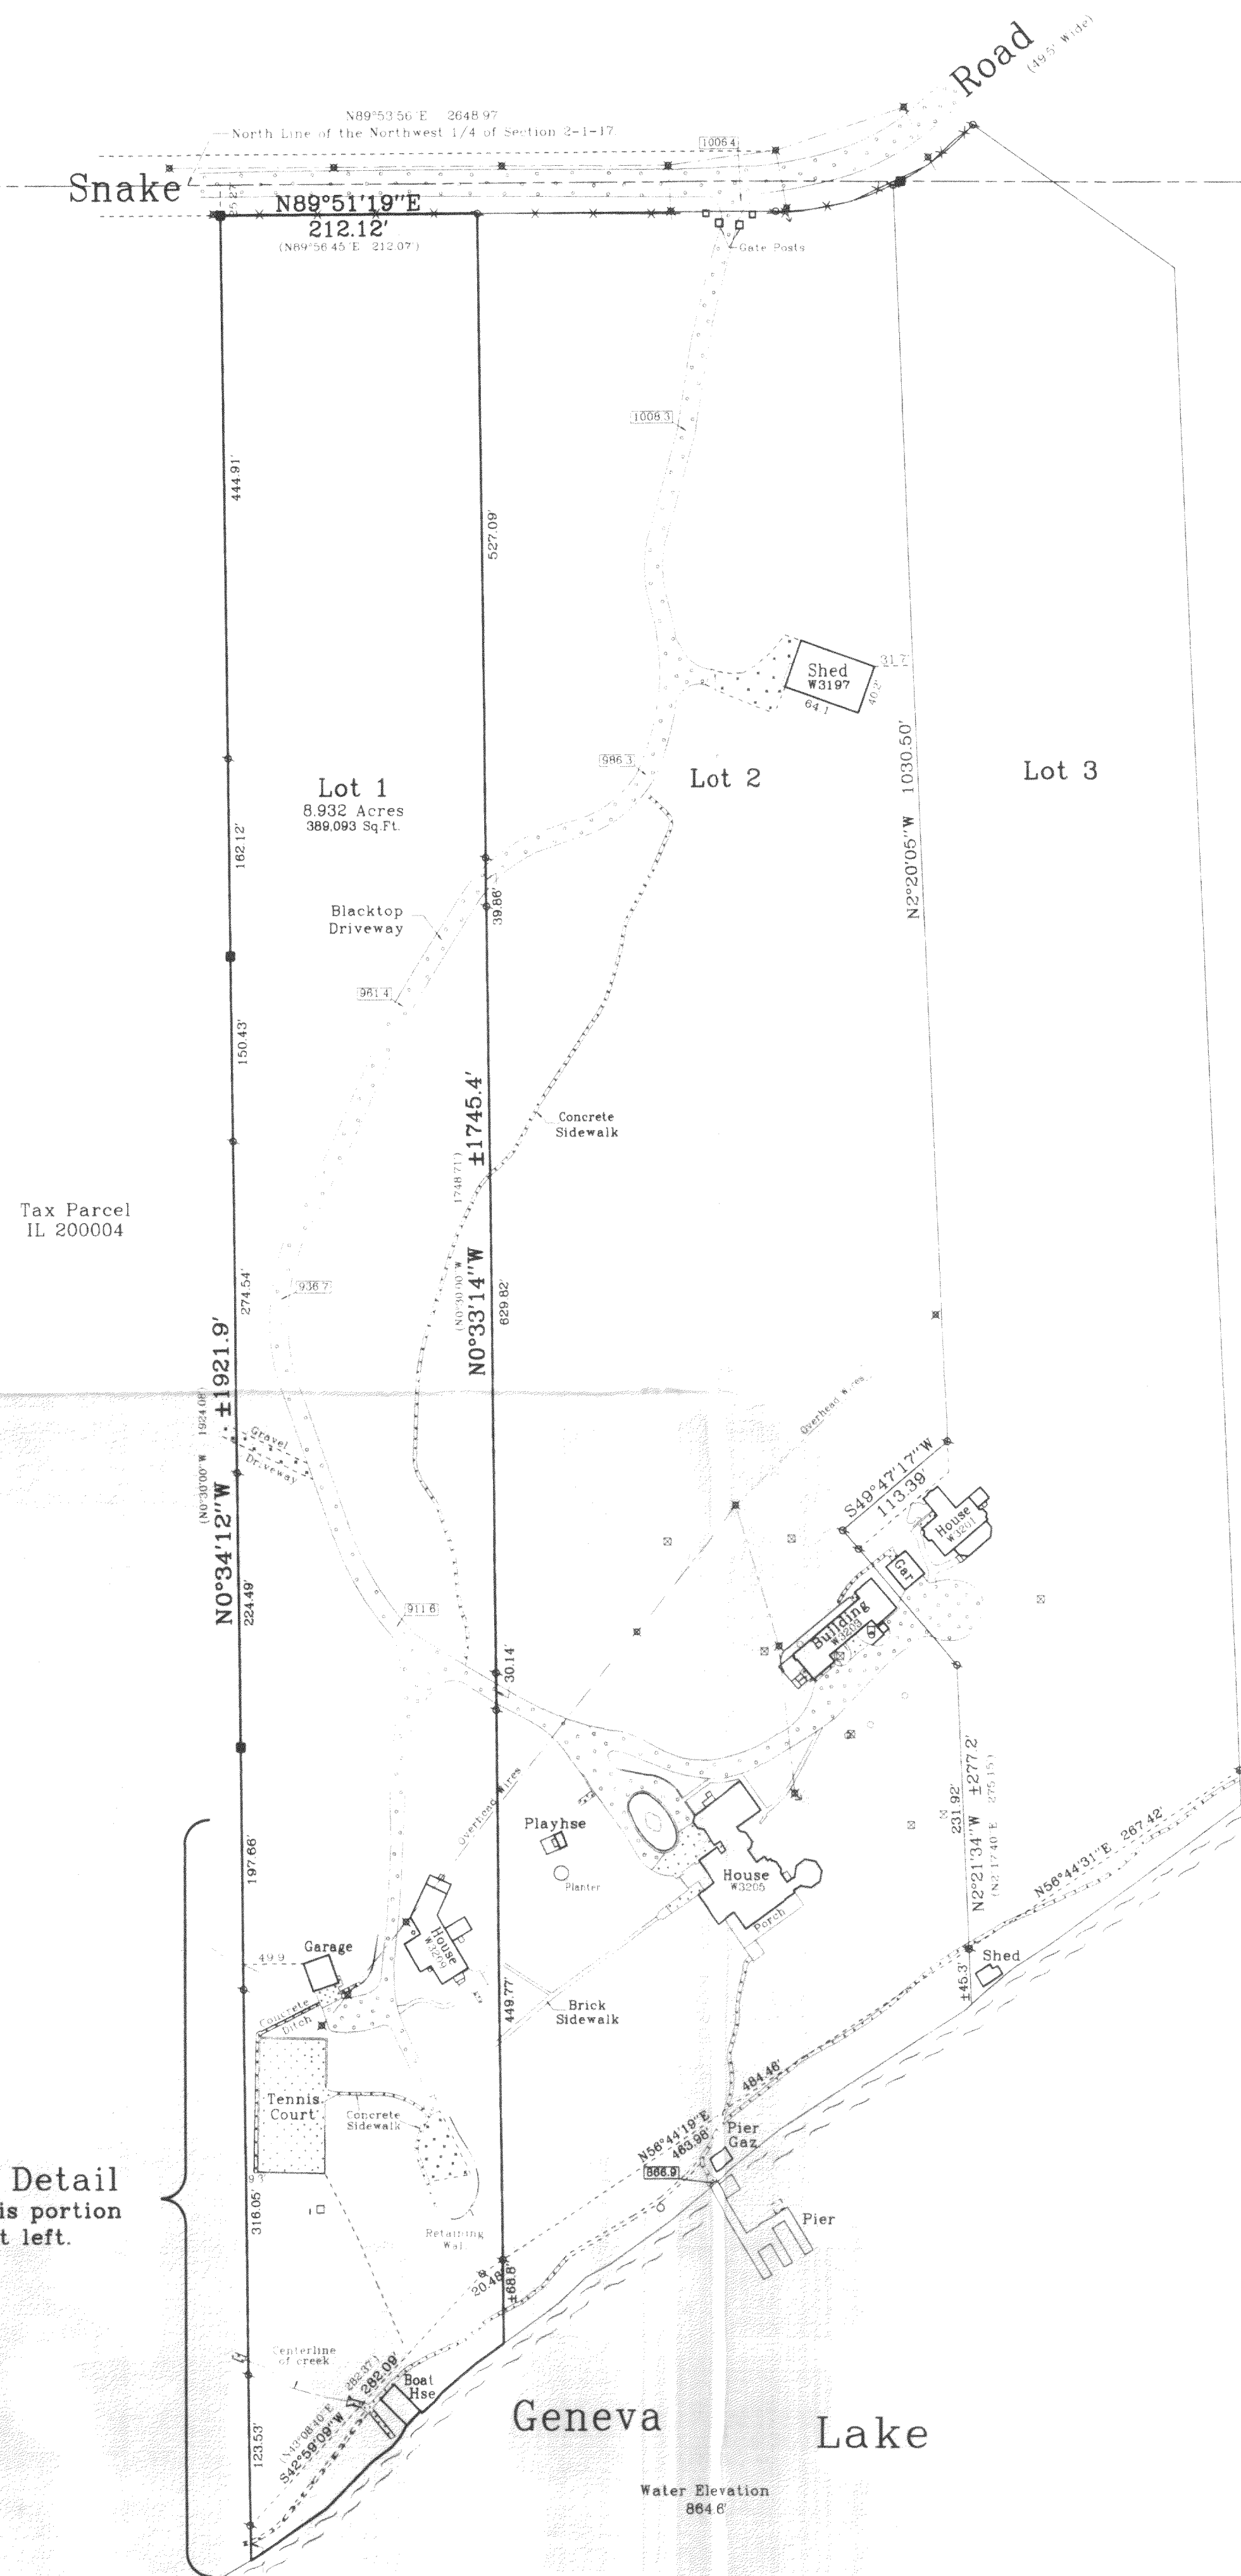

Survey date: October 17, 2001
Revisions:

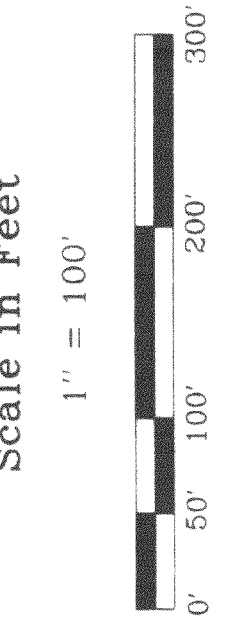

Jensen & Olson Land Surveying, LLC

45 South Wisconsin Street
P.O. Box 322
Elkhorn, Wisconsin 53121
Telephone: (262) 723-3434
Facsimile: (262) 723-8044

- Legend**
- Found Corner Section Corner
 - Found Concrete Monument
 - Found Iron Pipe Monument
 - Found Pole Monument
 - Utility Pedestal or Box
 - Concrete Cover or Manhole
 - Concrete Surface
 - Asphalt Surface
 - Brick Surface
 - Deciduous Tree
 - Coniferous Tree

Sheet 1 of 1 Sheets.

Job Reference Number
2001.126

2001.126