




IRP-22

Plat of Survey

of

A parcel of land located in Block 2 of Rowena Park, a subdivision located in the Northwest 1/4 of Section 5, Town 1 North, Range 17 East, Town of Linn, Walworth County, Wisconsin, and described in a Warranty Deed recorded in Vol. 457 on Page 731 as Document No. 178230 as shown below:
Commencing at a point on the North line of Block Numbered Two, in Rowena Park (a subdivision of part of Section Numbered Five in T1N, R17E, Walworth County, Wisconsin) at a point 1228.35 feet east of the NW corner of said Block Numbered Two; run thence South 239 feet; thence East 92.3 feet; thence North 239 feet to the North line of said Block Two; thence West 92.3 feet to the place of beginning.

Surveyed for: **Thomas C. Kienzle III & Sarah Yarger Kienzle**
995 Timber Lane
Lake Forest, Illinois. 60045

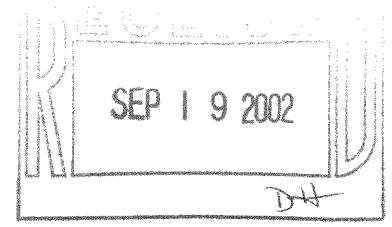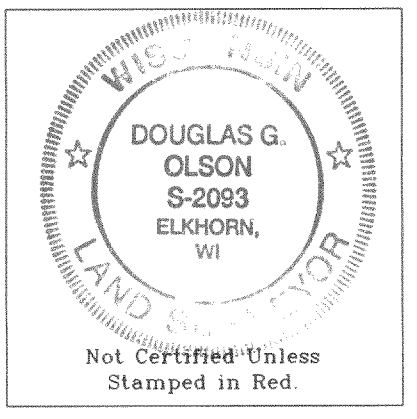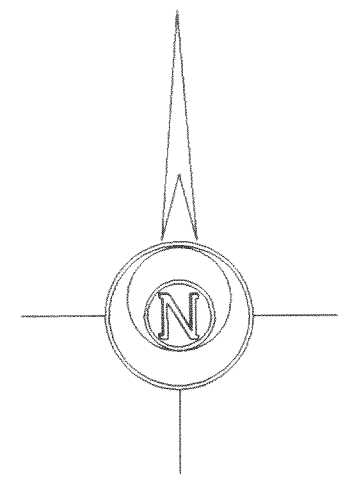

- Notes: 1) This survey plat is not certified unless signed and sealed in red ink.
- 2) This survey is subject to Wisconsin lien laws. This Plat of Survey is the notice of intent to file lien. Lien waiver required.


Copyright © 2002 by Jensen & Olson Land Surveying, LLC.

All rights reserved. No part of this survey plat may be reproduced or transmitted in any form by any means - graphic, electronic, or mechanical, including photocopying, tracing or information storage and retrieval systems - without permission in writing from Douglas G. Olson, Jensen & Olson Land Surveying, LLC.


I hereby certify that I have surveyed the above described property and the map hereon is correct to the best of my professional knowledge and belief and shows the size and location of the property, its exterior boundaries, the location and dimensions of all visible structures thereon, boundary fences, apparent easements and roadways and visible encroachments, if any.

This survey is made for the exclusive use of the present owners of property, and also those who purchase, mortgage or guarantee title thereto, within one year from the date hereof.

Douglas G. Olson
Wisconsin Registered Land Surveyor - 2093

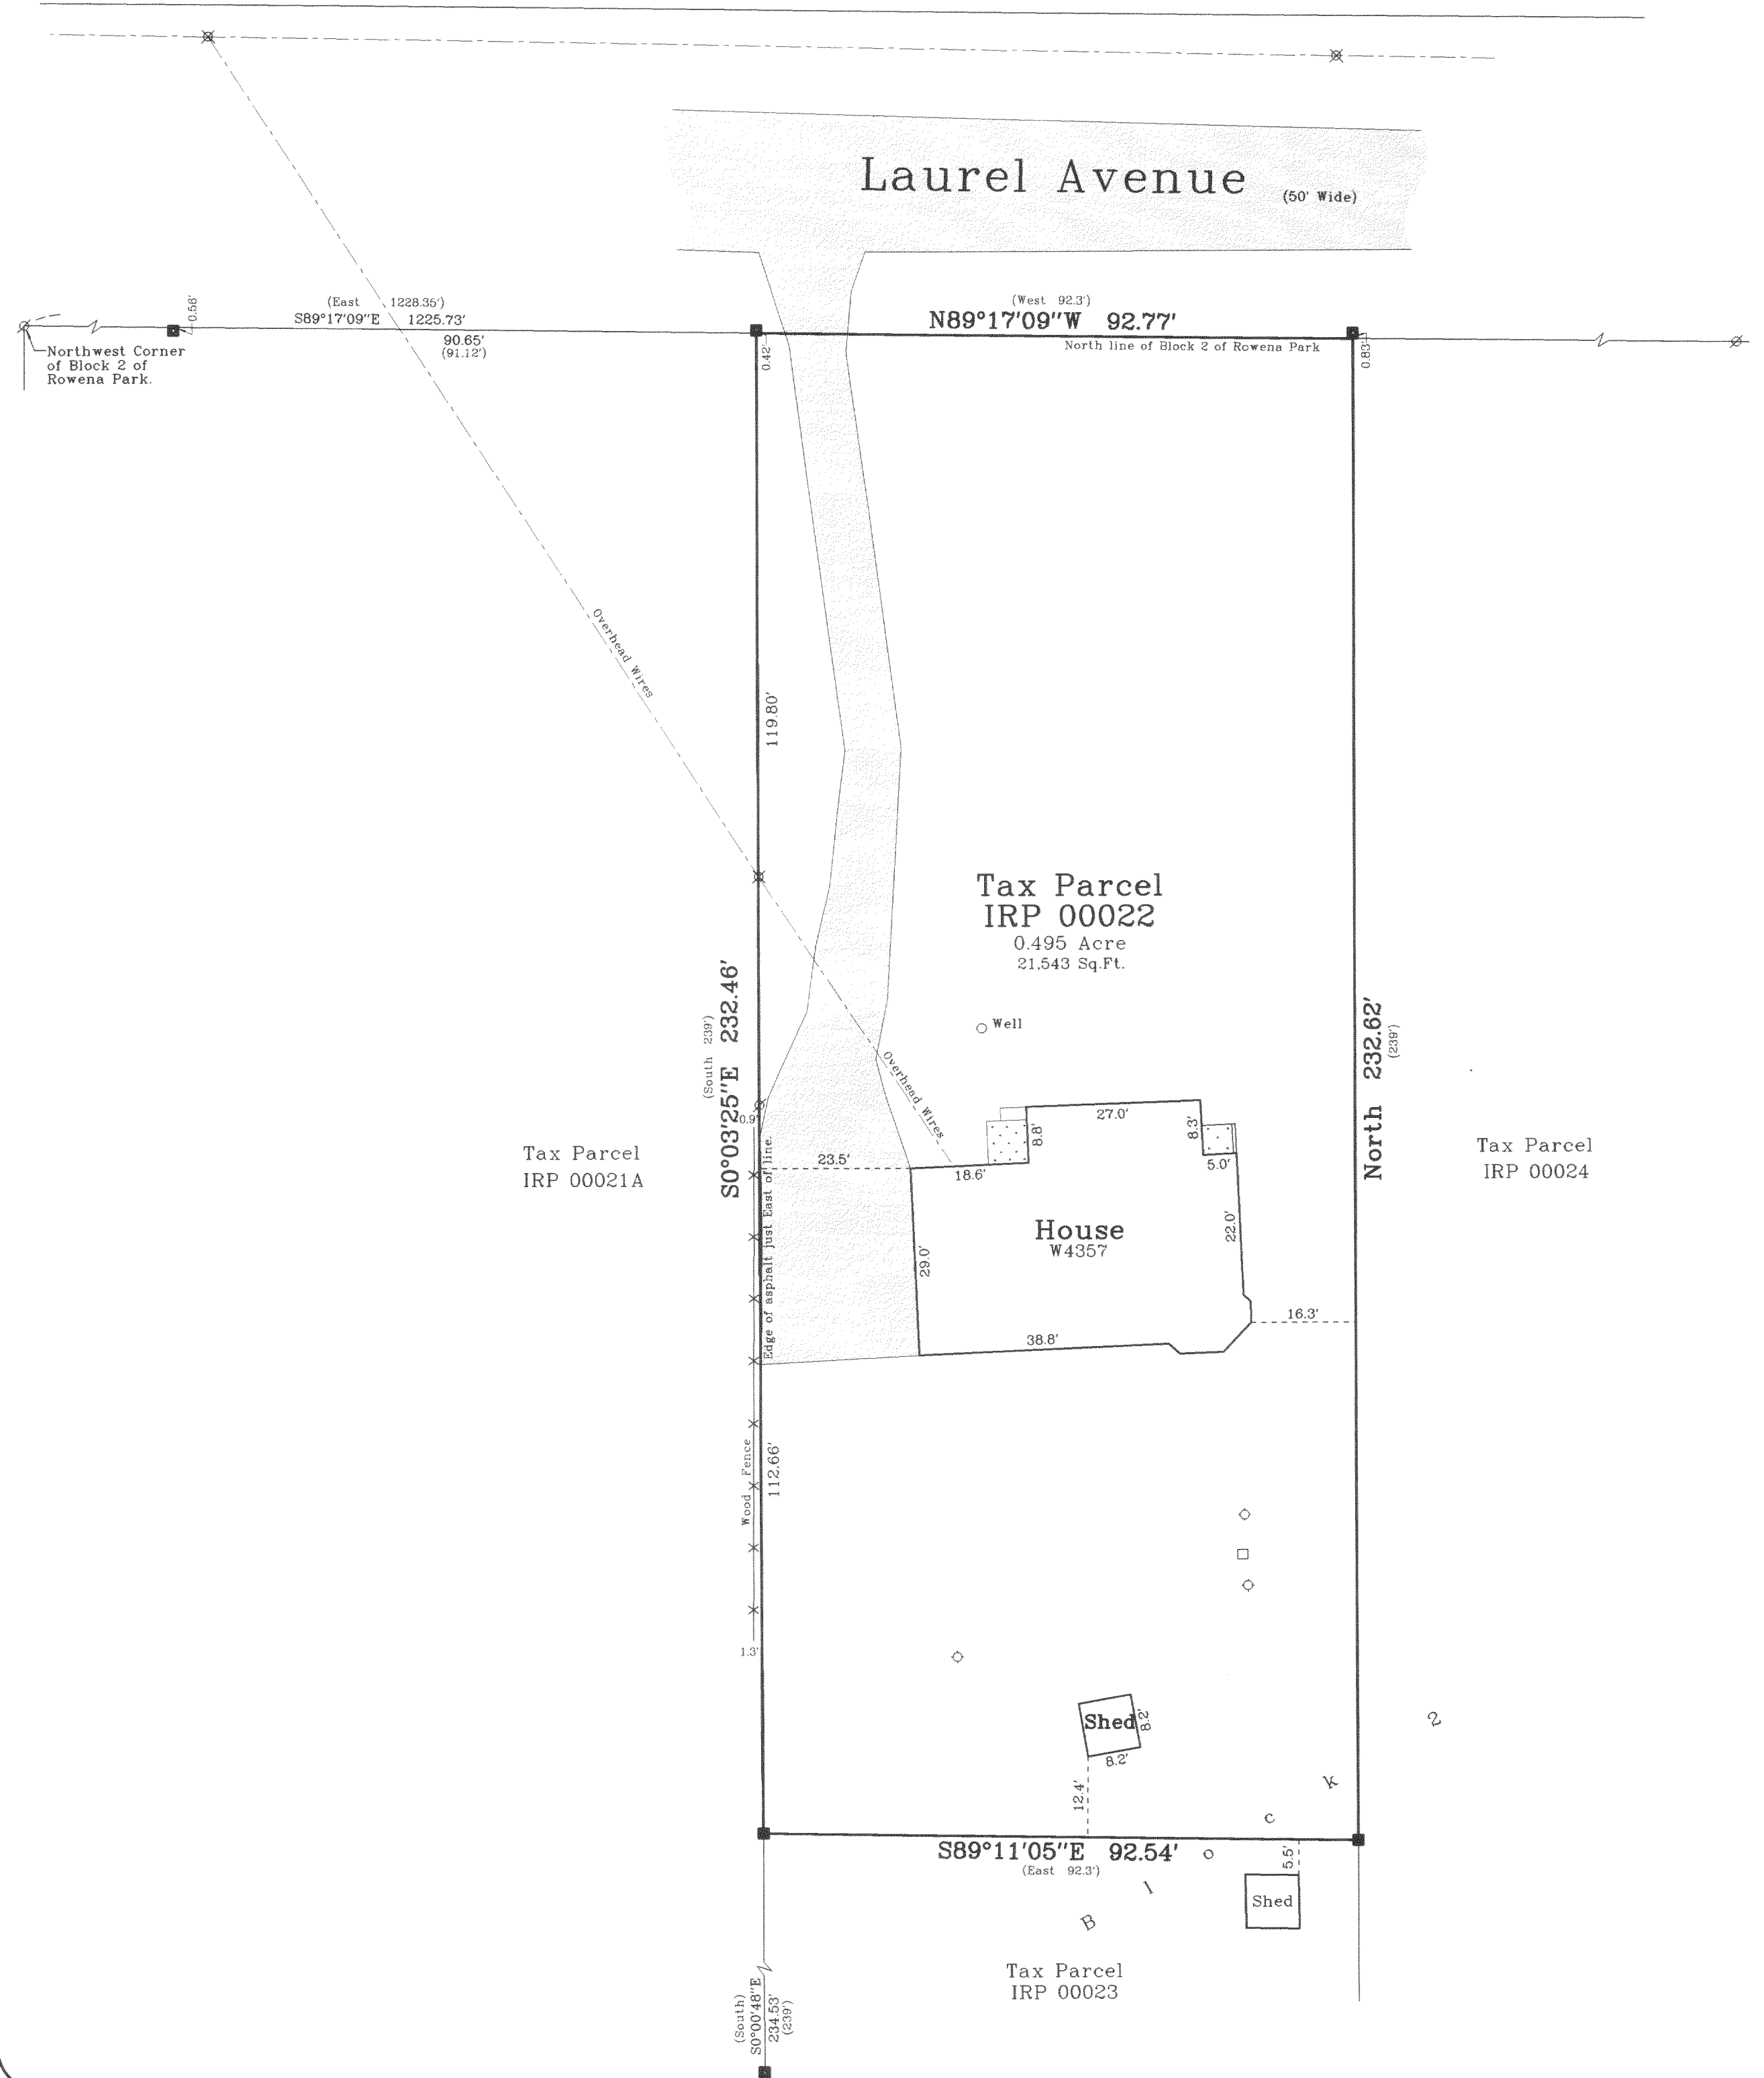

Survey Date: February 21, 2002.
Revisions:

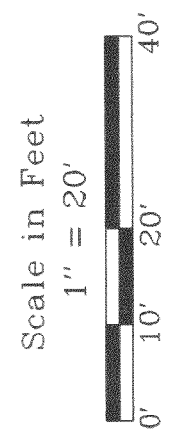

Jensen & Olson Land Surveying, LLC
45 South Wisconsin Street P.O. Box 322
Elkhorn, Wisconsin 53121
Telephone (262) 723-3434
Facsimile (262) 723-8044

- Legend
- Found Concrete Monument
 - Found Iron Pipe
 - Found Iron Rod
 - Recorded Information
 - Utility Pole
 - Concrete Cover
 - Septic Vent
 - Asphalt Surface
 - Concrete

Sheet 1 of 1 Sheets
Job Reference Number
2002.011
2002.011

117-2172