


PLAT OF SURVEY
 LOTS 60, 61, & 62
 LAKE GENEVA BEACH, A SUBDIVISION
 PART OF TOWN 1 NORTH, RANGE 17 EAST
 WALWORTH COUNTY, WISCONSIN

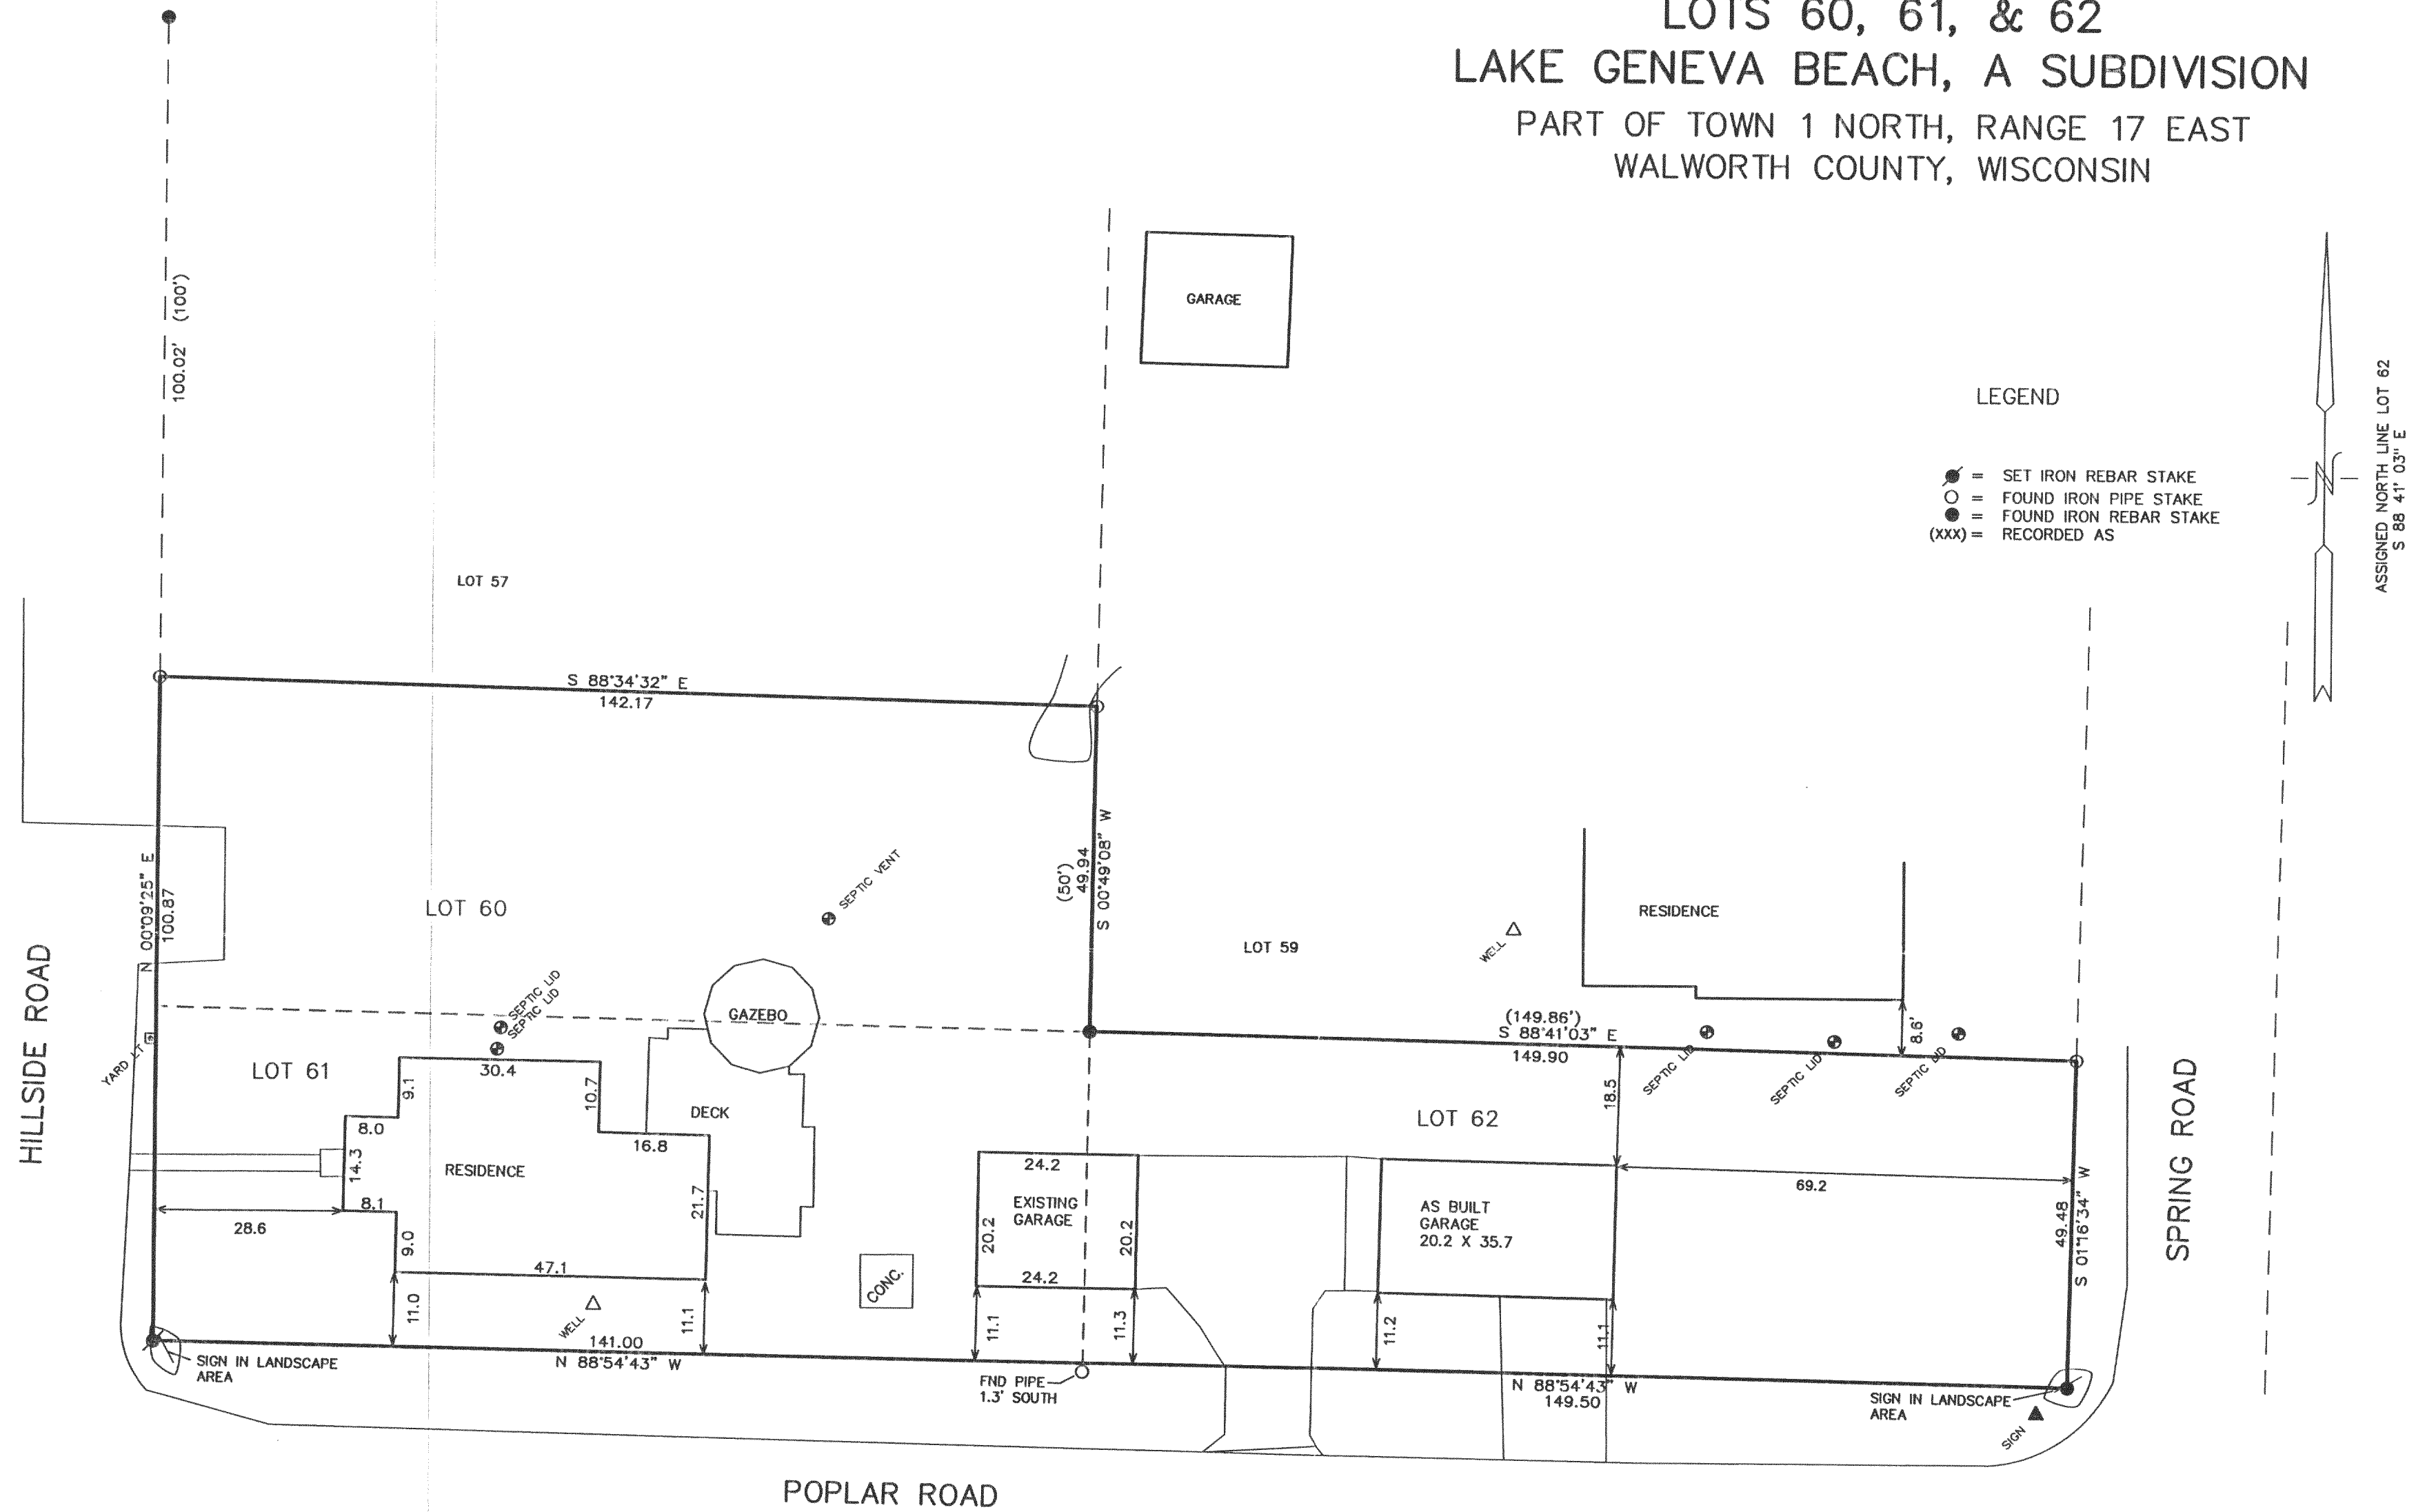


NOTE: COPIES OF THIS MAP TO WHICH THE FOLLOWING CERTIFICATE WILL APPLY SHOW SURVEYOR'S ORIGINAL SEAL AND SIGNATURE IN RED INK. COPIES BY ANY OTHER MEANS MAY HAVE ALTERATIONS WHICH DO NOT REPRESENT THE SURVEYOR'S WORK PRODUCT.

I HEREBY CERTIFY THAT THE ABOVE DESCRIBED PROPERTY HAS BEEN SURVEYED UNDER MY DIRECTION AND THAT THE ABOVE MAP IS A TRUE REPRESENTATION THEREOF AND SHOWS THE SIZE AND LOCATION OF THE PROPERTY AND ITS EXTERIOR BOUNDARIES. THIS SURVEY IS MADE FOR THE USE OF THE PRESENT OWNERS OF THE PROPERTY, AND ALSO THOSE WHO PURCHASE, MORTGAGE, OR GUARANTEE THE TITLE THERETO WITHIN ONE YEAR FROM THE DATE HEREOF.

DATED: 02-27-2002

PETER S. GORDON R.L.S. 2101

REVISED 10-09-2002
 TO SHOW SIZE & LOCATION
 OF GARAGE AS BUILT

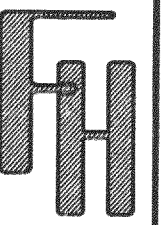


WORK ORDERED BY:
 KEN PATT
 510 SOUTH VINE
 PARK RIDGE, IL. 60068

FARRIS, HANSEN & ASSOCIATES, INC.
 Engineering, Architecture, Surveying
 7 Ridgway Court P.O. Box 437
 ELKHORN, WISCONSIN 53121
 Office: (262) 723-2098
 Fax: (262) 723-5886

REVISIONS

PROJECT NO.
 5991
 DATE:
 02-26-02
 SHEET NO.
 1 OF 1

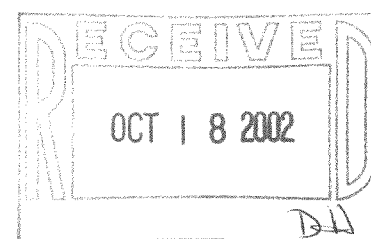

RGB-54
 RGB-55

117-2184