
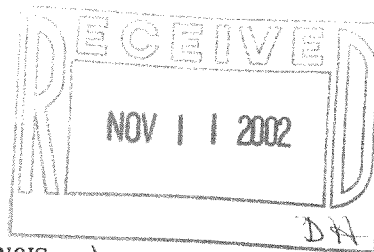
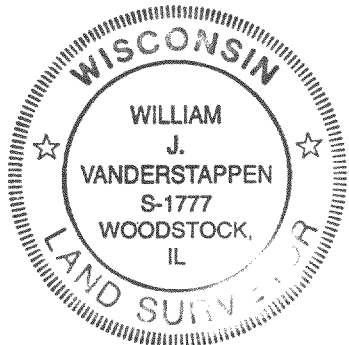


VANDERSTAPPEN SURVEYING, INC.
217 W. Judd Street
Woodstock, Illinois 60098
(815) 337-8310

PLAT OF SURVEY

Lots 11 and 13 in Shorehaven Subdivision, being a
Subdivision of part of Section 18, Township 1 North, Range
17 East, in Linn Township, Walworth County, Wisconsin.

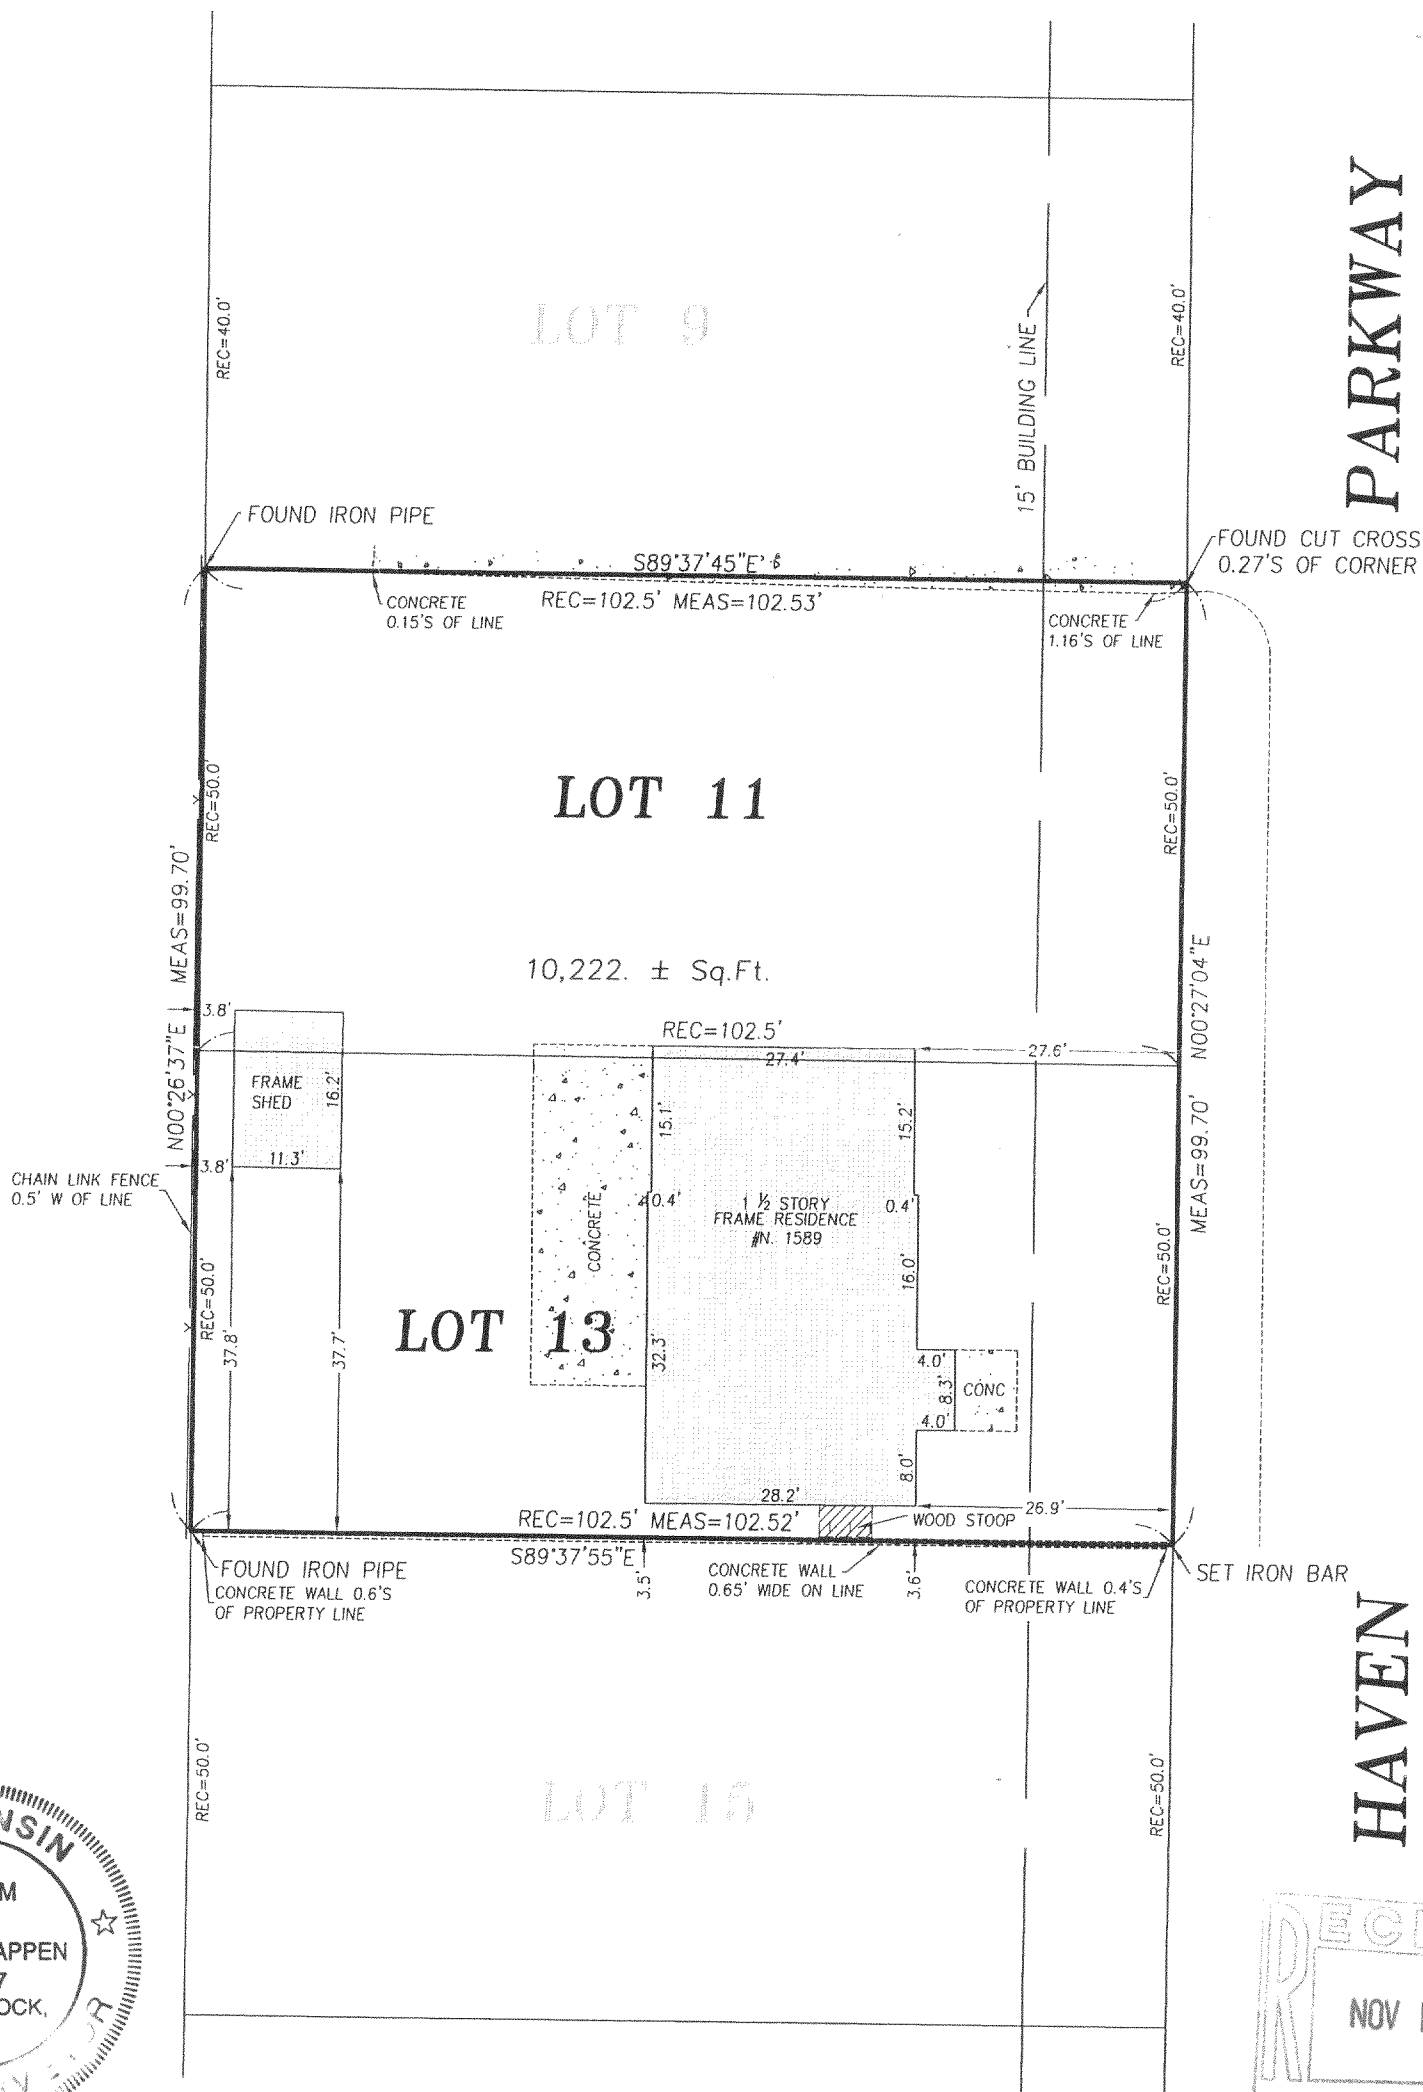

NOTE: Only those Building Line Restrictions or Easements shown on a Recorded Subdivision Plat are shown hereon unless the description ordered to be surveyed contains a proper description of the required building lines or easements.

- * No distance should be assumed by scaling.
- * No underground improvements have been located unless shown and noted.
- * No representation as to ownership, use, or possession should be hereon implied.
- * This Survey and Plat of Survey are void without original embossed or colored seal and signature affixed.

Compare your description and site markings with this plat and AT ONCE report any discrepancies which you may find.

STATE OF ILLINOIS)
COUNTY OF McHENRY) S.S.

I hereby certify that we have surveyed the premises above described, and that the plat hereon is a true representation of said survey.

Dated at Woodstock,
McHenry County, Illinois 12/15 ,A.D., 2000.

VANDERSTAPPEN SURVEYING, INC.

By: William J. Vanderstappen
Wisconsin Professional Land Surveyor
No. 1777-008

CLIENT: DAVID NUTT

DRAWN BY: APG CHK'ED BY: WJV
SCALE: 1"=20' SEC. 18 T. 1 R. 17 E.

P.I.N.: LINN TOWNSHIP, WI

JOB NO.: 001060 I.D. LSS BK. 26 PG. 73

ALL DISTANCES SHOWN IN FEET AND DECIMAL PARTS THEREOF
CORRECTED TO 68° F.

ISA-12

117-2190