


PLAT OF SURVEY

Lots 1 and 2 in Shorehaven Subdivision, being a Subdivision of part of Section 18, Township 1 North, Range 17 East, in Linn Township, Walworth County, Wisconsin

GENEVA

LAKE

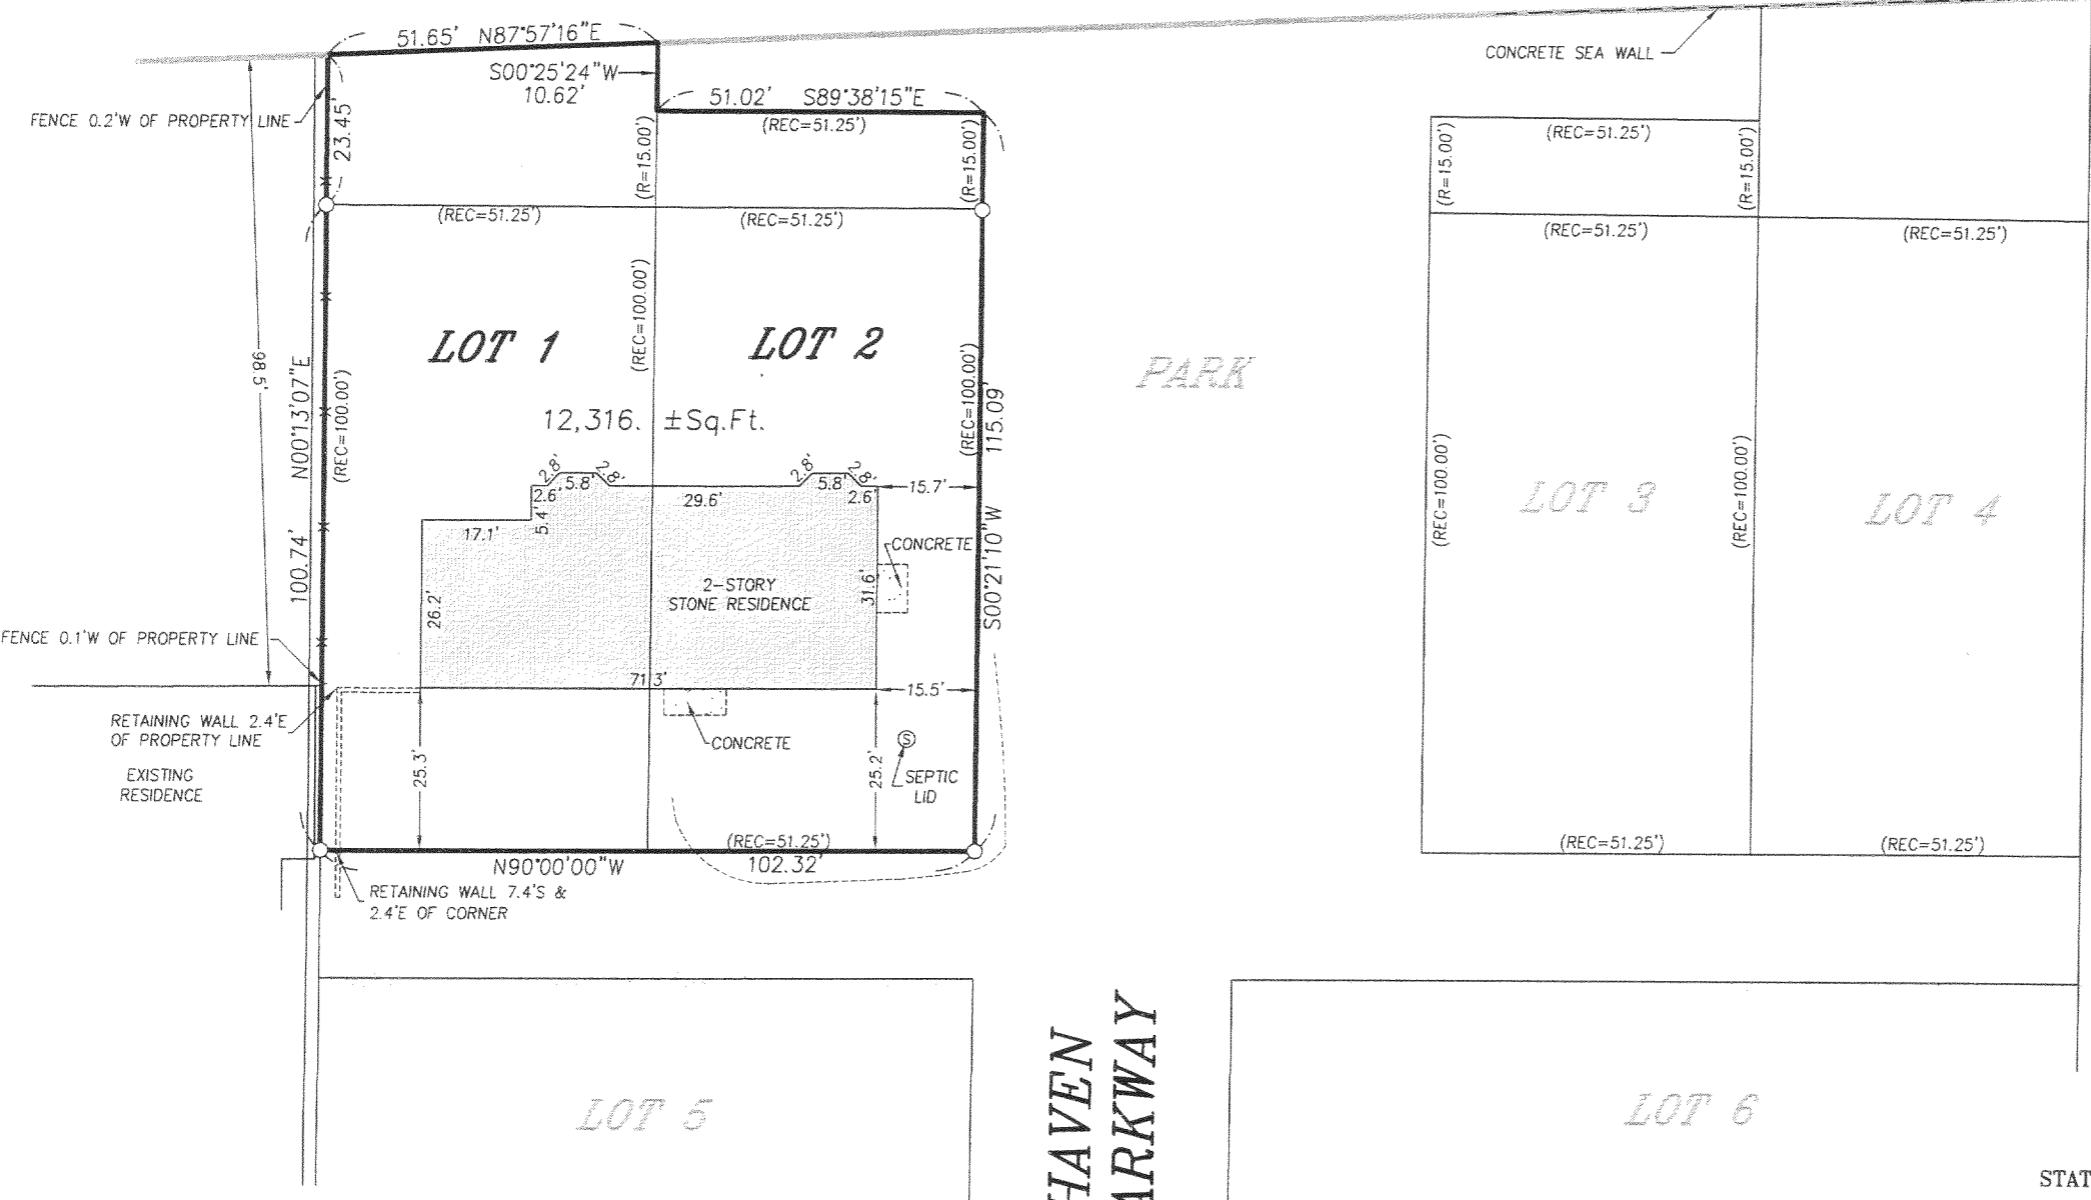

LEGEND

● FOUND IRON BAR	○ SET IRON BAR
○ FOUND SPIKE	○ SET SPIKE
○ FOUND IRON PIPE	



CLIENT: SOUTHAMPTON HOMES

DRAWN BY: CPM CHK'ED BY: WJV
SCALE: 1"=30' SEC. 18 T. 1 R. 17 E.
P.I.N.: LINN TWP. WALWORTH CO.
JOB NO.: 010351 I.D. UPD BK. PG.
ALL DISTANCES SHOWN IN FEET AND DECIMAL PARTS THEREOF
CORRECTED TO 68° F.
REF 000742