


PLAT OF SURVEY

LOT 1 OF CERTIFIED SURVEY MAP NO. 1673
& OUTLOT 1 OF LORAMOOOR
A PART OF LORAMOOOR, LOCATED IN THE SE 1/4 OF SEC. 11
TOWN 1 NORTH, RANGE 17 EAST, WALWORTH COUNTY, WISCONSIN

RECORD COPY CSM 1673
SHOWING 10' WALKWAY EASEMENT "G"

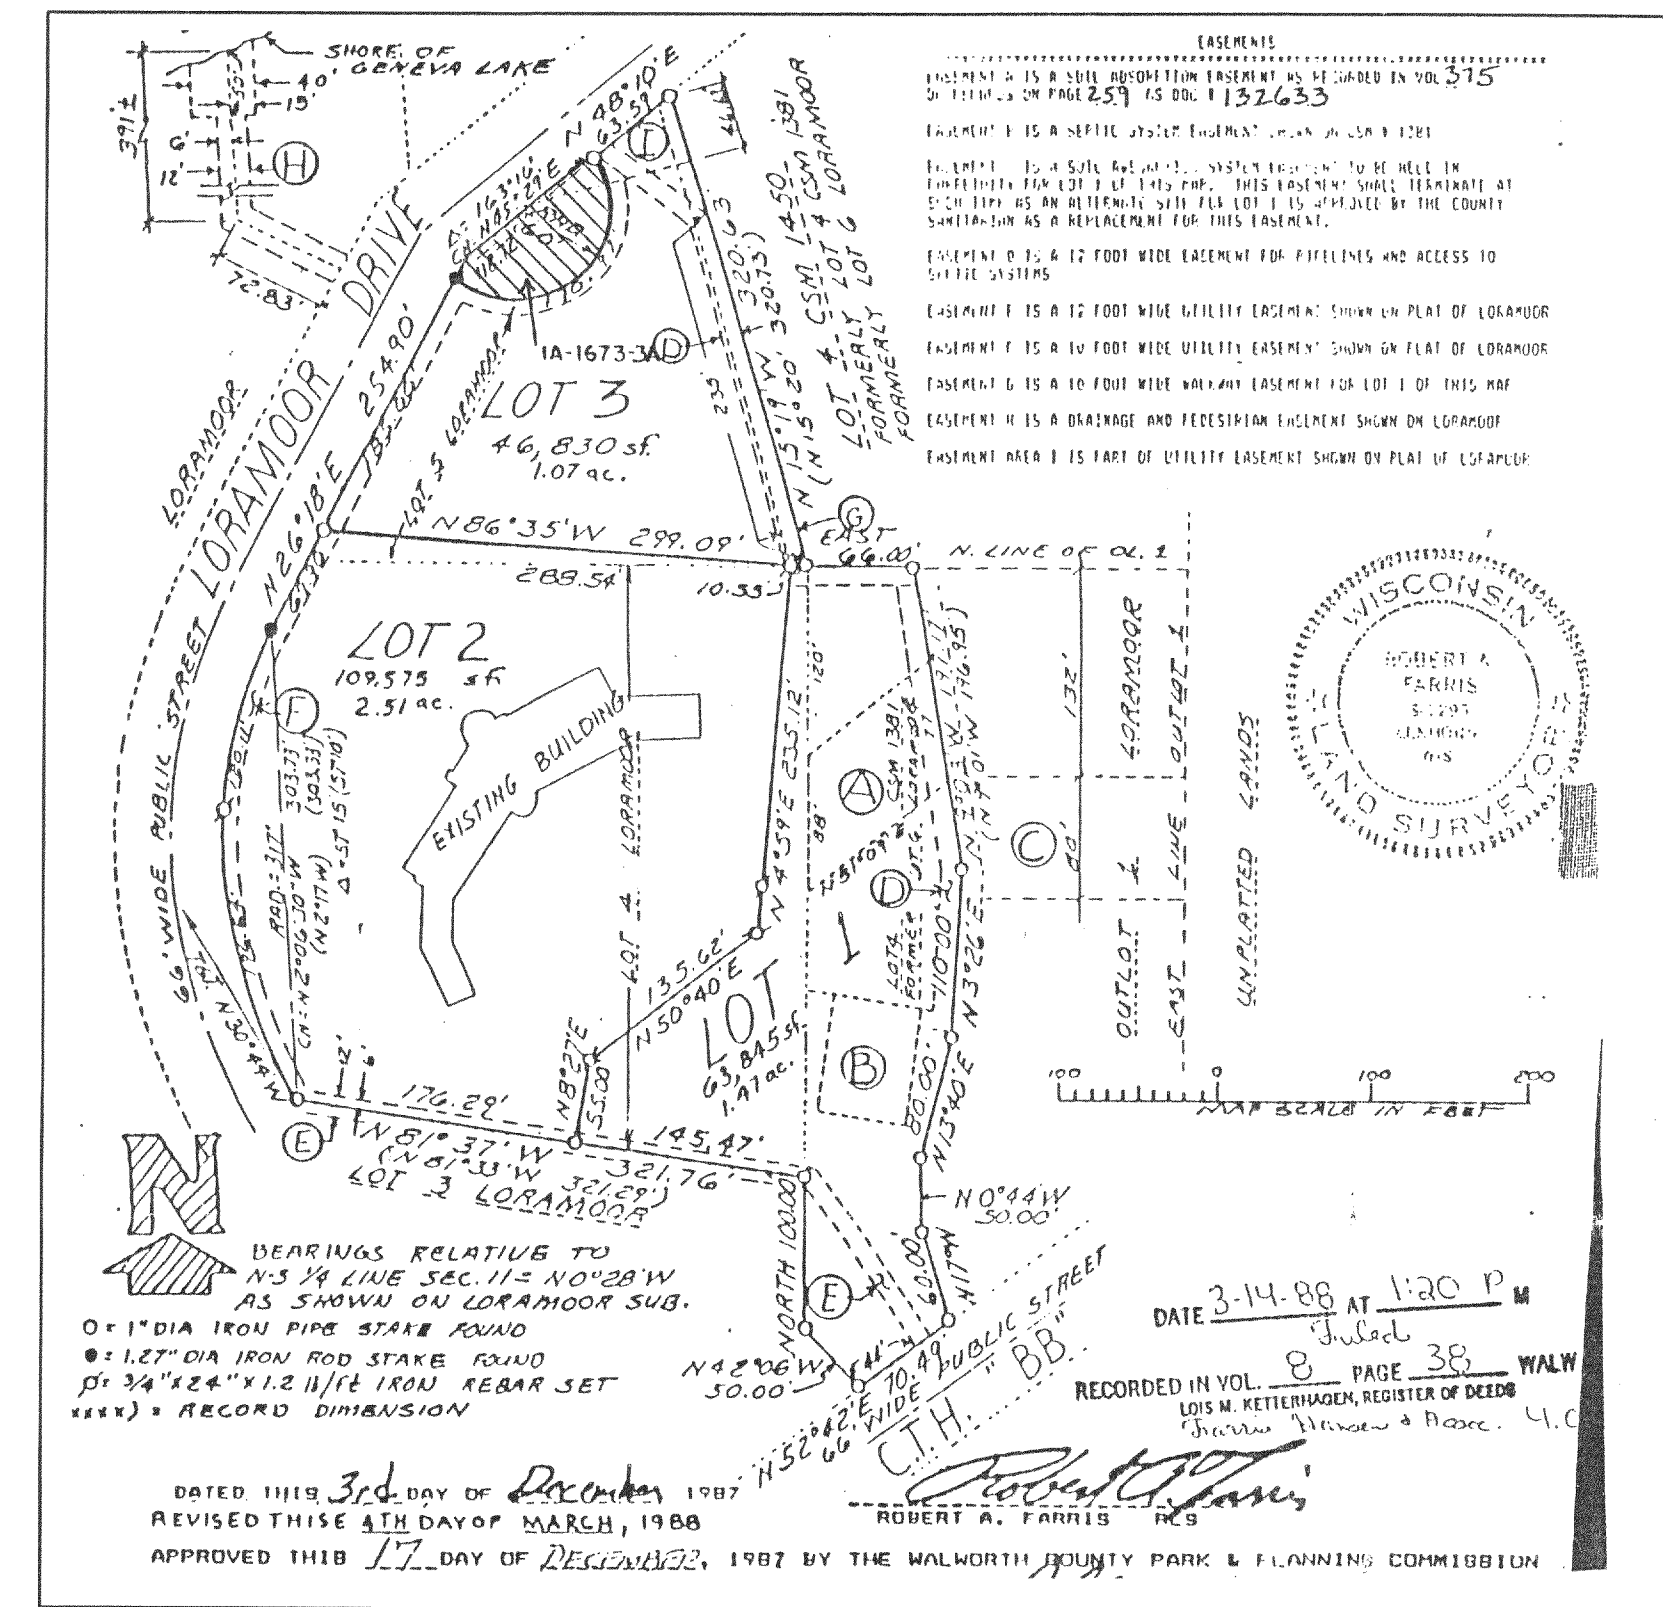


2002 WORK ORDERED BY:
DAVE LABOFF
803 W. MAIN STREET
LAKE GENEVA, WI.

WORK ORDERED BY: BOB RAULAND FOR
WALWORTH STATE BANK
WALWORTH, WISCONSIN

FARRIS, HANSEN & ASSOCIATES, INC.
Engineering, Architecture, Surveying
7 Ridgeway Court, P.O. Box 437
ELKHORN, WISCONSIN 53121
Office: (414) 723-2098
Fax: (414) 723-5886


REVISIONS
01-10-97
ADD INFO RE. SEPTIC VENTS

PROJECT NO.
1813.96
DATE
11-19-1996
SHEET NO.
1 OF 1

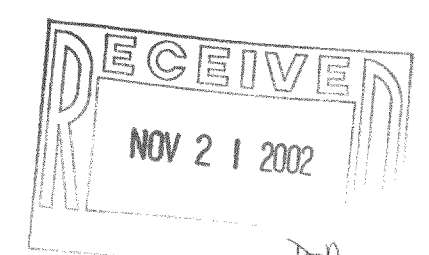

1711673-1
ICWC-13

117-2196

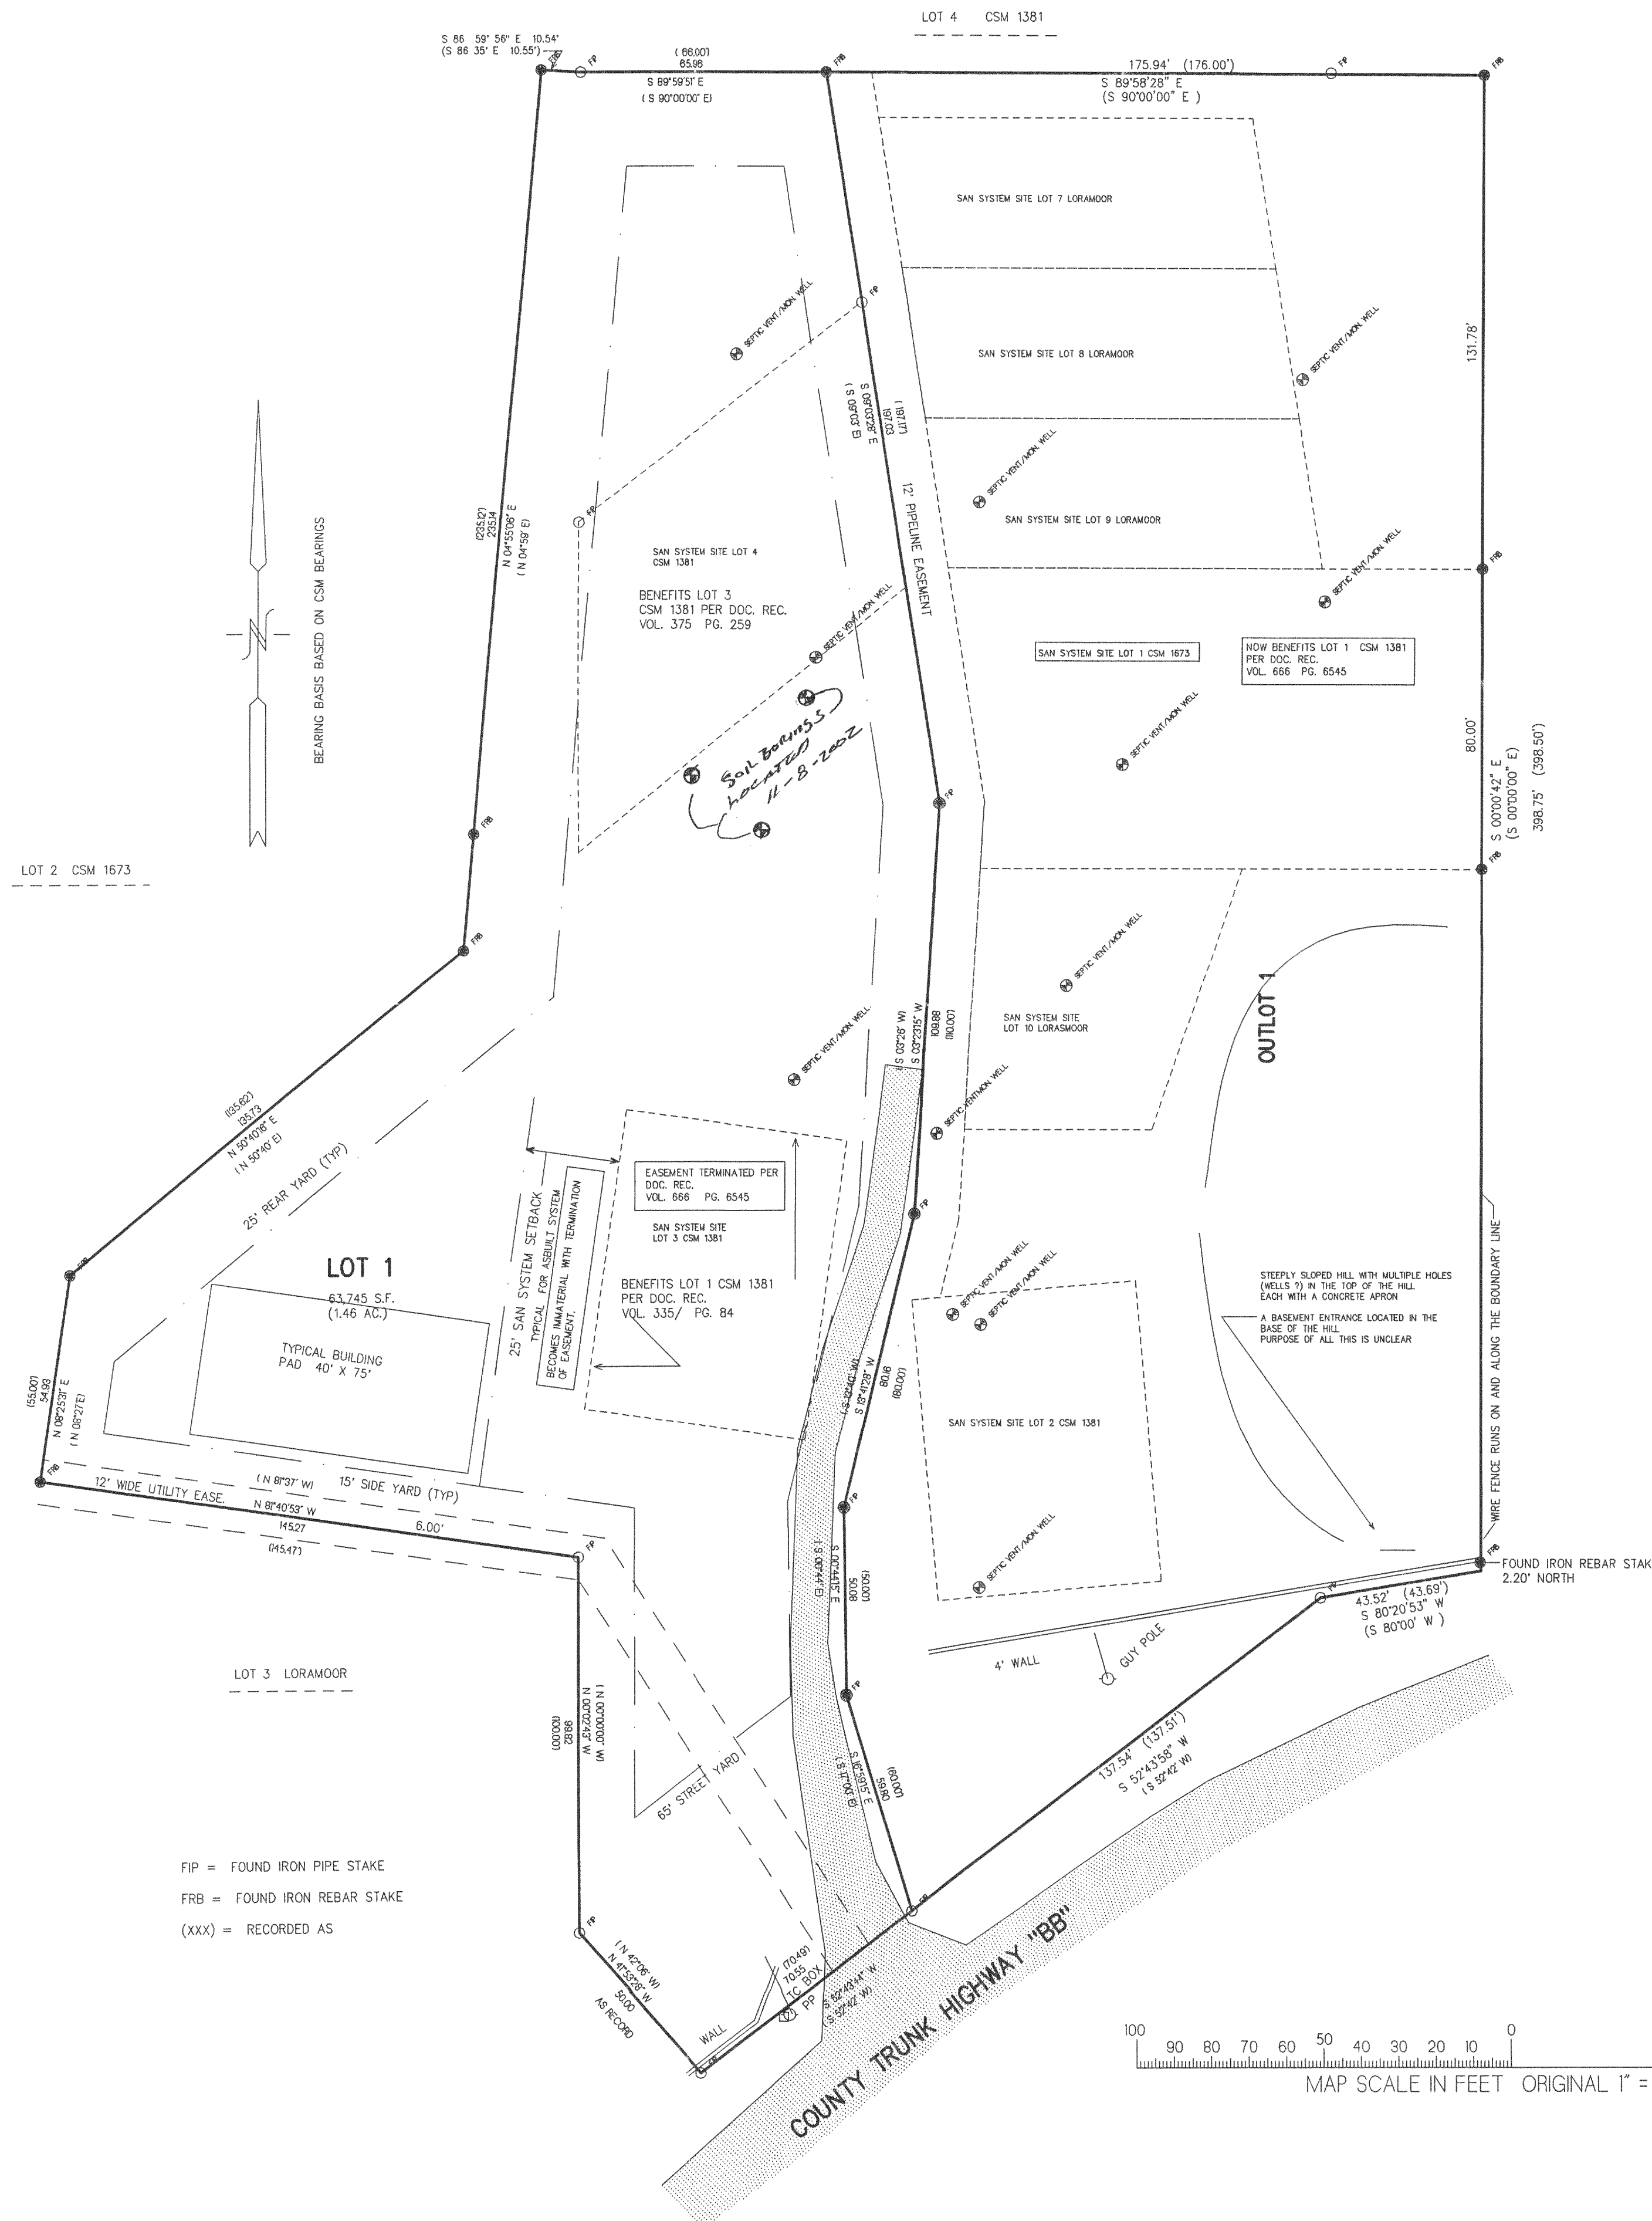

NOTE: COPIES OF THIS MAP TO WHICH THE FOLLOWING CERTIFICATE WILL APPLY SHOW SURVEYOR'S ORIGINAL SEAL AND SIGNATURE IN RED INK. COPIES BY ANY OTHER MEANS MAY HAVE ALTERATIONS WHICH DO NOT REPRESENT THE SURVEYOR'S WORK PRODUCT.

I HEREBY CERTIFY THAT THE ABOVE DESCRIBED PROPERTY HAS BEEN SURVEYED UNDER MY DIRECTION AND THAT THE ABOVE MAP IS A TRUE REPRESENTATION THEREOF AND SHOWS THE SIZE AND LOCATION OF THE PROPERTY, ITS EXTERIOR BOUNDARIES, THE LOCATION OF ALL VISIBLE STRUCTURES, AND DIMENSIONS OF ALL PRINCIPLE BUILDINGS THEREON, BOUNDARY FENCES, APPARENT EASEMENTS, ROADWAYS, AND VISIBLE ENCROACHMENTS, IF ANY. THIS SURVEY IS MADE FOR THE USE OF THE PRESENT OWNERS OF THE PROPERTY, AND ALSO THOSE WHO PURCHASE, MORTGAGE, OR GUARANTEE THE TITLE THERETO WITHIN ONE YEAR FROM THE DATE HEREOF.

DATED: 12/3/99
PETER S. GORDON R.L.S. 2101
REVISED + RE-CERTIFIED
11-11-2002

MAP SCALE IN FEET ORIGINAL 1" = 30'