


OF
SURVEY
OF

Lot 134 Lake Geneva Beach Sub'd.
Linn Town. Walworth County Wis.
for
Mr. Chas. Szabo.

42-4

SPRING

ROAD.

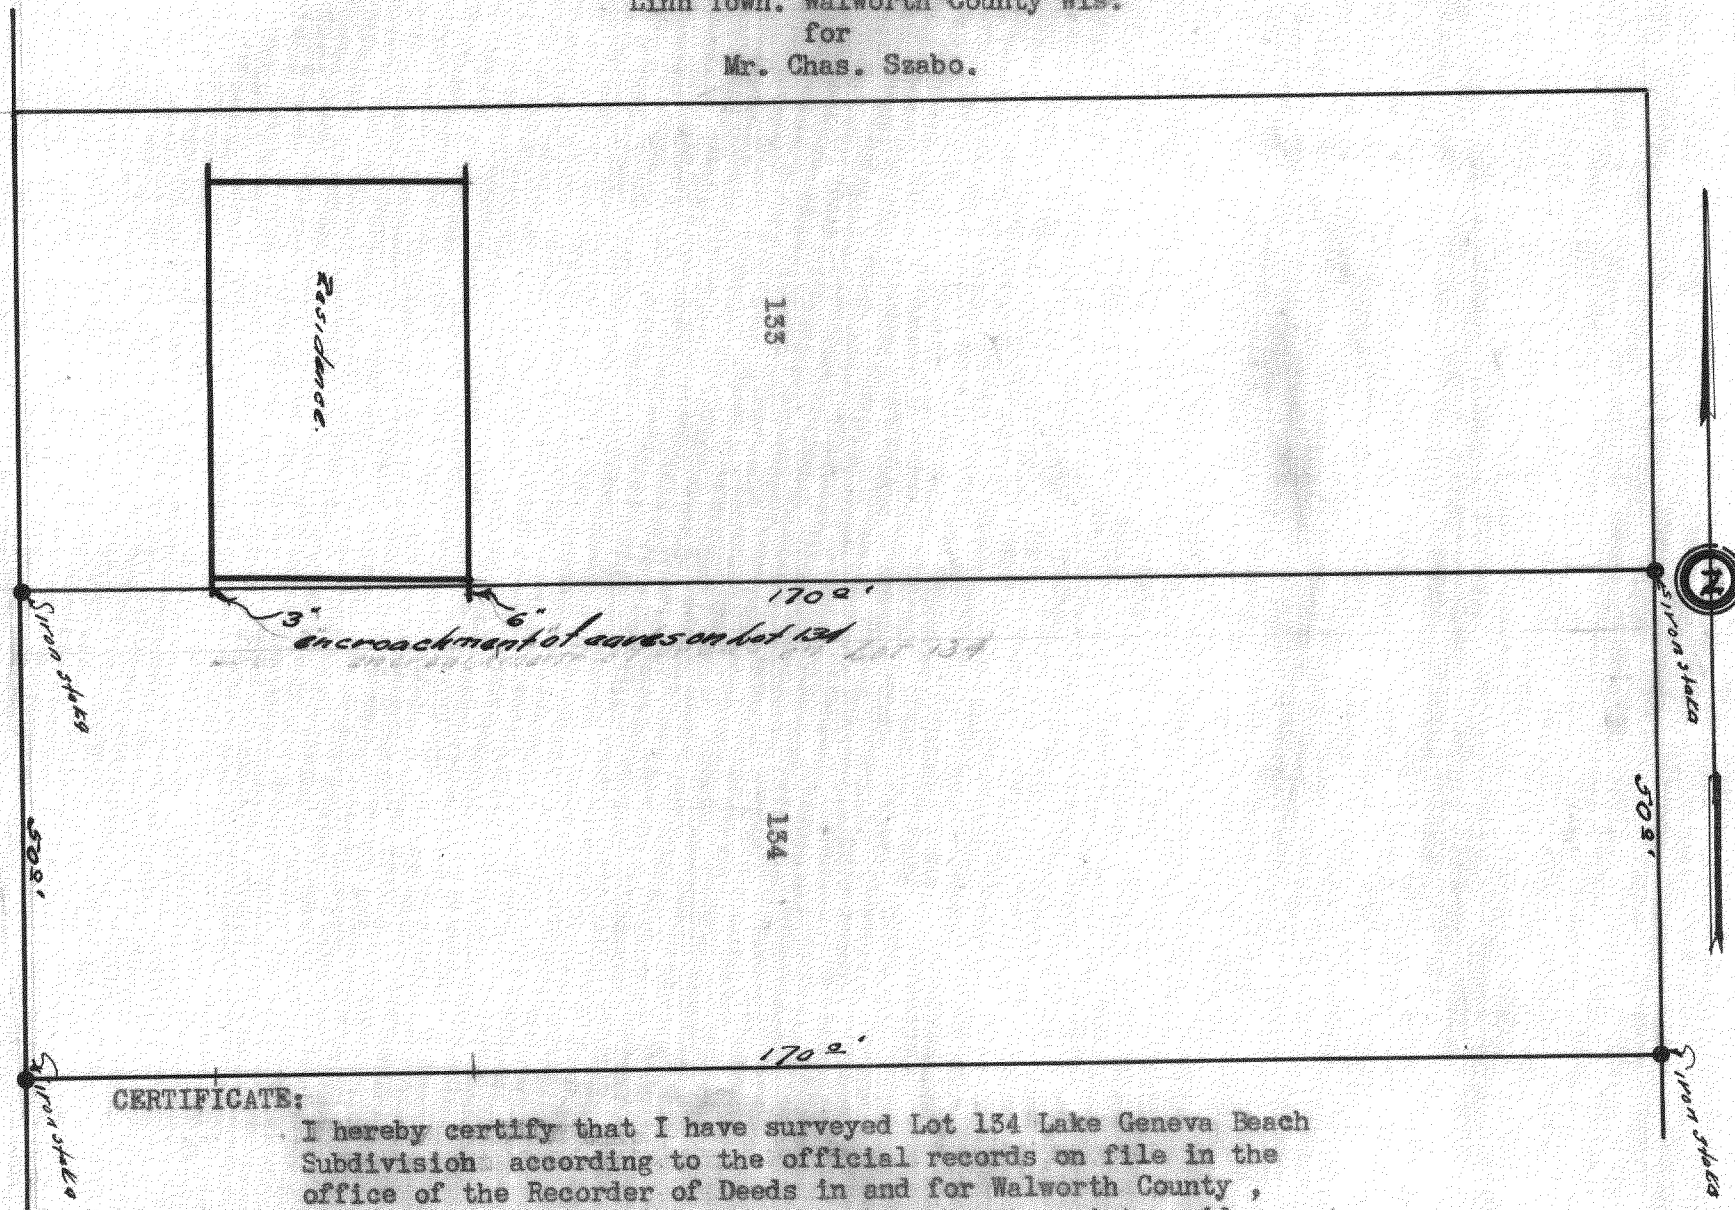

CERTIFICATE:

I hereby certify that I have surveyed Lot 134 Lake Geneva Beach Subdivision according to the official records on file in the office of the Recorder of Deeds in and for Walworth County, Wisconsin, and find that certain encroachments exist, said encroachments are in the form of an extension of the front or west eave on to said lot 134 by three inches, and the extension of the rear or east eave on to said lot 134 by six inches.

Signed this 9th day of day of November 1942.

Joseph W. Biagi

117-21 B

42-4