
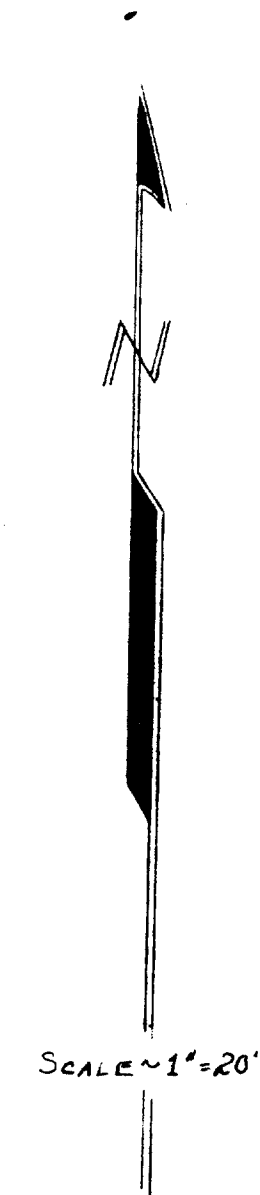


PLAT SHOWING THE LOCATION OF THE BUILDING ON LOT 2
 BLOCK 1 OF THE WOODDALE ADDITION TO THE TOWN
 OF LINN.
 JULY 27, 1959

George A. Dunham
 GEORGE A. DUNHAM, SURVEYOR
 DELAWARE, WISCONSIN

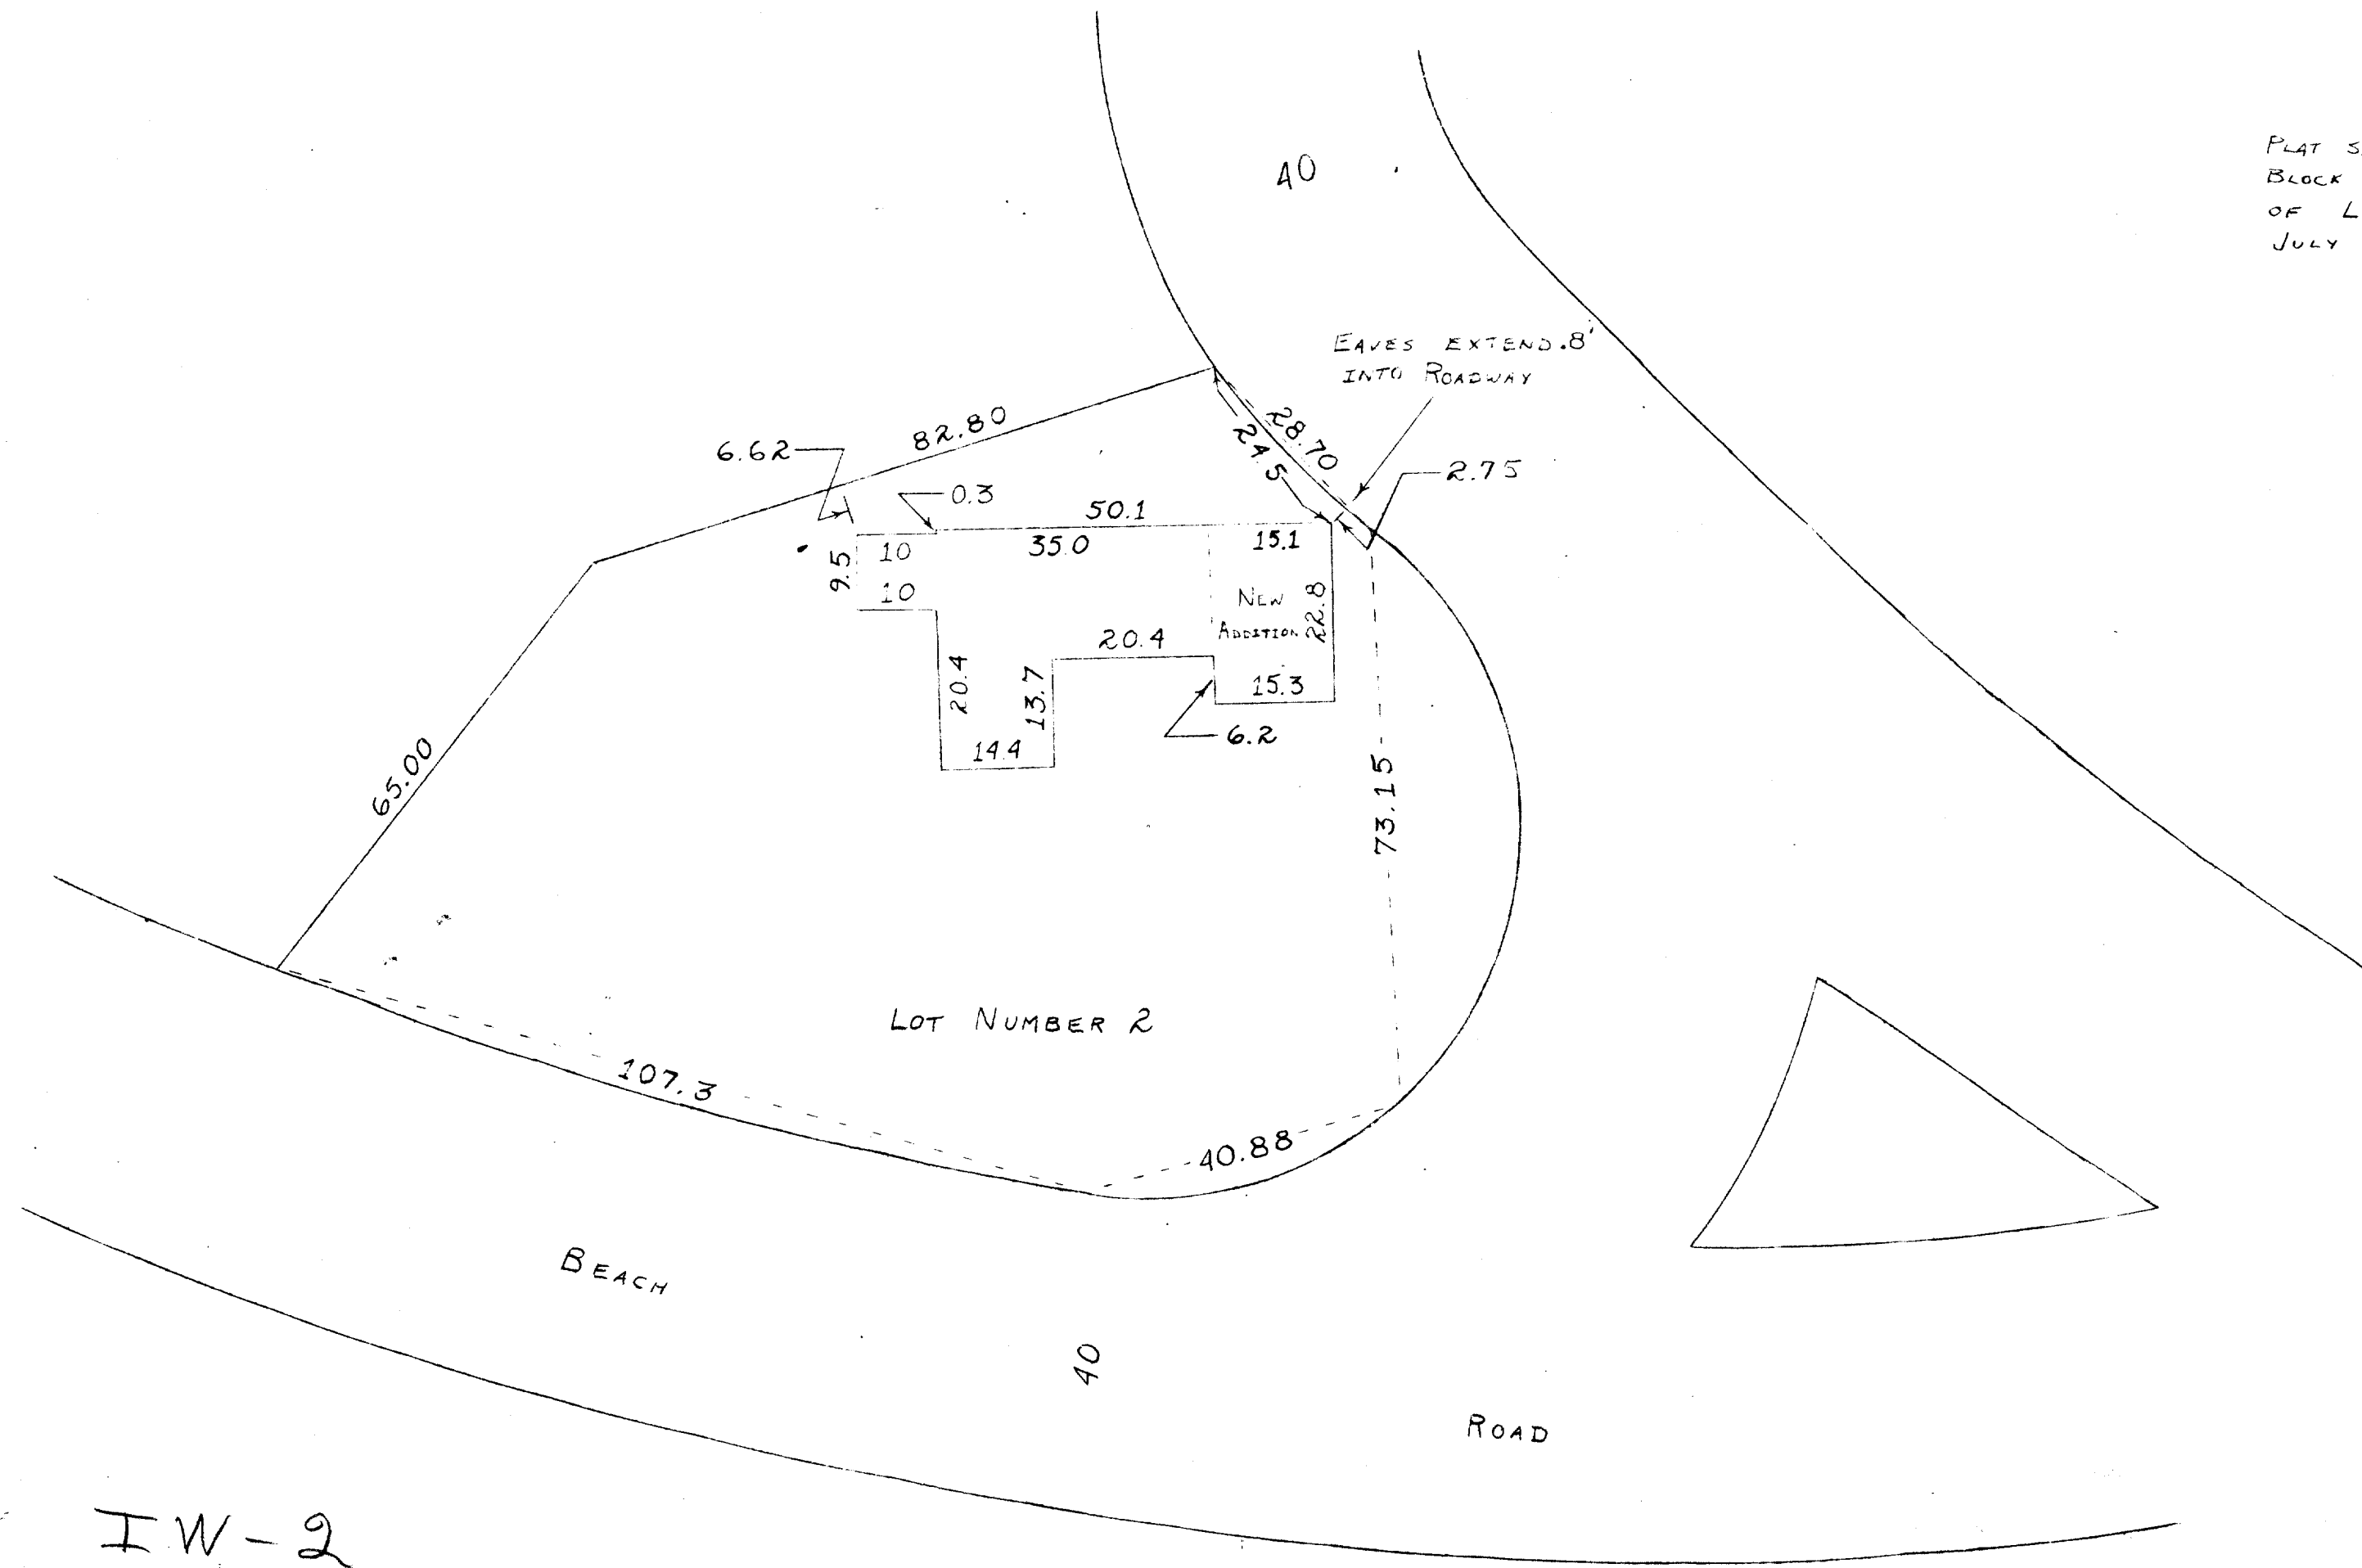

I W - 2

117-22