

82


Oct. 3/31 Survey Lot
located in the N.W.
Town of Lincoln, Wis.

original
Found stks on central
sub then line E & W,
13, 14, 15, 16, 17, & 18, and
in tie. This line divides
and from this N. & S.
50' apart to E line
Set concrete Mons. at
149' N on west line of
at 7, set iron stks on
con. Mon. Building
Park Drive and 120'
Found iron stks at
N.W. Cors 13, 14, 16, 17,
and none at N.W. Cor.
at S.W. Cors, 12, 10.
From these made survey
lot fronts off Park Drive
These lots are 56'

Lot 7 Lake Geneva Beach

M. Lake Geneva Beach #16,
1/4 sect 11 T1N, R17E
for Miss Stella Krimling
2140 W. Lexington St. Chicago,
line W 1/3, Lake Geneva Beach
Separating Lots 18 & 20 from
from those located 1st line
9 from 10,
S line run parallel lines
& W. line Lot 7,
S.W. & S.E. Cors of 7,
7 and 136' N. on E line
E line 7, 150' N. of S.E.
line is 20' N. of N. line
N of N. line Park Drive
S.W. Cors, Lots 13, 14, 15
at S.W. Cors, 12, 10, 9, &
18, also found iron stks
9, & 8 and no others.

are 54, 6' ft. or prec. 54, 7'
wide at rt angles

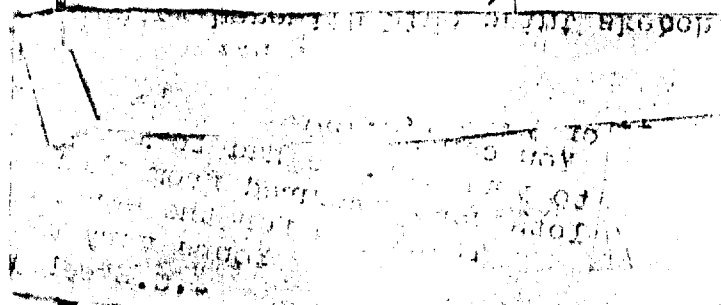

117-221 Sh