

ABERNATHY and ASSOCIATES


Kenneth B. Abernathy Jr.

Wisconsin Registered Land Surveyor S-1594

W4056 BRAY RD.
ELKHORN, WI. 53121
PHONE: (262) 723-4260 (OFFICE)
(262) 723-7209 (FAX)
Email: abernathy@elknet.net


PLAT OF SURVEY

LOTS 7 THROUGH 11 AND LOTS 19 THROUGH 24, BLOCK 2, MAPLE HILLS "A" SUBDIVISION, LOCATED IN SECTION 18, TOWN 1 NORTH, RANGE 17 EAST, LINN TOWNSHIP, WALWORTH COUNTY, WISCONSIN.

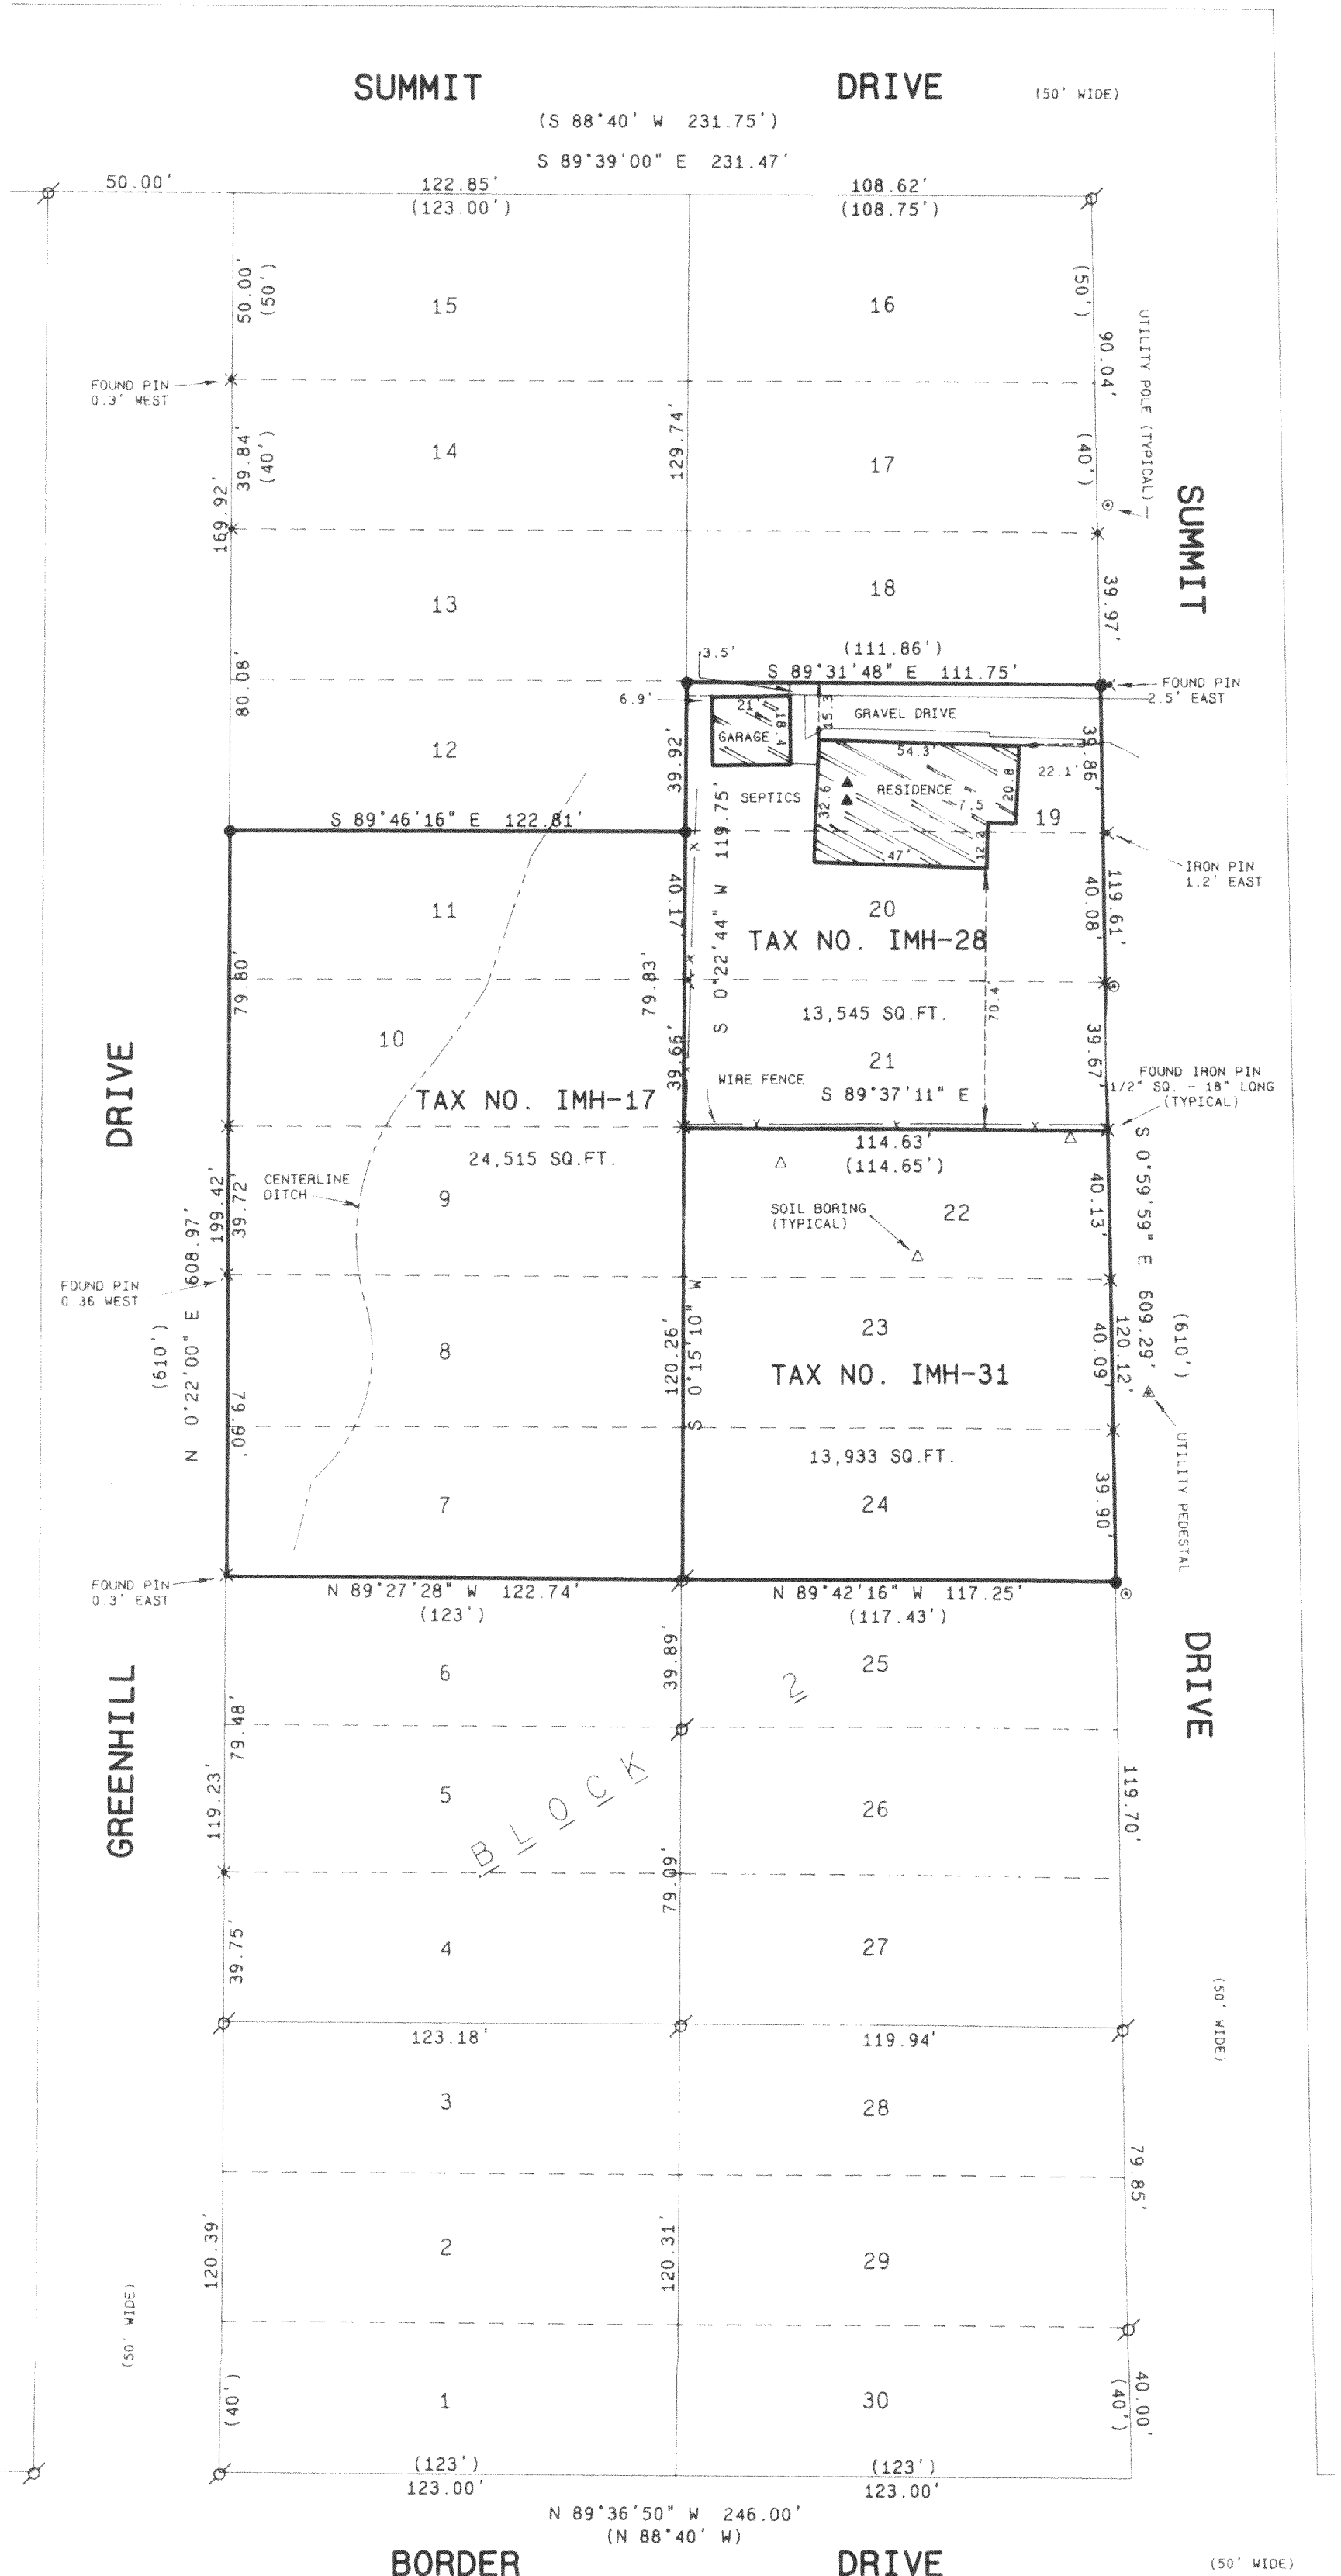


ORDERED BY: CONNIE POGGENSEE
THE RAULAND AGENCY INC.
POST OFFICE BOX 159
WALWORTH, WISCONSIN
53184-0159

OWNERS: EDWARD & GEORGIA OLSEN

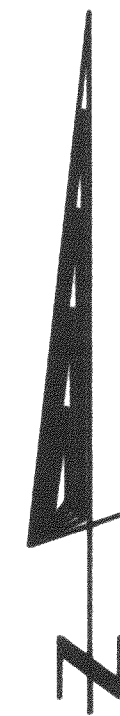

SCALE: 1 INCH = 40 FEET

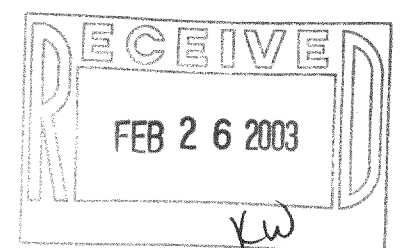

NOTES

1. WATER IS SUPPLIED VIA UNDERGROUND PIPES FROM A WELL AT A RESIDENCE ON LOTS 25-26, BLOCK 2, AS PER OWNER.
2. SEPTIC TANKS ARE LOCATED IN A CRAWL SPACE OF THE HOUSE AS NOTED (AN ACCESS DOOR PROVIDES ACCESS FOR MAINTENANCE).

Legend

- FOUND IRON PIPE
- FOUND IRON ROD
- FOUND BRASS CAPPED MONUMENT
- FOUND CONCRETE MONUMENT
- CHISEL CUT IN CONCRETE
- SET IRON ROD, 24" LONG, WEIGHING 1.5 LBS./LINEAL FT., 3/4" DIA.
- SET IRON ROD, 30" LONG, WEIGHING 4.5 LBS./LINEAL FT., 1 1/16" DIA.
- RECORDED AS DIMENSION
- EXISTING FENCE



SCALE: 1"= 40 FEET

I hereby certify that the above described property has been surveyed by me or under my direction and that the above map is a true representation thereof and shows the size and location of the property, its exterior boundaries, the location of all visible structures and dimensions of all principal buildings thereon, boundary fences, apparent easements, roadways and visible encroachments, if any.

This survey is made for the use of the present owners of the property, and also those who purchase, mortgage, or guarantee the title thereto within one year from date hereof.

Kenneth B. Abernathy, Jr.
KENNETH B. ABERNATHY, JR.
WISCONSIN REGISTERED LAND SURVEYOR,
S-1594

Date: 10/21/2002 Job No. 021002

IMH-17, IMH-28, IMH-31