



PLAT OF SURVEY

LOCATION: 1419 Academy Road, Linn, Wisconsin


LEGAL DESCRIPTION: Lot 3 of **CERTIFIED SURVEY MAP NO. 516**, located in the West 1/2 of the Southeast 1/4 of Section 18, Town 1 North, Range 17 East, Town of Linn, Walworth County, State of Wisconsin.

February 7, 2003

Survey No. 95765

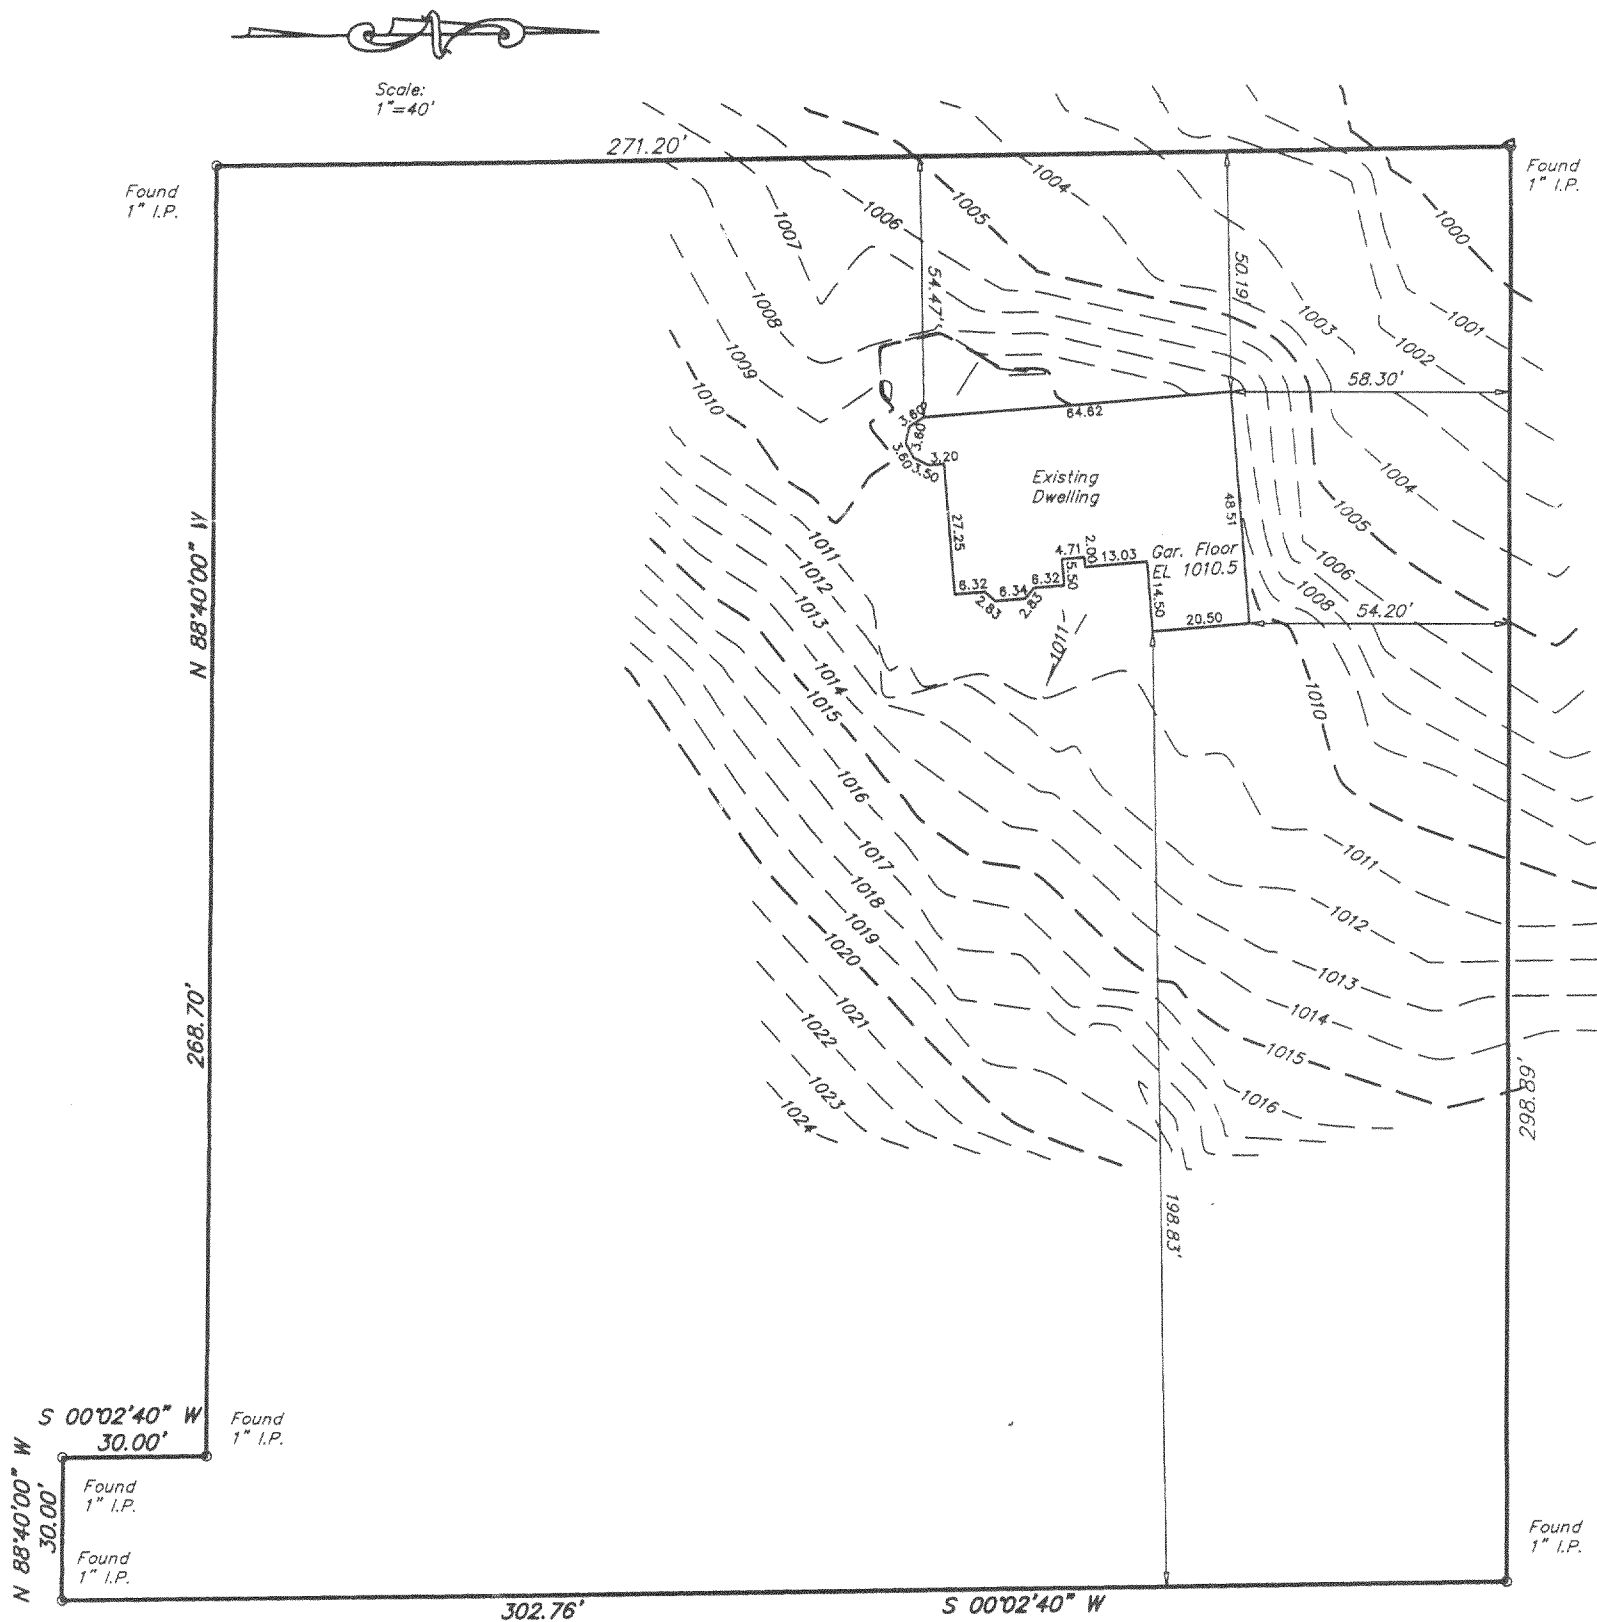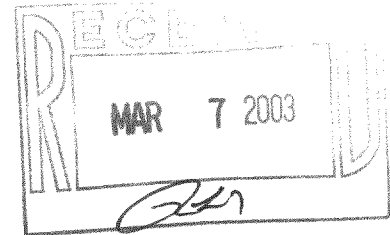

METROPOLITAN SURVEY SERVICE, INC.
 REGISTERED LAND SURVEYORS
 5200 W. LOOMIS RD. • GREENDALE, WI 53129
 PH. 529-5380 FAX 529-9787

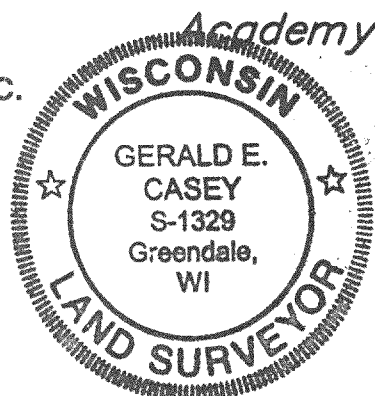

I HEREBY CERTIFY THAT I HAVE SURVEYED THE ABOVE DESCRIBED PROPERTY AND THAT THE ABOVE MAP IS A TRUE REPRESENTATION THEREOF AND SHOWS THE SIZE AND LOCATION OF THE PROPERTY, ITS EXTERIOR BOUNDARIES, THE LOCATION OF ALL VISIBLE STRUCTURES AND DIMENSIONS OF ALL PRINCIPAL BUILDINGS THEREON, BOUNDARY FENCES, APPARENT EASEMENTS AND ROADWAYS AND VISIBLE ENCROACHMENTS, IF ANY.

THIS SURVEY IS MADE FOR THE EXCLUSIVE USE OF THE PRESENT OWNERS OF THE PROPERTY, AND ALSO THOSE WHO PURCHASE, MORTGAGE, OR GUARANTEE THE TITLE THERETO WITHIN ONE (1) YEAR FROM DATE HEREOF.

SIGNED

117-2251

IA 516-3