


560
556.27
3.73

NORTH
Scale 1" = 50'

LAKE GENEVA

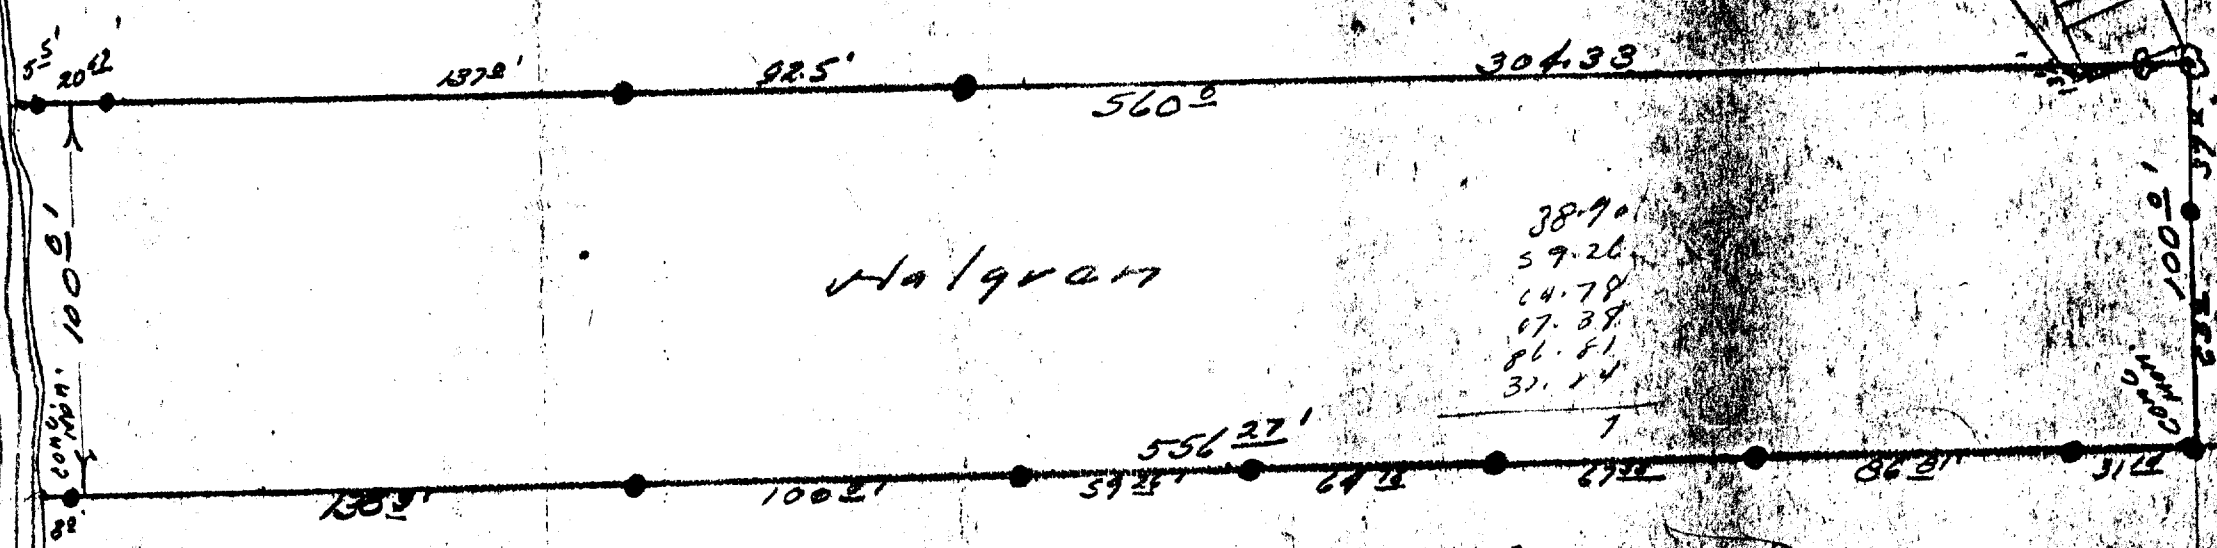

Halgrah

38.90
59.26
14.79
17.38
86.81
31.14

Comm. at a concrete mon. that is 1048.08 feet North of and 692.34 feet East of the West 1/4 Section cor of Section 12, T. 1. N, R. 17. E. of the 4th P.M., thence North 556.27 to a point in the shore of Lake Geneva, thence northeasterly along the shore of Lake Geneva 100 feet to a point that is 1608.08 feet North of and 792.34 feet East of the West 1/4 Section cor of Section 12, T. 1. N, R. 17. E., of the 4th P.M., thence South 560.0 feet to a point, thence West 100.0 feet to the place of beginning.

New Cert. Sur. #483 117-2168k

34

8/4/26

Survey for bridge
lot 1, Lakeside

Found square stone

Found stake at S.W.

iron stake at S.E.

N. line 50+610 ft.

iron stke under.

At Seers request set

N. line and running

lot 1, making

as sold run app

and house to west,

are on lot 2 are

3 iron stks set

Seers,
Park or Elgin Club,
Mons. N.E. & N.W. corners
Cor. and stone and
Cor. E. line 174' to N. line ^{walk} at
E. line 174' to stone with
and wood stake at S.W. Cor.
off a strip 15' wide at
to ~~the~~ the S.E. Cor. of
the east line of lot 1
parallel to Seers house
Seers house & house west
not parallel.
on new east line,

Elgin Club - Lot 1

117-226 Sh ✓