

ADDENDUM TO PLAT OF SURVEY
SHOWING TOPOGRAPHIC DETAIL
LOT 1 CSM 1673

WORK ORDERED BY: TERRY SMITH
T. SMITH & CO.
PO BOX 816
WILLIAMS BAY, WI. 53191

FARRIS, HANSEN & ASSOCIATES, INC.
ENGINEERING - ARCHITECTURE - SURVEYING
7 RIDGWAY COURT P.O. BOX 437
ELKHORN, WISCONSIN 53121
OFFICE: (262) 723-2098 FAX: (262) 723-5886

REVISIONS


PROJECT NO.
1813.96
DATE
12-22-99
SHEET NO.
1 OF 1

117-2270





BEARING BASIS BASED ON CSM BEARINGS

LOT 2 CSM 1673

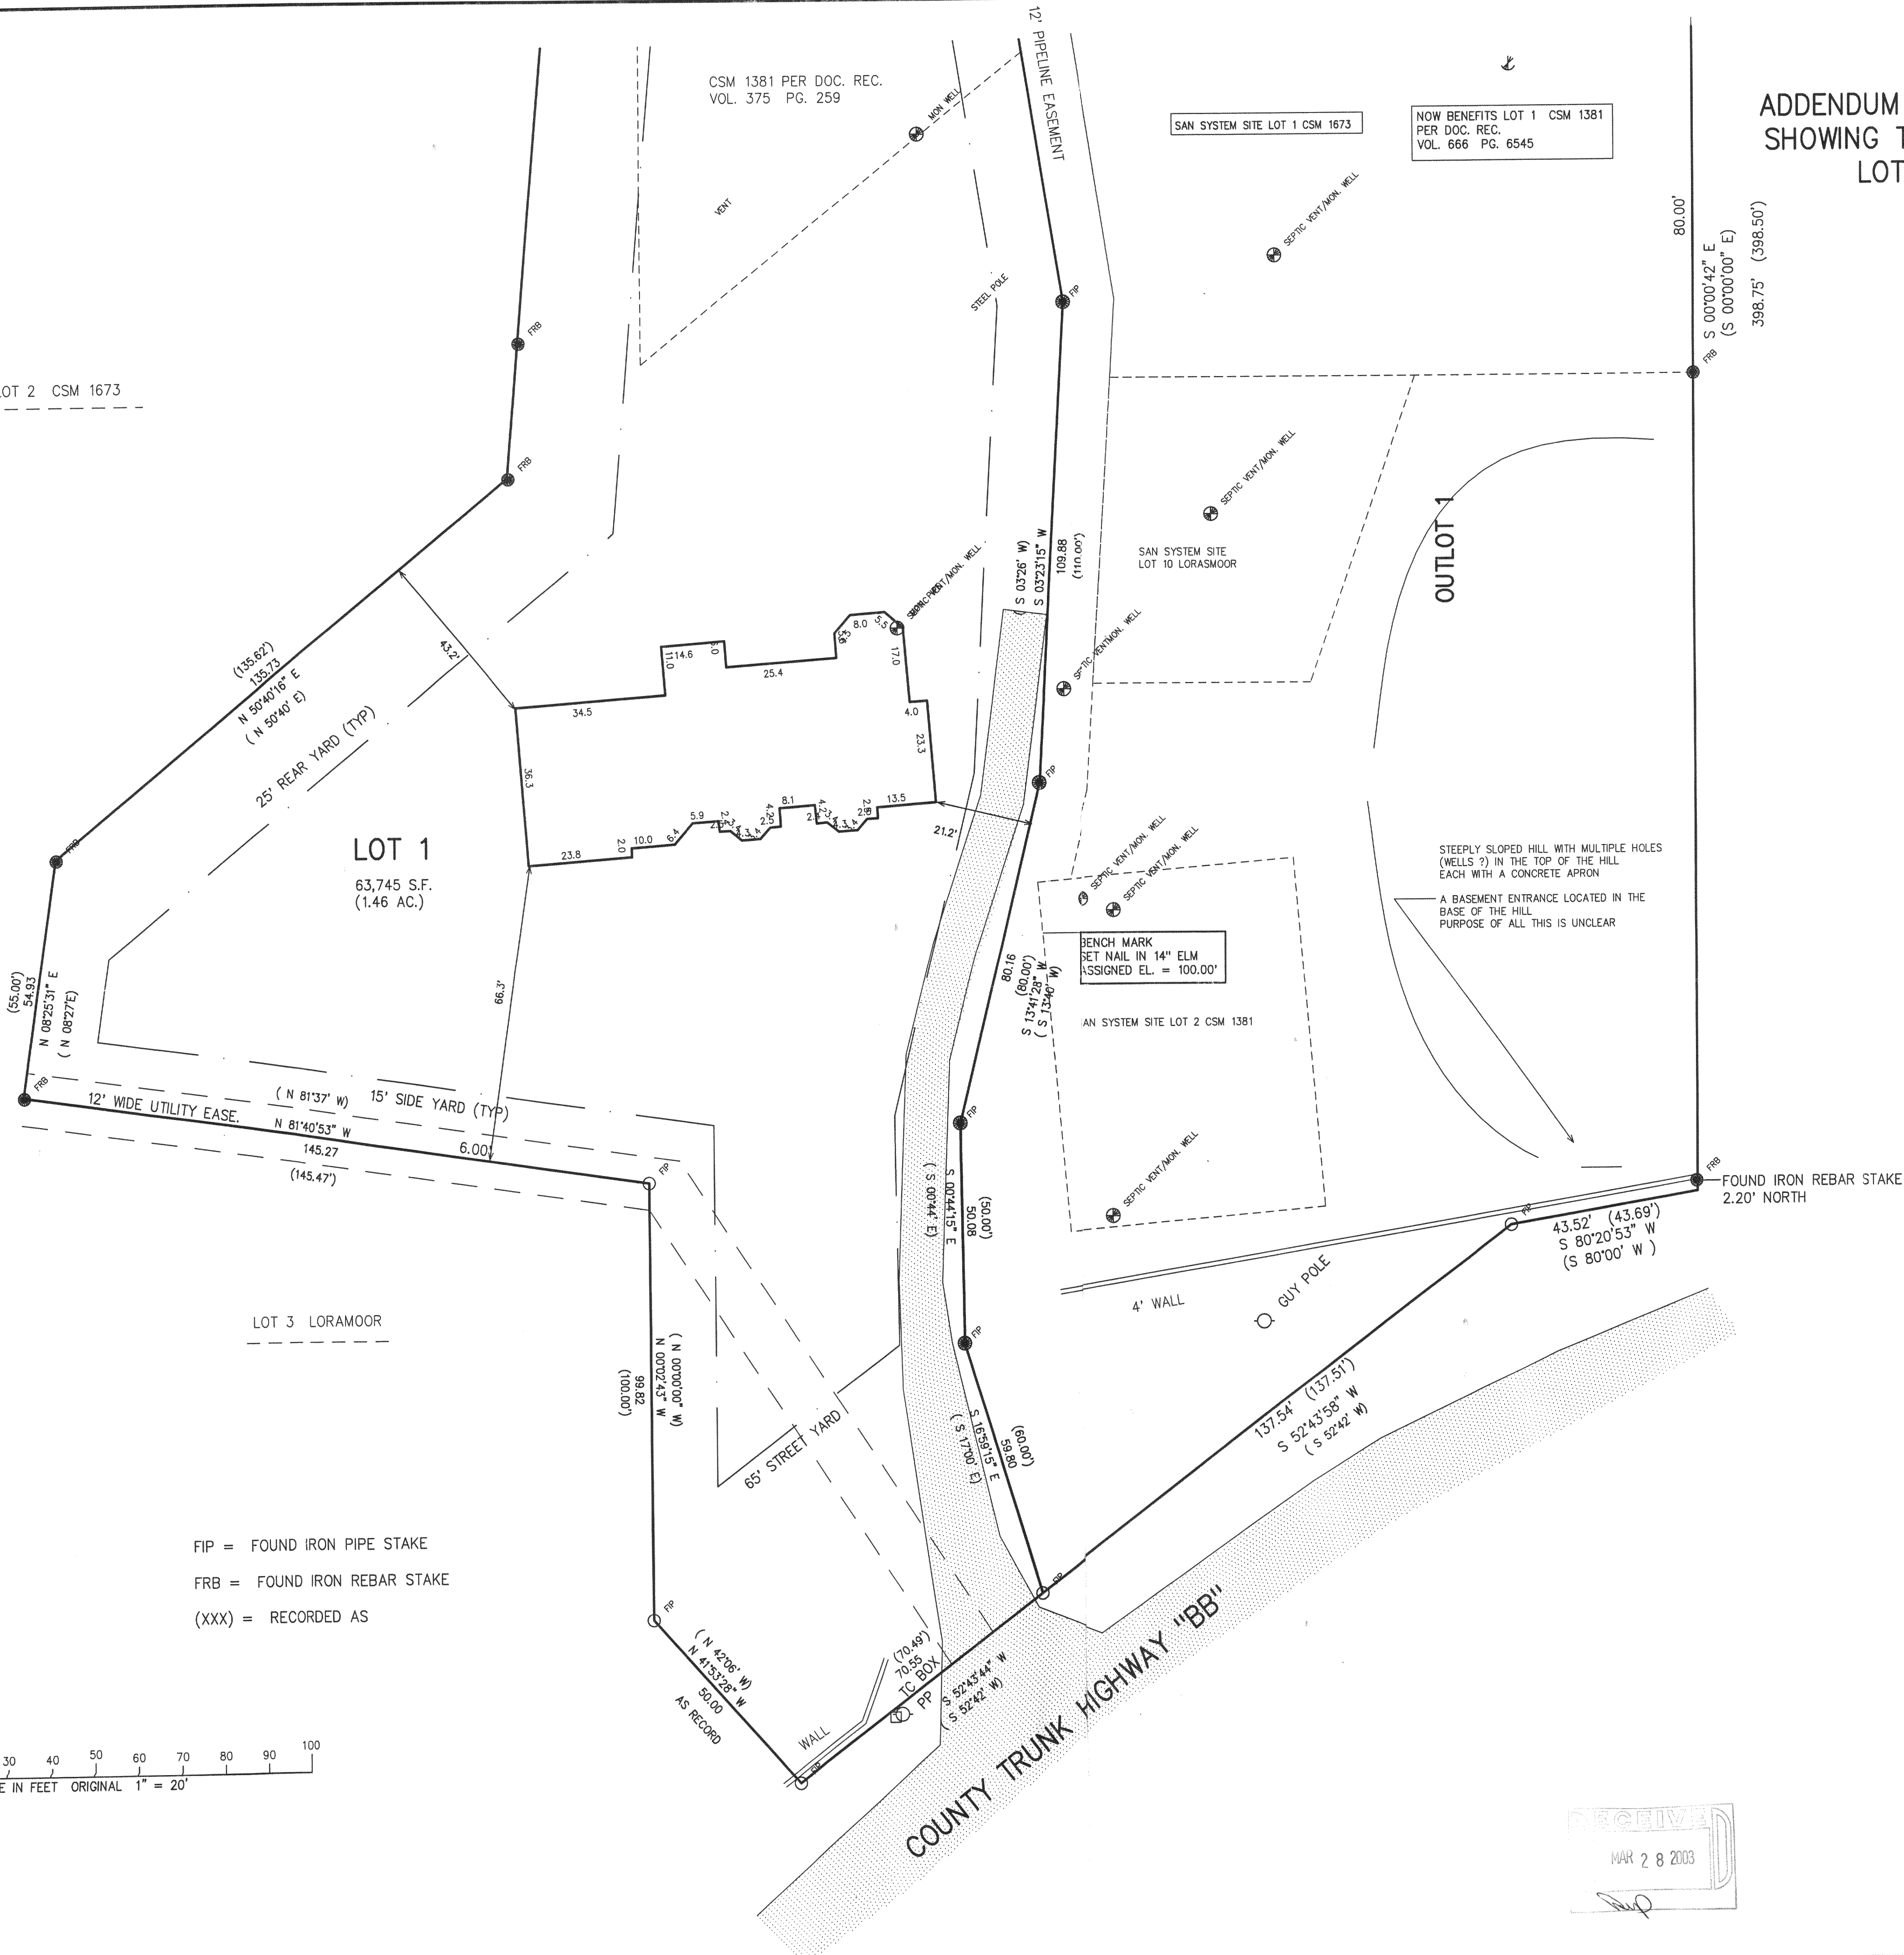

FIP = FOUND IRON PIPE STAKE
FRB = FOUND IRON REBAR STAKE
(XXX) = RECORDED AS

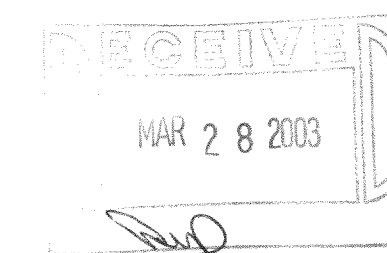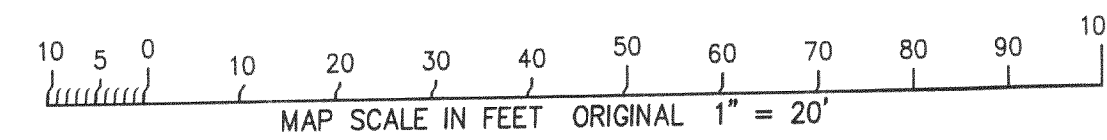

Revised
1-16-2003
to show size + location
of residence as built

1A1673-1

JAN 16 2003