


DUNHAM SURVEYING, S.C.
SURVEYING & SUBDIVIDING
DELAVAN, WISCONSIN 53115

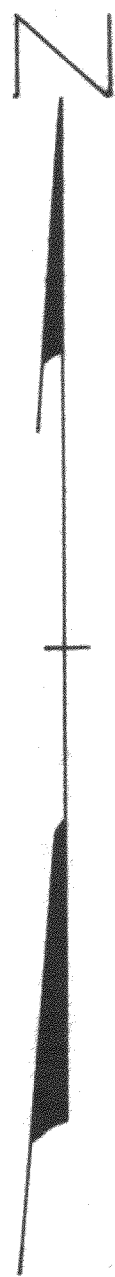

Scale - 1" = 40'

○ = Iron Pipe Found

● = Iron Pipe Set

--- = Fence Line

Fence Line 0.05'± east
of property line

STATE OF WISCONSIN) SS
COUNTY OF WALWORTH)

I, George T. Dunham, Surveyor, certify that I have
surveyed the property described as follows,
Lot 8, Block 1 of Trinke Estates, located in the
Southeast ¼ of Section 10, T 1 N, R 17 E, Walworth
County, Wisconsin,

and the above map is a true representation thereof and shows
the size and location of the property, its exterior boundaries,
the location and dimensions of all structures thereon, fences,
apparent easements and roadways and visible encroachments, if any.
This survey is made for the exclusive use of the present owners
of the property, and also those who purchase, mortgage, or
guarantee the title thereto within one (1) year from date hereof;
and as to them I warrant the accuracy of said survey and map.
August 25, 1978

Updated and recertified to this
23rd day of June, 1998

George T. Dunham
George T. Dunham, Surveyor

