


DUNHAM SURVEYING, S.C.  
SURVEYING & SUBDIVIDING  
DELAVAL, WISCONSIN 53115

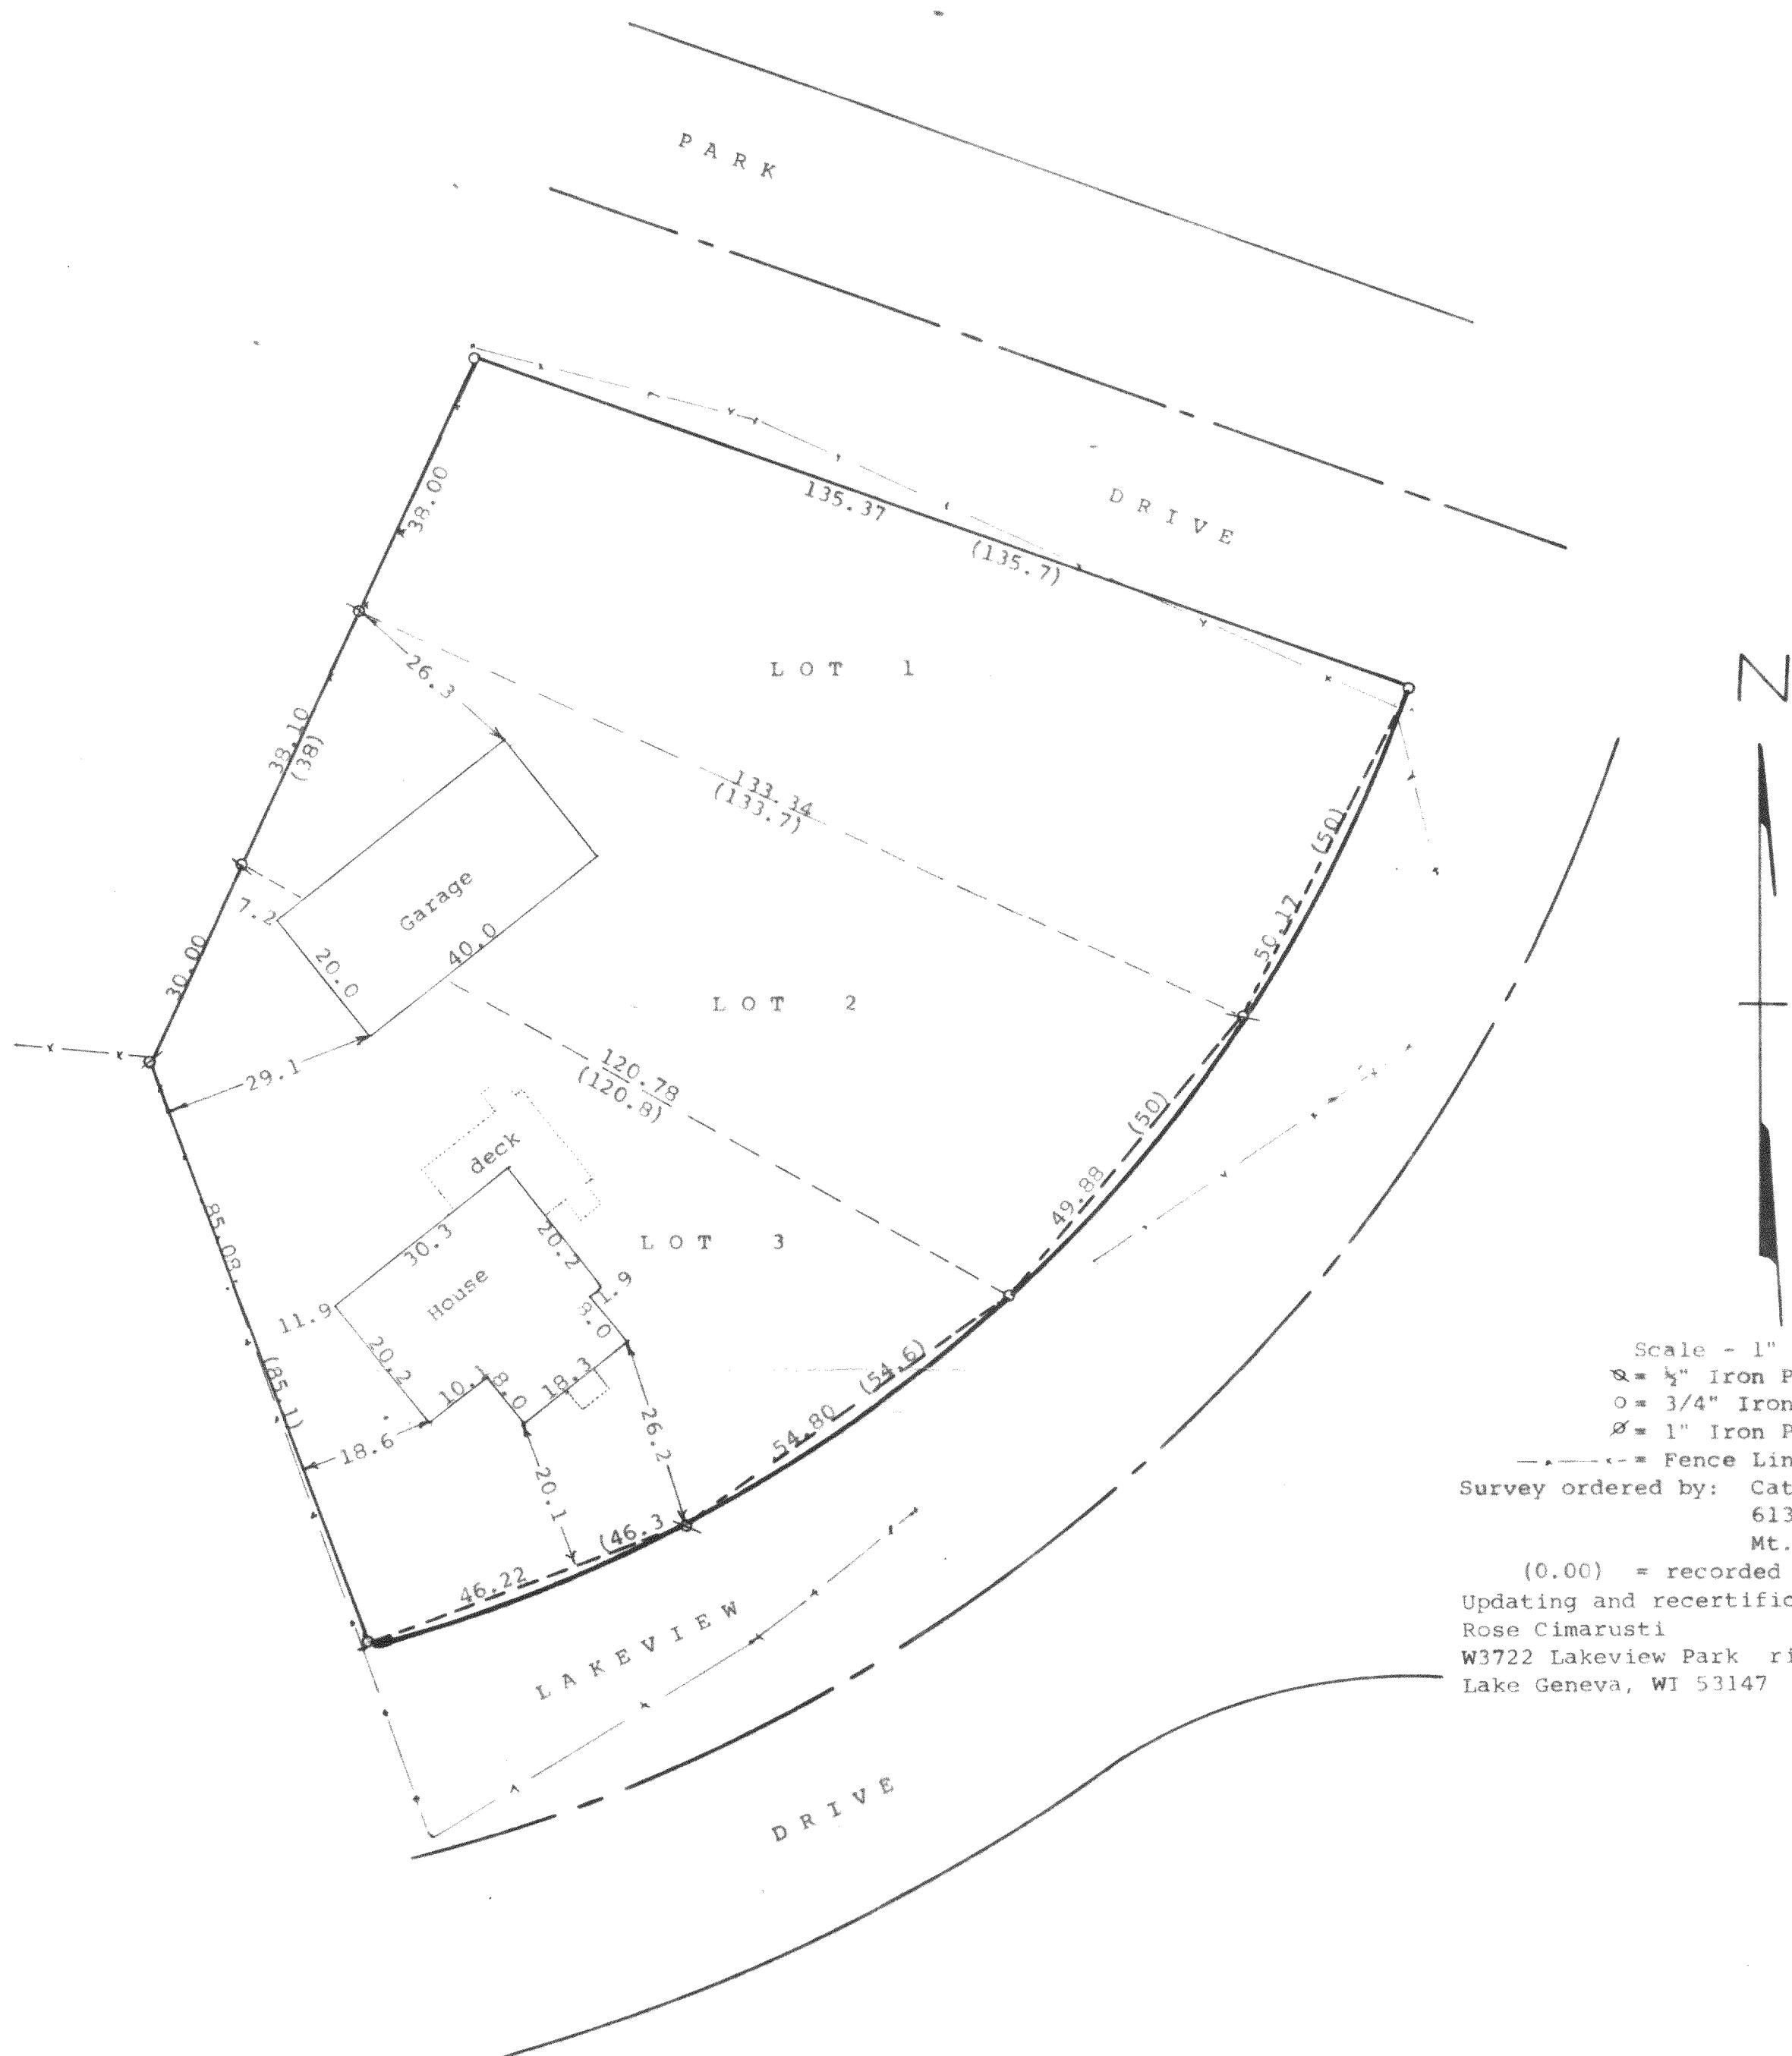

STATE OF WISCONSIN) SS  
COUNTY OF WALWORTH)

I, George T. Dunham, Surveyor, certify that I have surveyed the property described as follows:

Lots 1, 2, and 3 in Block 4 of Lake View Park, a subdivision located in Section 16, T 1 N, R 17 E, Walworth County, Wisconsin and that the plat shown hereon is a correct representation thereof and shows the size and location of the property, its exterior boundaries, the location of all visible structures and dimensions of all principal buildings thereon, boundary fences, apparent easements, roadways and visible encroachments, if any, and that I have surveyed the property hereon described, according to the official records, to the best of my knowledge and belief.

October 18, 1994

Plat drawn June, 1995

Updated and recertified to this 10th day of June, 1998

George T. Dunham  
George T. Dunham, Surveyor

