


DUNHAM SURVEYING, S.C.
SURVEYING & SUBDIVIDING
DELAWARE, WISCONSIN 53115

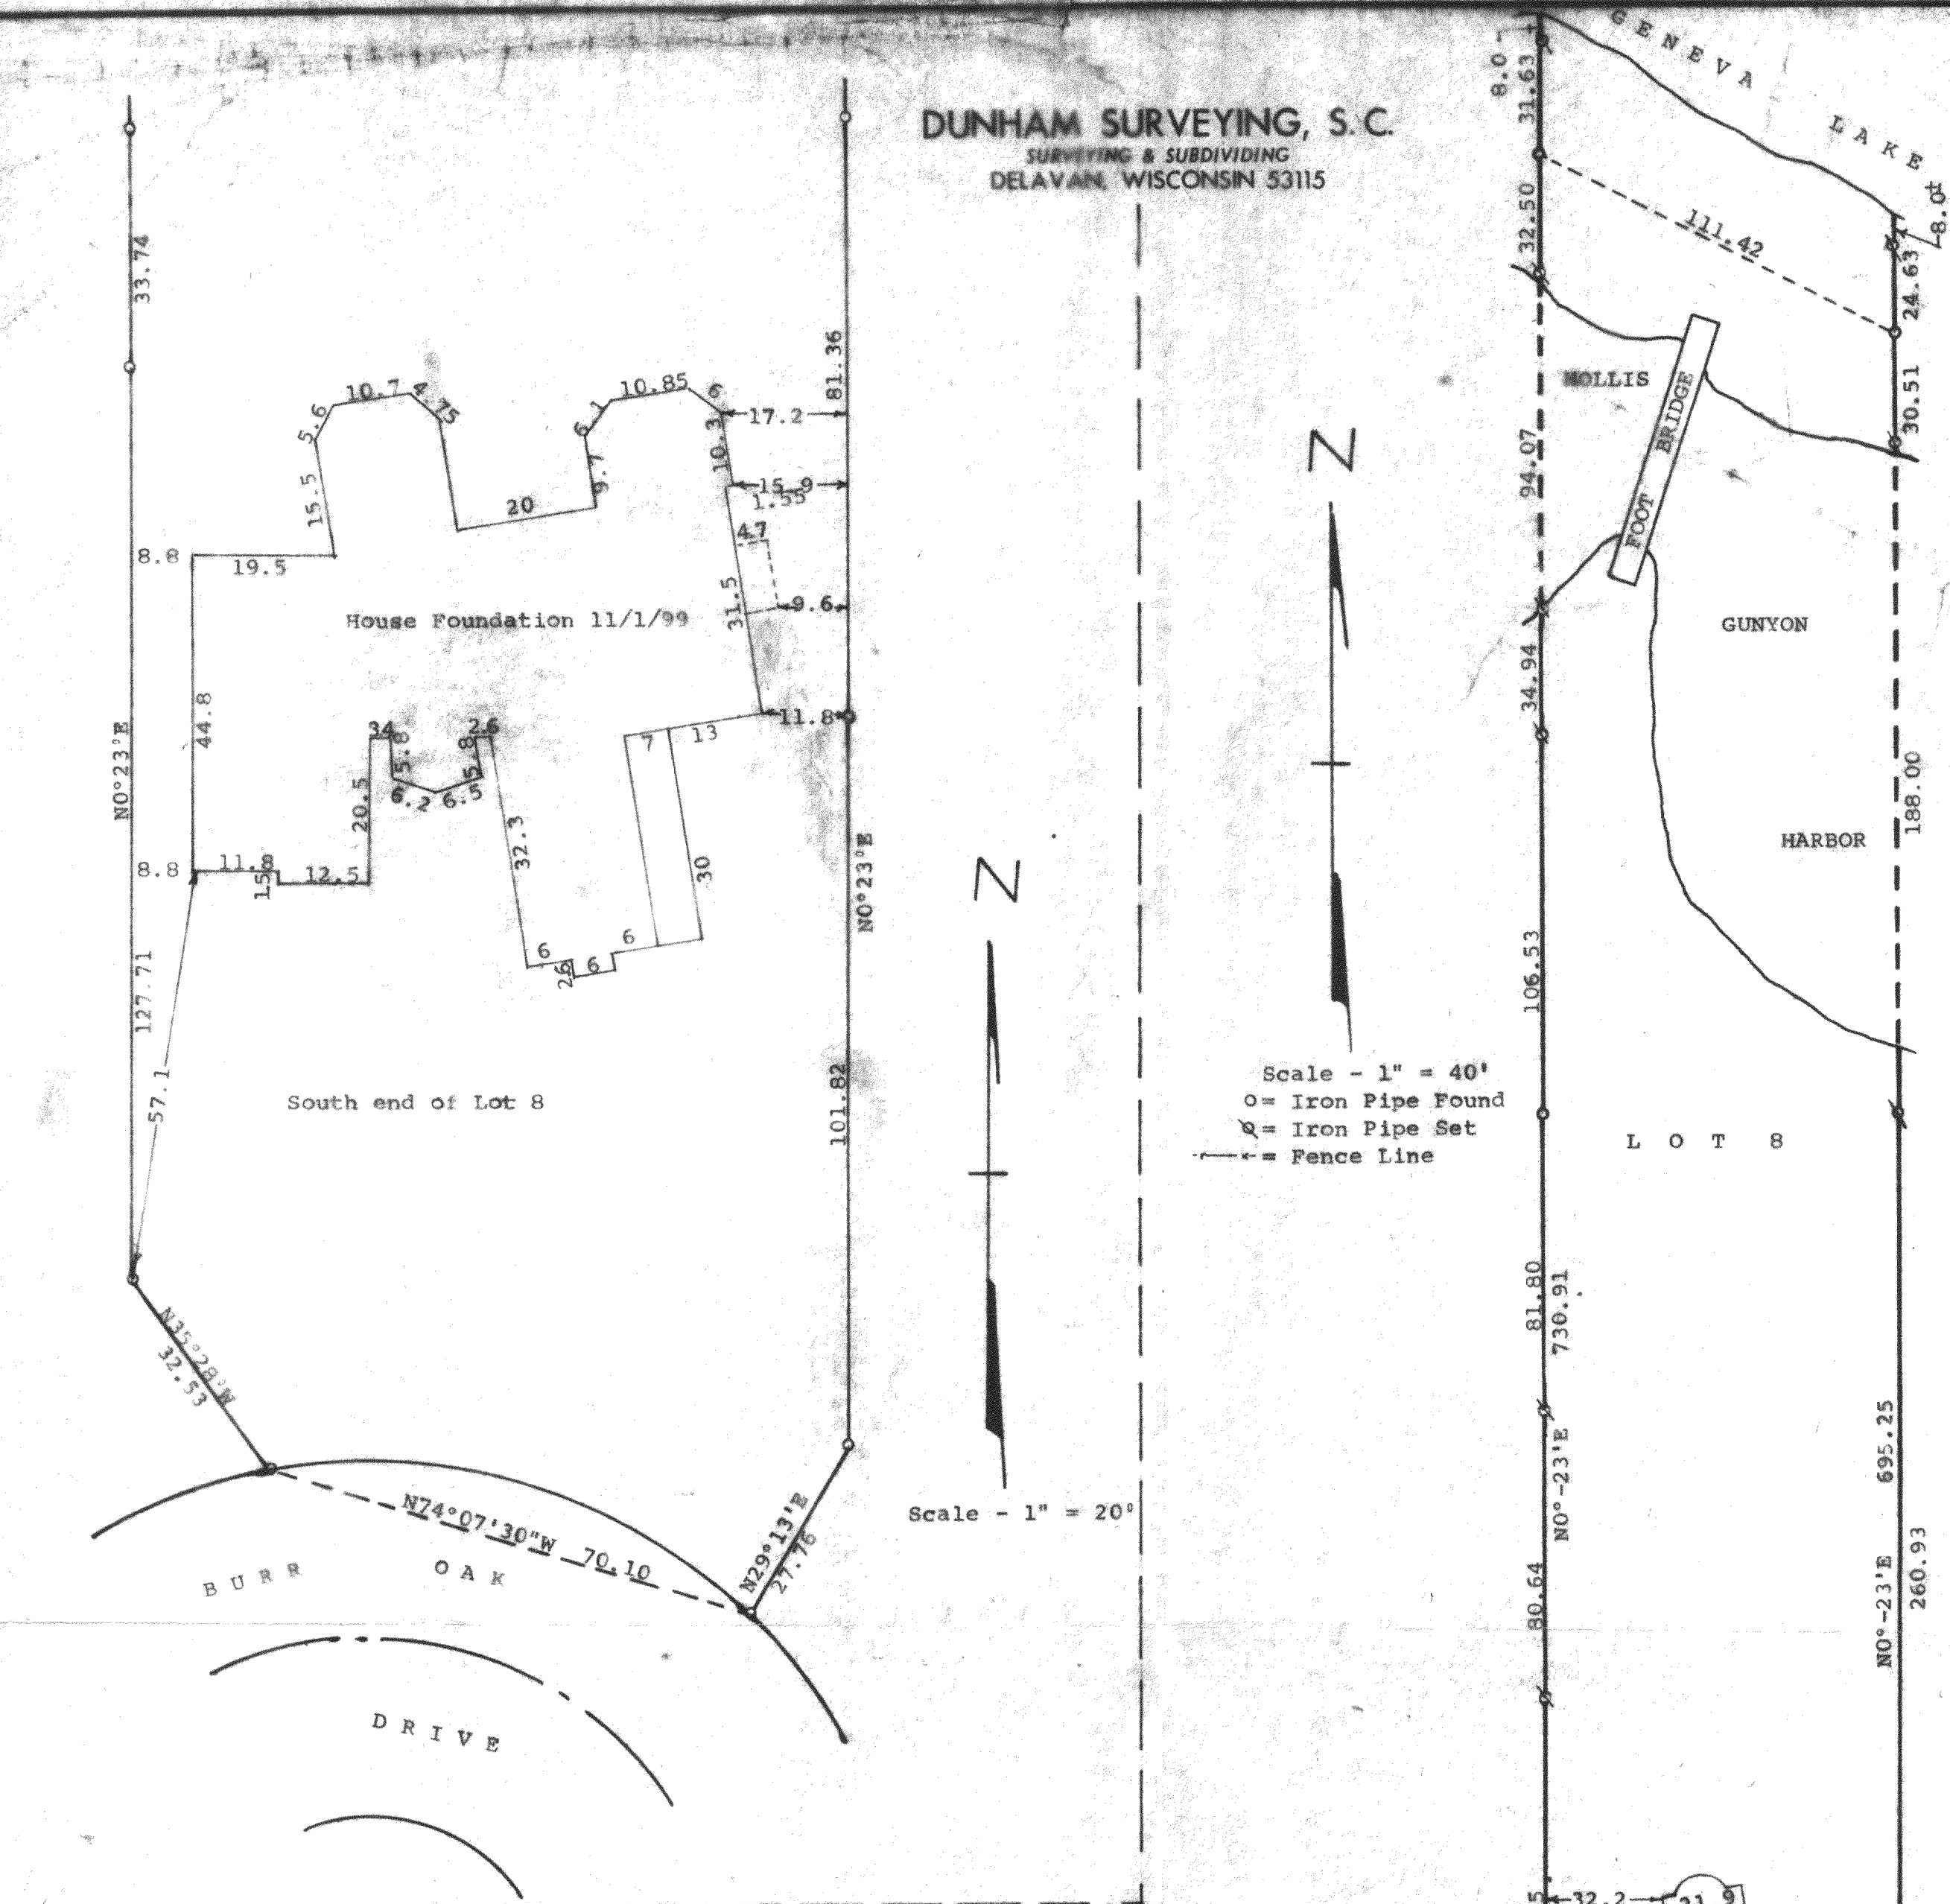

STATE OF WISCONSIN)
COUNTY OF WALWORTH)

I, George T. Dunham, Surveyor, certify that I have surveyed the property described as follows.

Lot 8, Block 1 of Trinke Estates, located in the Southeast 1/4 of Section 10, T 1 N, R 17 E, Walworth County, Wisconsin,

and the above map is a true representation thereof and shows the size and location of the property, its exterior boundaries, the location and dimensions of all structures thereon, fences, apparent easements and roadways and visible encroachments, if any. This survey is made for the exclusive use of the present owners of the property, and also those who purchase, mortgage, or guarantee the title thereto within one (1) year from date hereof; and as to them I warrant the accuracy of said survey and map.

August 25, 1978
Updated and recertified to this 23rd day of June, 1998


Updated August 17, 1999 to show proposed location of proposed Additions

Updated November 1, 1999 to show location of new and remaining old foundation for new house.

Updated Jan. 7, 2000 to show location of proposed garage

Updated March 14, 2000 to show location of new garage

George T. Dunham
George T. Dunham, Surveyor

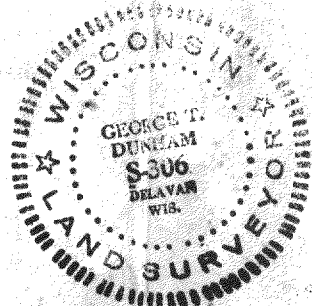

Fence Line 0.05'± east of property line

