

Plat of Survey

of

Lot 2 of Certified Survey Map No. 223,
recorded in Vol. 2 of Certified Survey Maps of Walworth County
on Page 223 and located in the Southeast 1/4 of Section 11,
Town 1 North, Range 17 East, Walworth County, Wisconsin.

Surveyed for: **Montsma Builders, Inc.**
917 Racine Street
Delavan, Wisconsin. 53115


Owners: **Jeffrey & Jeanne Allis**
1267 Forest Glen South
Winnetka, Illinois. 60093

Tax Parcel
IL 1100006

(South 498.51')
North 498.75'

Lot 2
1.112 Acres
48,433 Sq.Ft.
1.035 Acres
45,085 Sq.Ft.
Exclusive of R.O.W.


Lot 1
C.S.M. 1506

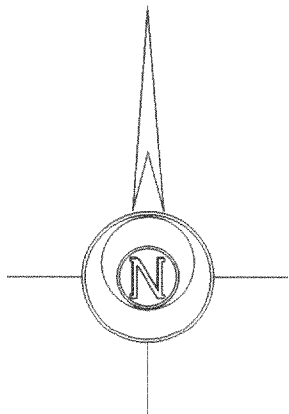

Bearings reference to Certified
Survey Map No. 223



Notes: 1) This survey plat is not
certified unless signed
and sealed in red ink.
2) This survey is subject to Wisconsin lien laws.
This Plat of Survey is the notice of intent
to file lien. Lien waiver required.

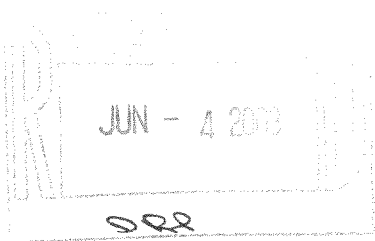

Copyright c 2002 by Jensen & Olson Land Surveying, LLC.

All rights reserved. No part of this survey plat may be reproduced
or transmitted in any form by any means - graphic, electronic, or
mechanical, including photocopying, tracing, or information storage
and retrieval systems - without permission in writing from Douglas
G. Olson, Jensen & Olson Land Surveying, LLC.

I, Douglas G. Olson, Wisconsin Registered Land Surveyor,
do hereby certify that this survey was performed by me or under my
direction in full compliance with the owner's/agent's instructions
and Chapter A-E 7 of the Wisconsin Administrative Code "Minimum
Standards for Property Surveys"; and that this map is an accurate
representation thereof to the best of my knowledge and belief.

Douglas G. Olson
Wisconsin Registered Land Surveyor - 2093

County Trunk Highway BB
(66' Wide)

2002.209

Sheet 1 of 1 Sheets
Job Reference Number
2002.209

Legend
■ Found Concrete Monument
⊗ Found Iron Pipe
● Set Iron Rod 3/4" dia.
□ Set Wood Stake
() Recorded Information
x Utility Pole
▨ Asphalt Surface ▨ Gravel



Jensen & Olson Land Surveying, LLC
45 South Wisconsin Street P.O. Box 322
Elkhorn, Wisconsin. 53121
Telephone (262) 723-3434
Facsimile (262) 723-8044

Scale in Feet
1" = 30'



Survey Date: November 14, 2002.
Revisions: No. 1 - Foundation