


Property Exhibit

of



Lot 2 of Certified Survey Map No. 3489,

recorded in Vol. 20 of Certified Survey Maps of Walworth County on Page 184 and located in the Northwest 1/4 and the Southwest 1/4 of the Northwest 1/4 of Section 2, Town 1 North, Range 17 East, Town of Linn, Walworth County, Wisconsin.


Prepared for: **John A. Hagenah**
512 Green Bay Road
Suite 301
Kennilworth, Illinois. 60043

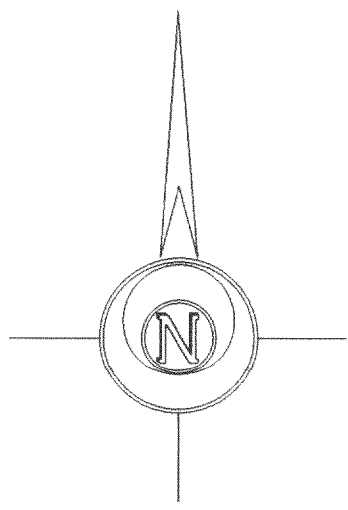

Bearings reference to the Wisconsin State Plane Coordinate System, South Zone.

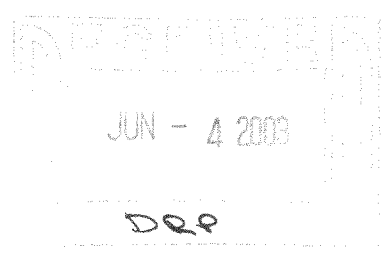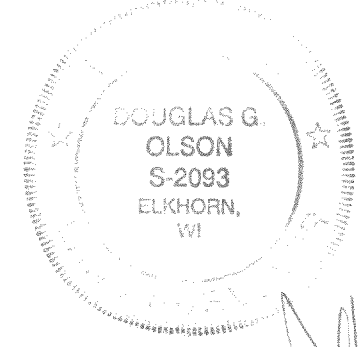

Copyright © 2002 by Jensen & Olson Land Surveying, LLC.
All rights reserved. No part of this survey plat may be reproduced or transmitted in any form by any means - graphic, electronic, or mechanical, including photocopying, tracing, or information storage and retrieval systems - without permission in writing from Douglas G. Olson, Jensen & Olson Land Surveying, LLC.

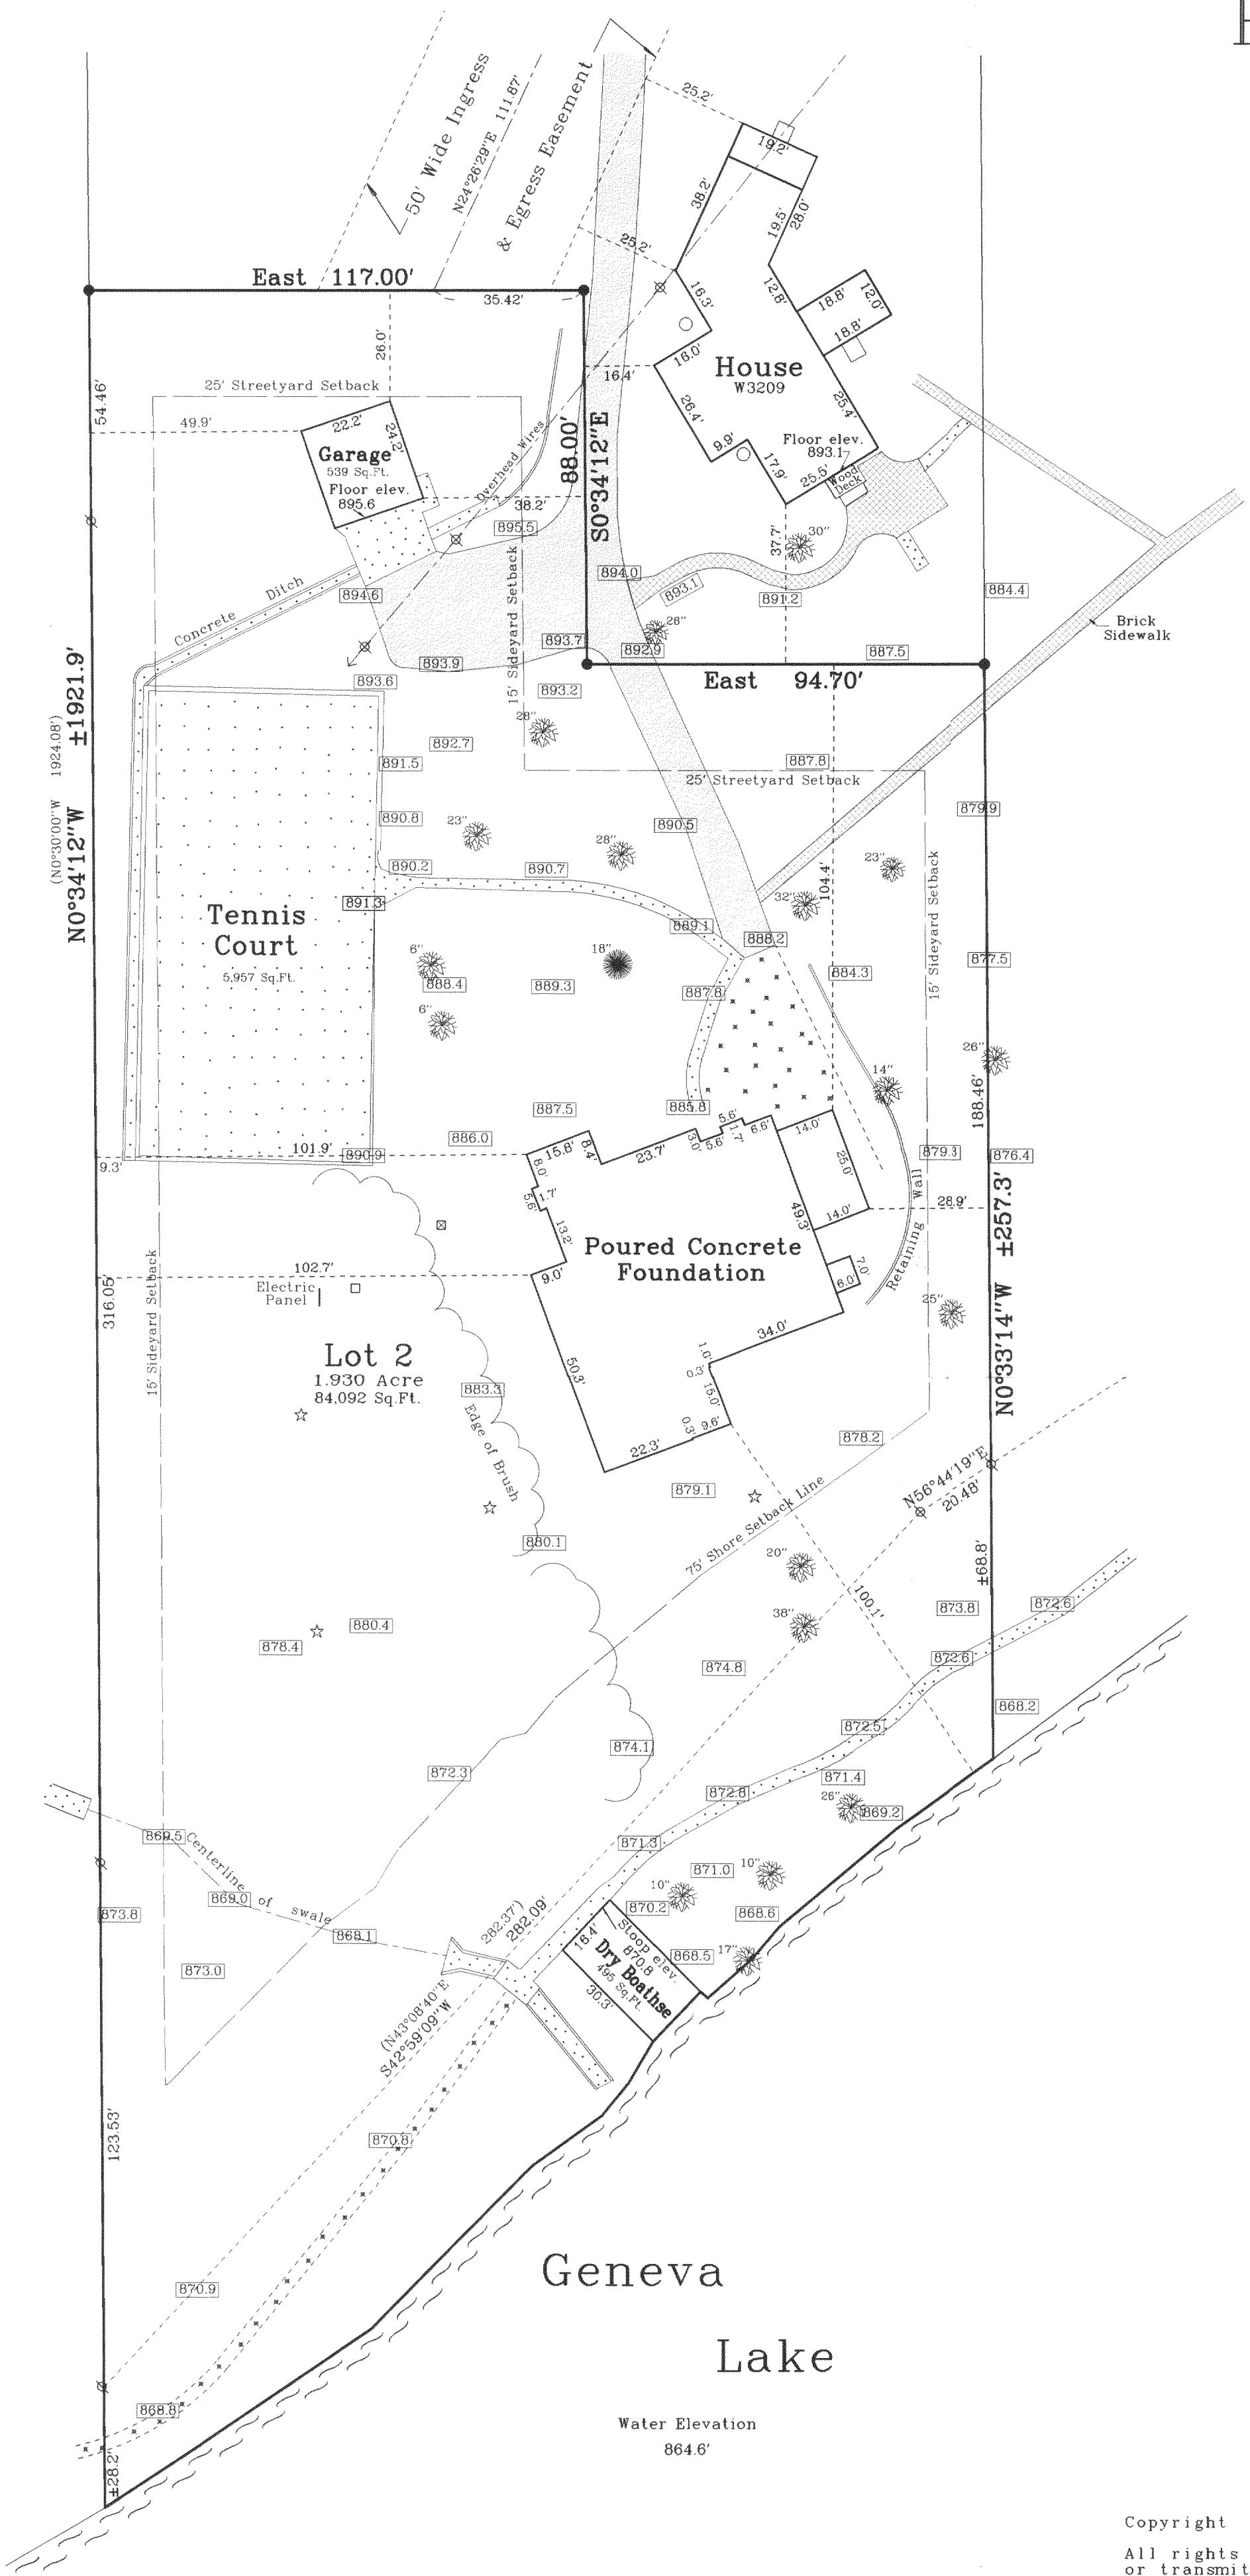

TA 3489-2

117-2296