


B/S

HAROLD H. KOLB


REGISTERED PROFESSIONAL LAND SURVEYOR
LAKE GENEVA, WISCONSIN

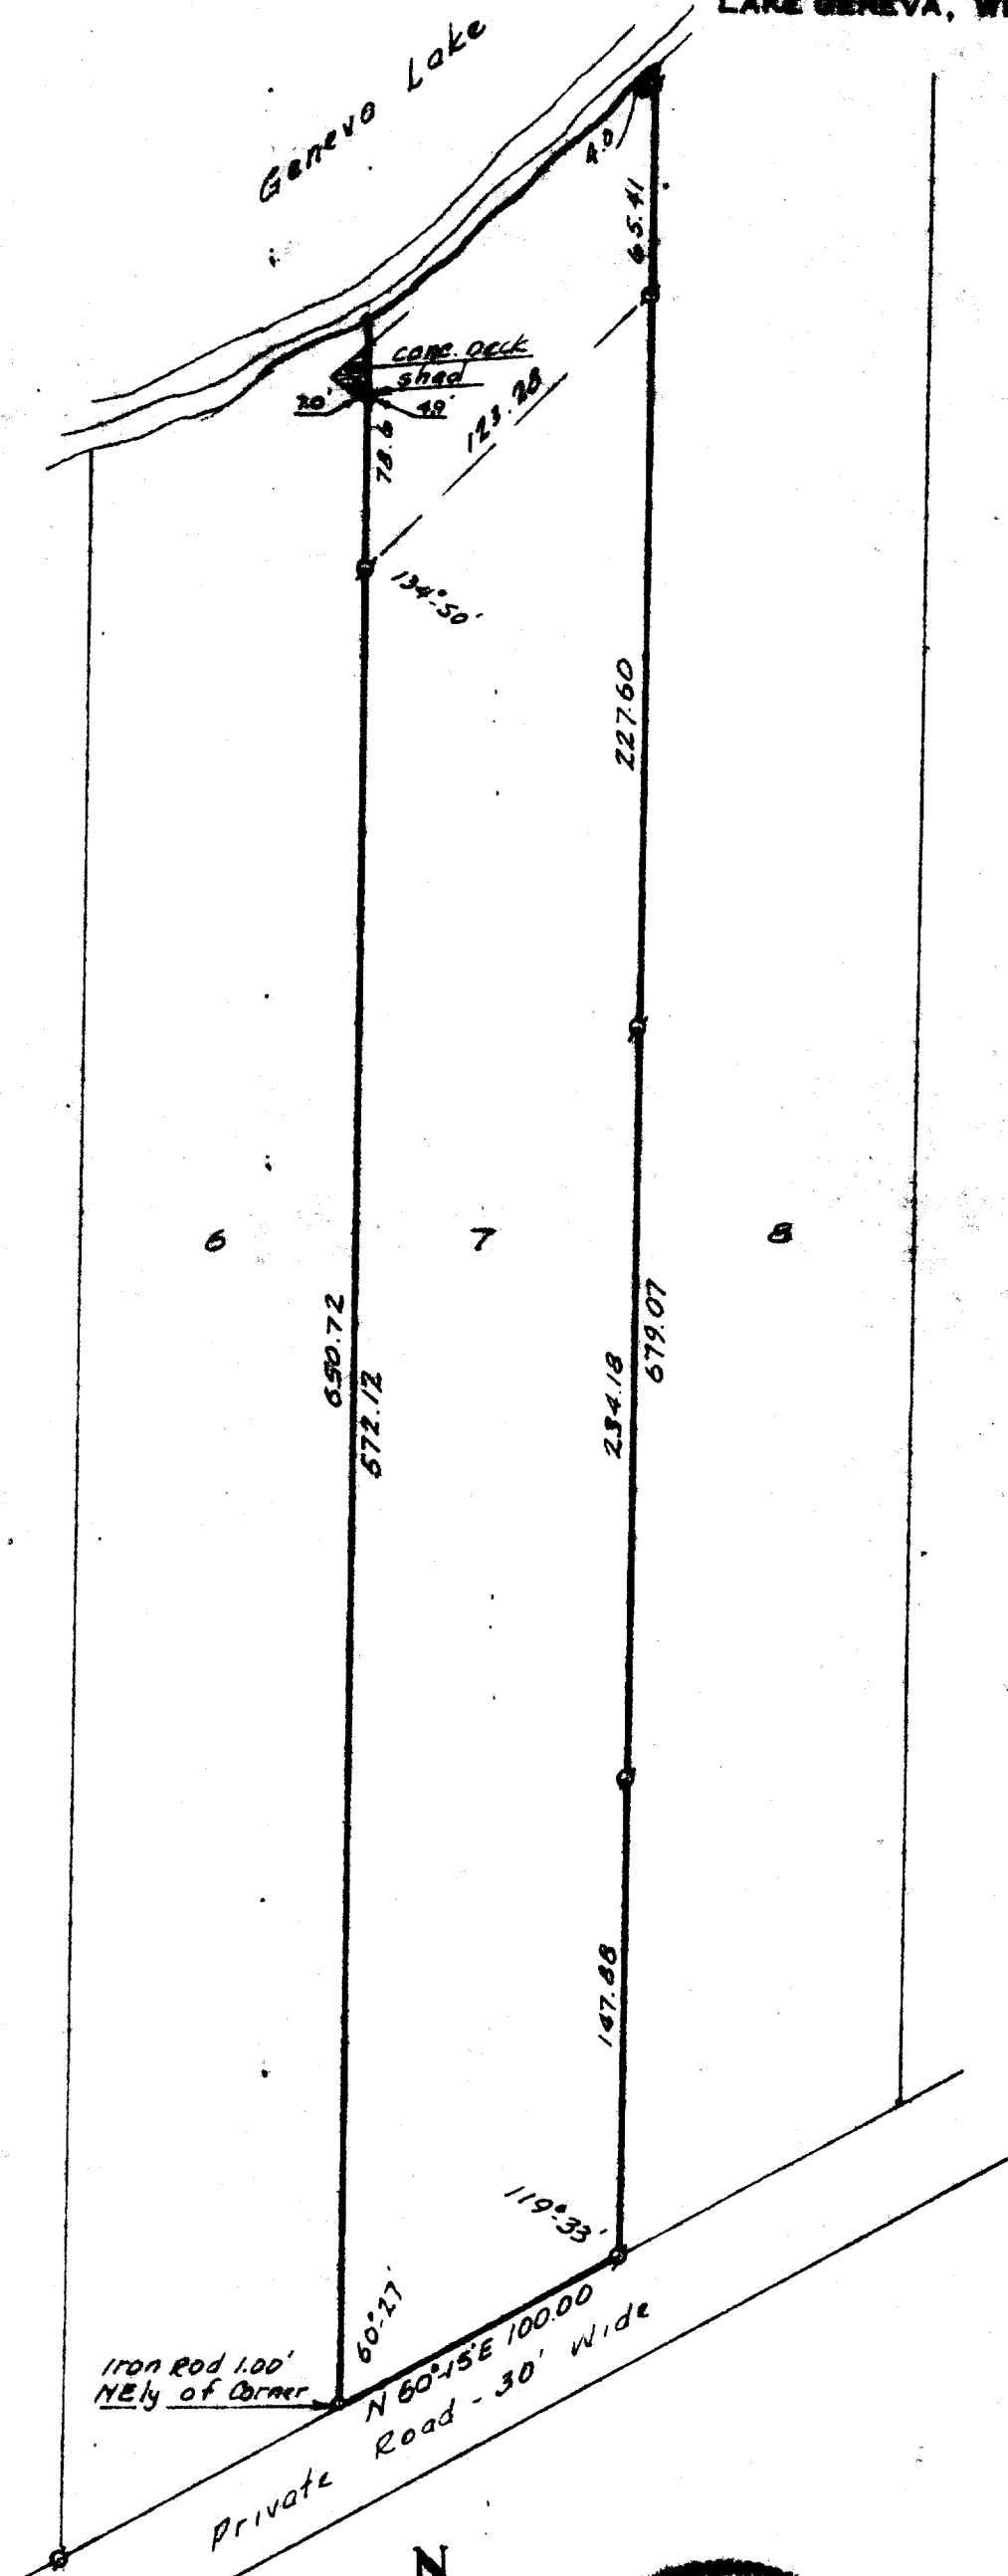

PEAT OF SURVEY OF
Lot 7, The Birches, a subdivision
located in the Northwest $\frac{1}{4}$ of Section
10, T 1 N, R 17 E, Walworth County,
Wisconsin.

LEGEND

- ⊕ - IRON PIPE FOUND
 - - IRON ROD PLACED
 - - CONCRETE MONUMENT
 - ✕ - SPIKE
- SCALE - 1" = 60'

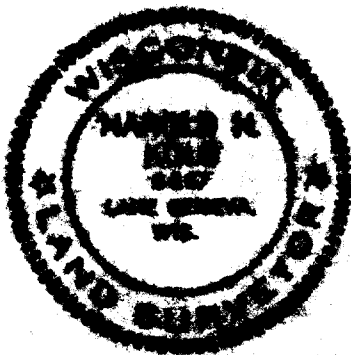

I, HAROLD H. KOLB, DO HEREBY CERTIFY THAT I HAVE
SURVEYED THE PROPERTY HEREON DESCRIBED ACCORDING
TO THE OFFICIAL RECORDS, AND THAT THE PLAT HEREON
IS A CORRECT REPRESENTATION OF THE LOT LINES.

Harold H. Kolb

HAROLD H. KOLB
WISCONSIN REGISTERED LAND SURVEYOR, S-187
DATE JUNE 6, 1969

117-231