


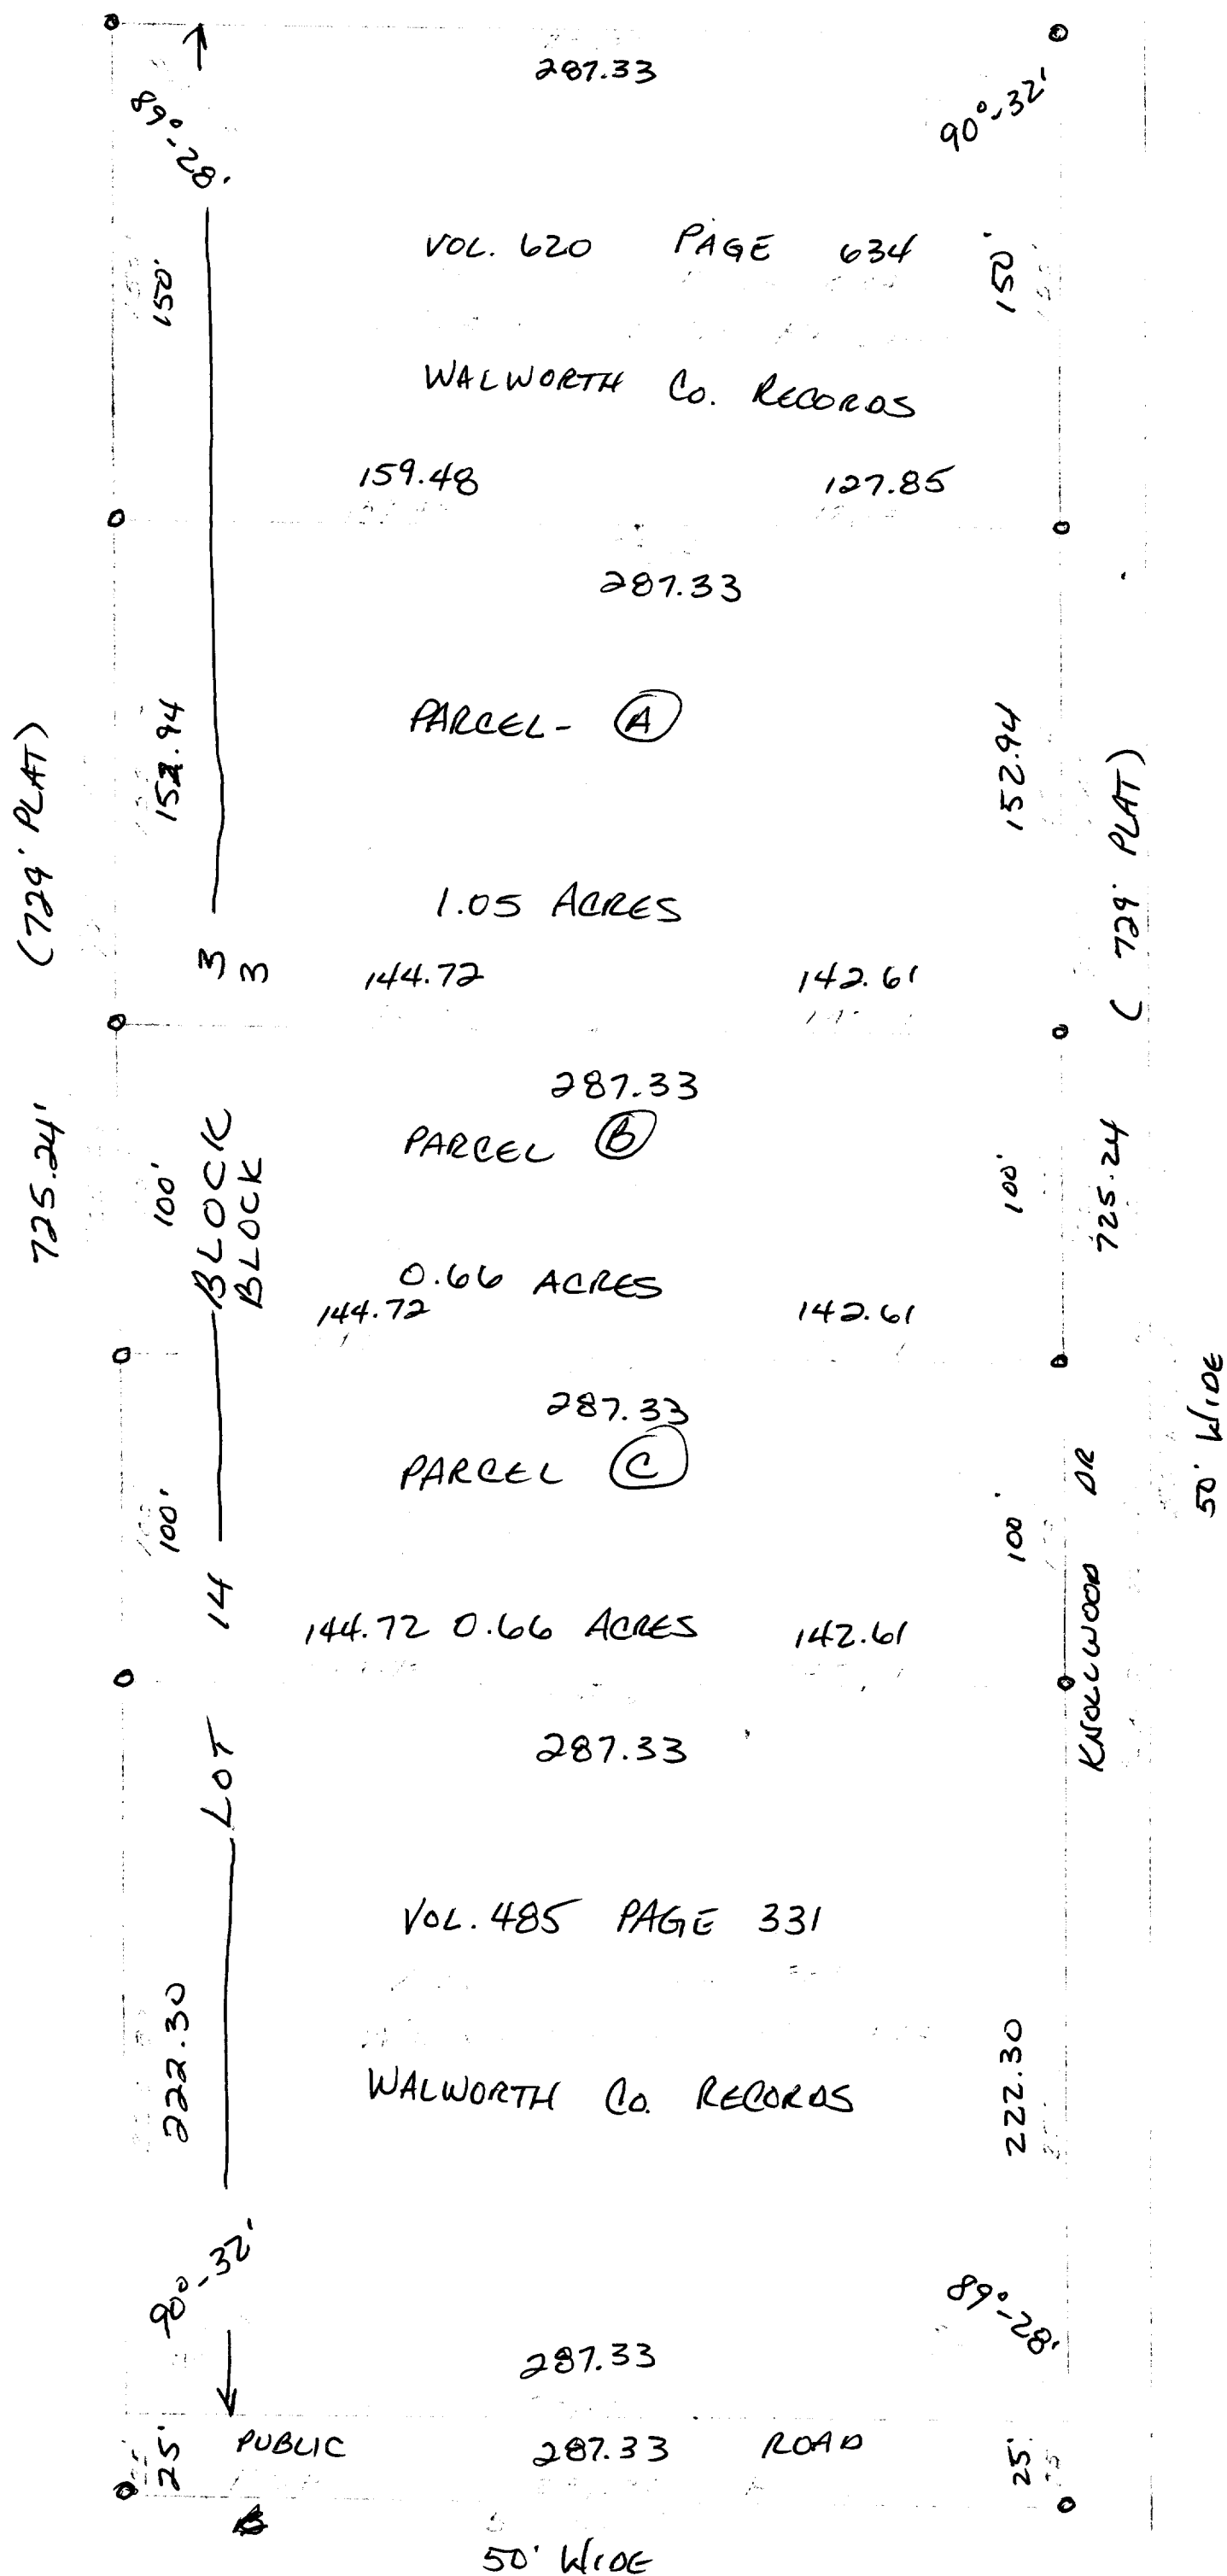

NOTE: Duplicate DIMENSIONS
ADDED BY THIS OFFICE
07/31/98 - ORIGINAL
WOULD NOT COPY

CIC

Part of Lot 14, BLK 3
ROWENA PARK, SECTION 5
T1N, R1E WALWORTH
COUNTY WISCONSIN

PLAT OF SURVEY OF

0 - IRON STAKE

Clayton S. Jensen
SURVEYOR

SCALE 1" = 50'

DATE Aug 1966

IRP 41 + IRP 42 + 43 + 44

117 - 232.1