

ABERNATHY and ASSOCIATES


Kenneth B. Abernathy Jr.

Wisconsin Registered Land Surveyor S-1594

W4056 BRAY RD.
ELKHORN, WI. 53121
PHONE: (262) 723-4260 (OFFICE)
(262) 723-7209 (FAX)
Email: abernathy@elknet.net

PLAT OF SURVEY


LOTS 7 THROUGH 11 AND LOTS 19 THROUGH 24, BLOCK 2, MAPLE HILLS "A" SUBDIVISION, LOCATED IN SECTION 18, TOWN 1 NORTH, RANGE 17 EAST, LINN TOWNSHIP, WALWORTH COUNTY, WISCONSIN.

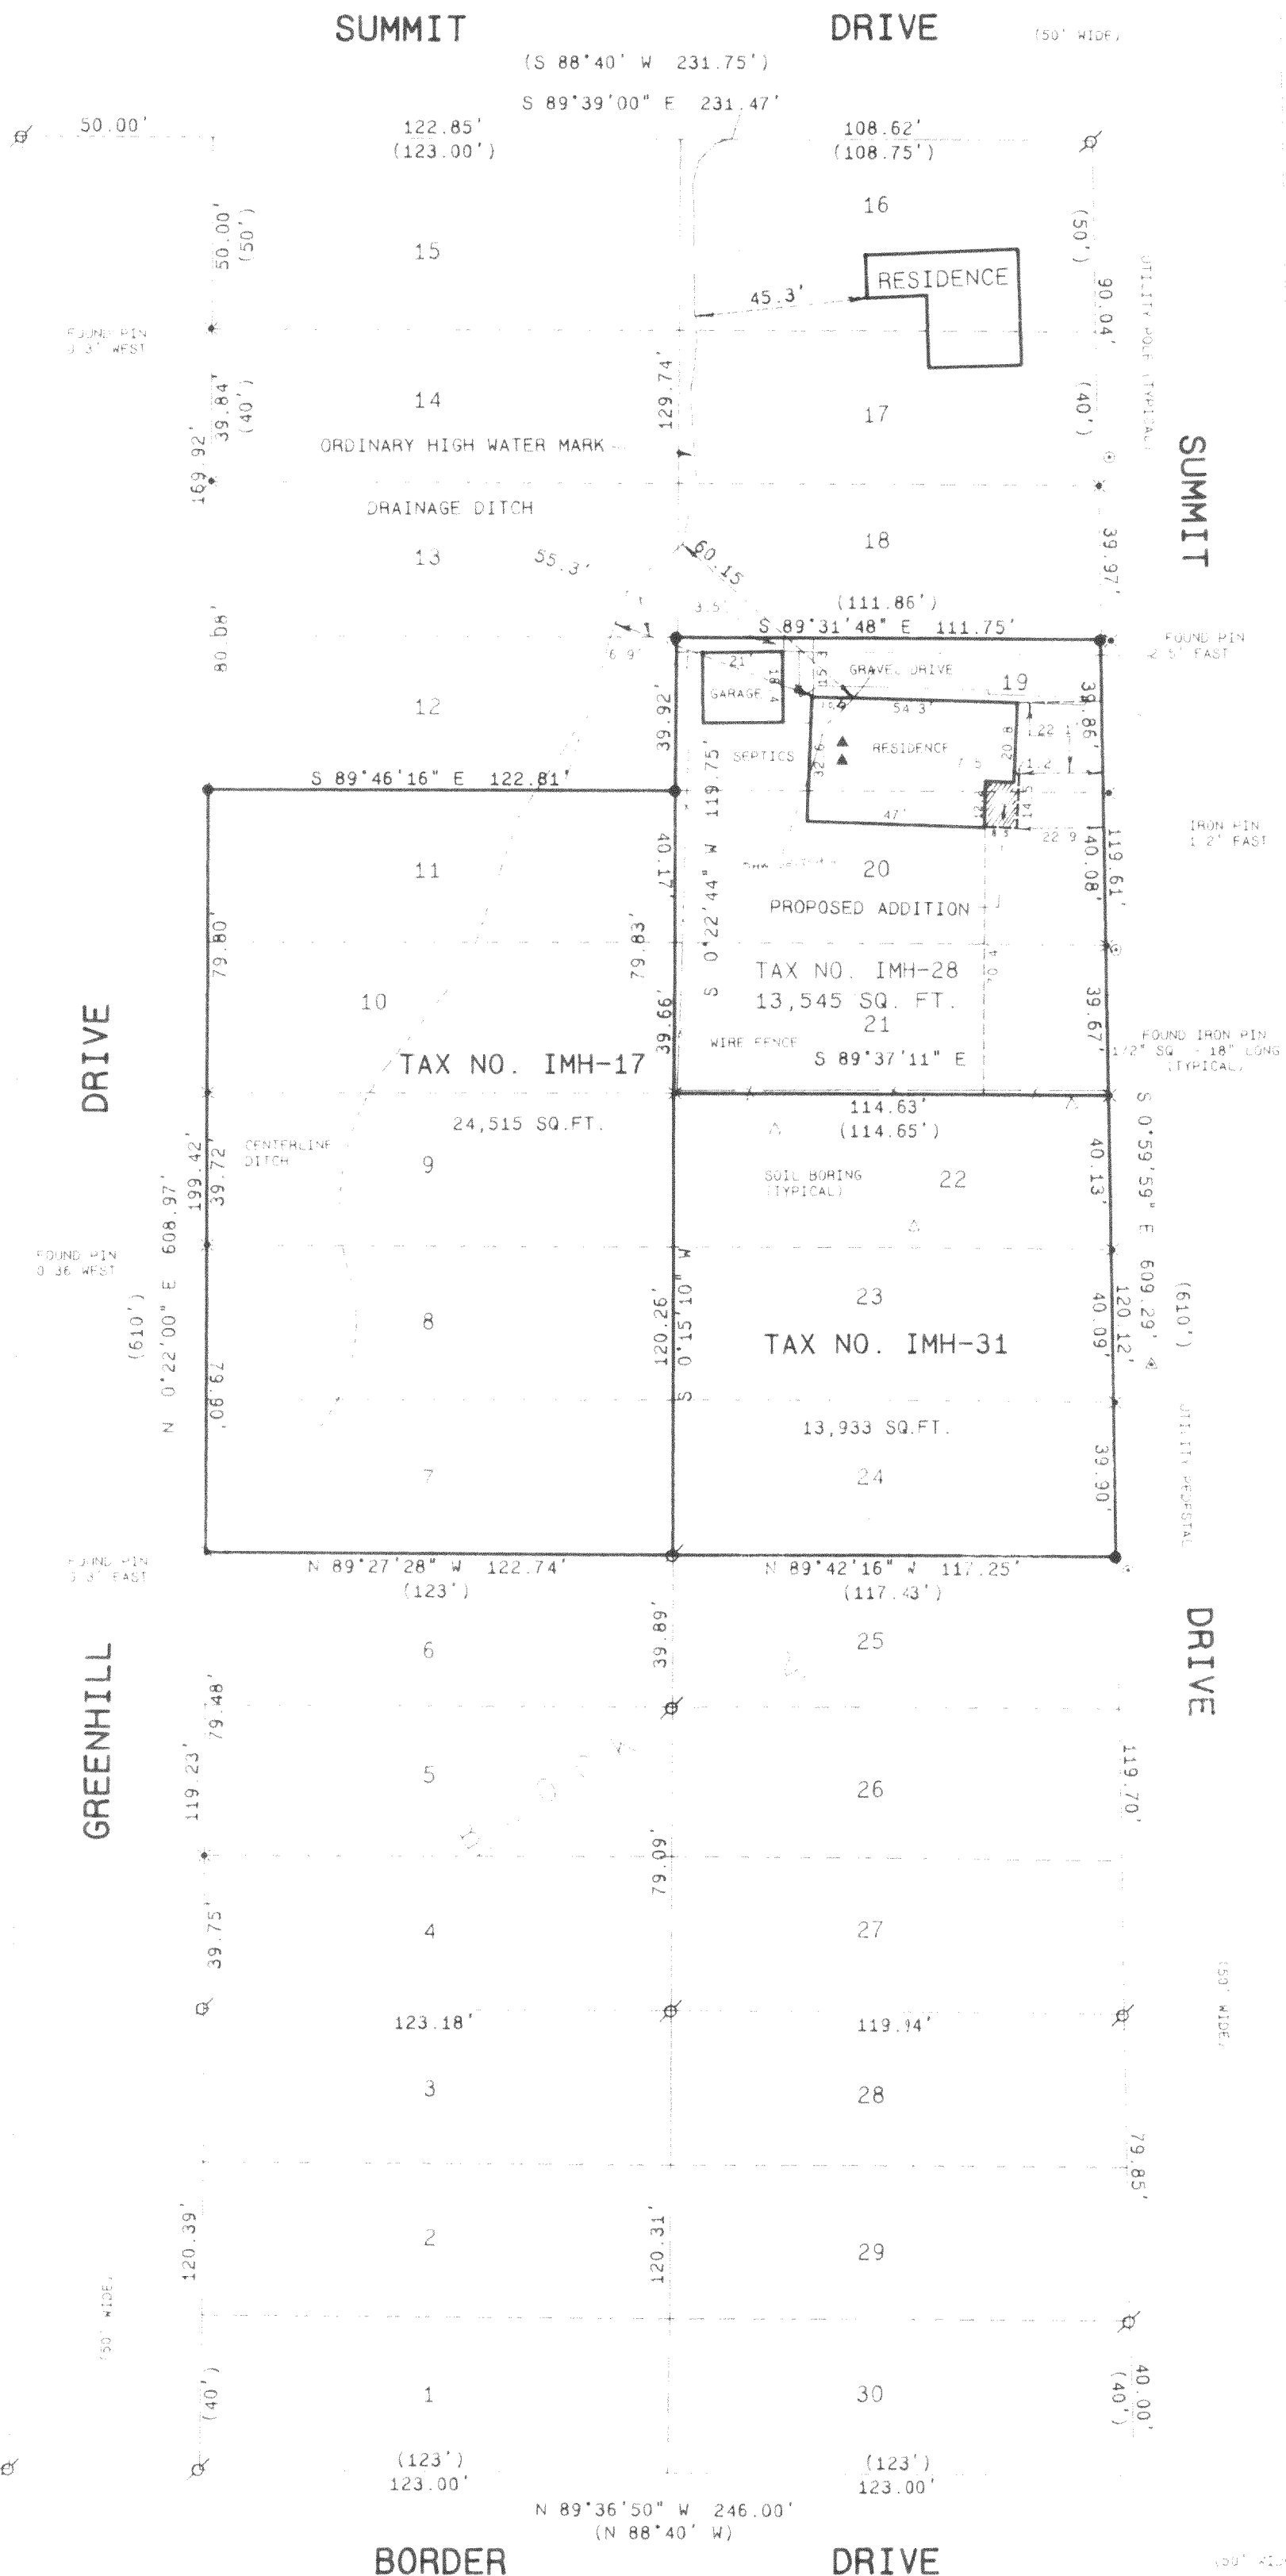

AVERAGE DRAINAGE DITCH SETBACK

LOTS 16-18 45.3'
LOTS 19-21 75'

AVE = 60.15'

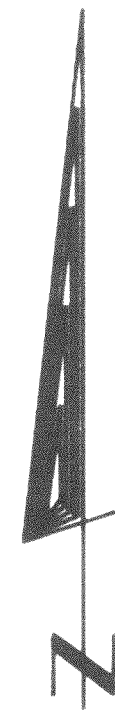

SCALE: 1 INCH = 40 FEET

OWNER: BRYON CROWLEY
412 WEST PALATINE RD.
ARLINGTON HEIGHTS, IL 60004

NOTES

1. WATER IS SUPPLIED VIA UNDERGROUND PIPES FROM A WELL AT A RESIDENCE ON LOTS 25-26, BLOCK 2, AS PER OWNER.
2. SEPTIC TANKS ARE LOCATED IN A CRAWL SPACE OF THE HOUSE AS NOTED (AN ACCESS DOOR PROVIDES ACCESS FOR MAINTENANCE).

Legend

- FOUND IRON PIPE
- FOUND IRON ROD
- FOUND BRASS CAPPED MONUMENT
- FOUND CONCRETE MONUMENT
- CHISEL CUT IN CONCRETE
- SET IRON ROD, 24" LONG, WEIGHING 1.5 LBS. LINEAL FT., 3/4" DIA.
- SET IRON ROD, 30" LONG, WEIGHING 4.5 LBS. LINEAL FT., 1 1/4" DIA.
- RECORDED AS DIMENSION
- EXISTING FENCE




SCALE: 1" = 40 FEET

I hereby certify that the above described property has been surveyed by me in order my direction and that the above map is a true representation thereof and shows the location of the property as a whole, boundaries, the location of all visible structures, and dimensions of all principal buildings, thereon, boundary lines, easements, roadways, and visible encroachments, if any.
This survey is made for the use of the present owners of the property, and also the several parties to this map, and I guarantee the correctness of the same for one year from the date hereof.

Kenneth B. Abernathy, Jr.

KENNETH B. ABERNATHY, JR.
WISCONSIN REGISTERED LAND SURVEYOR,
S-1594

Date: 10/21/2002 Job No. 02-1002

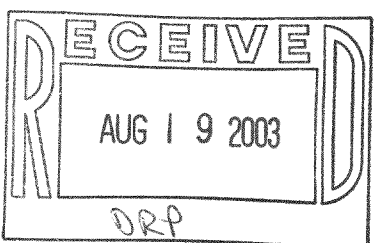

IMH-17
IMH-28
IMH-31

REVISED APRIL 3, 2003

117-2321