


HAROLD H. KOLB
 REGISTERED PROFESSIONAL LAND SURVEYOR
 STATE OF WISCONSIN
 NO. 100000, EXPI. 12-31-70

GENEVA LAKE

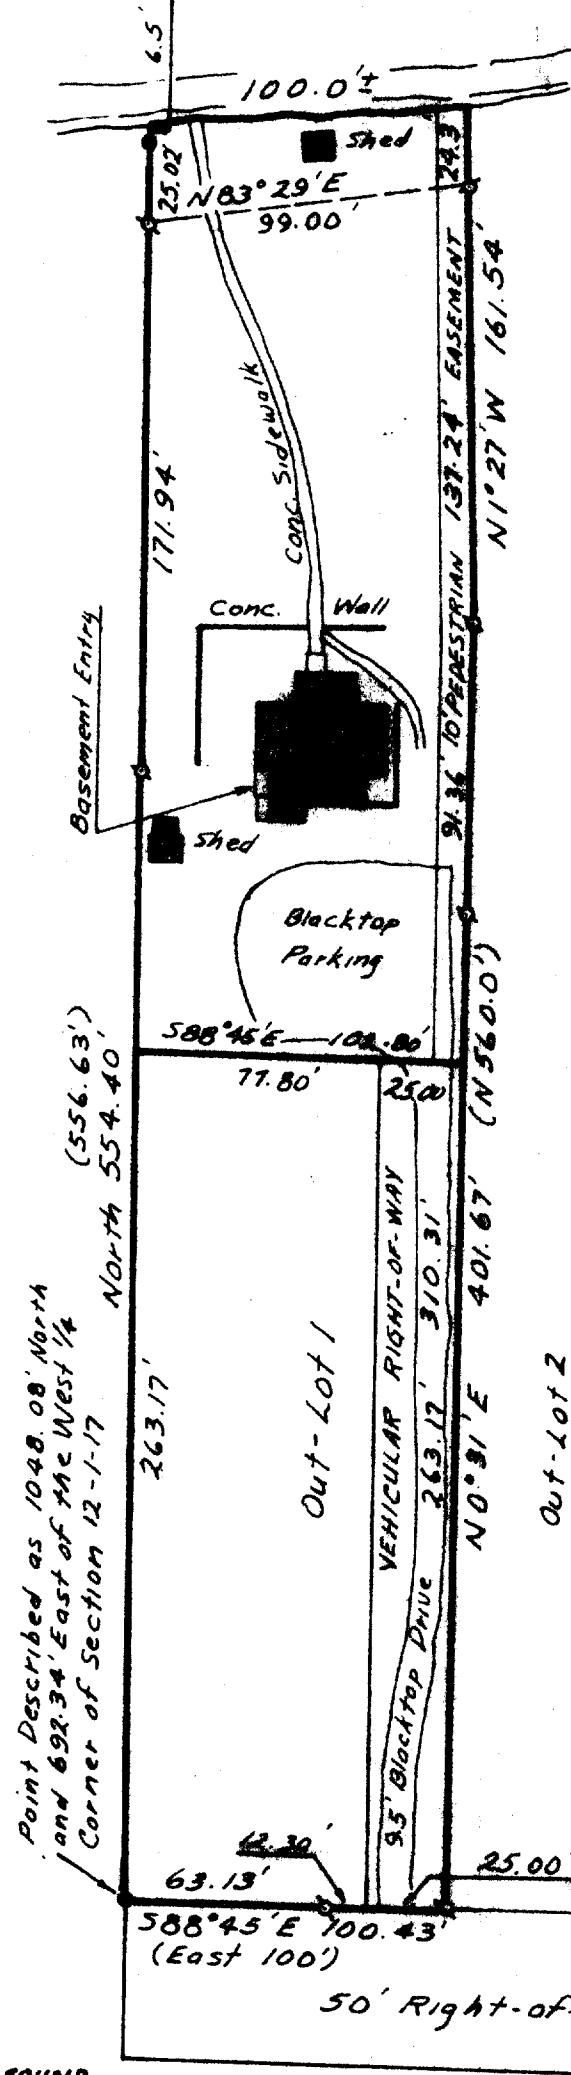

I, HAROLD H. KOLB, do hereby certify that I have surveyed the property hereon described according to the official records, and that the plat hereon is a correct representation of the lot lines and the lines of all visible improvements thereon.

Harold H. Kolb
 HAROLD H. KOLB
 DATE: November 1, 1969
 Revised: December 23, 1970



SCALE: 1"=60'

LEGEND

- - IRON PIPE FOUND
- - IRON PIPE PLACED
- - CONCRETE MONUMENT FOUND
- X - SPIKE
- () - Recorded Dist.

Dist. Survey 483

STATE TRUNK HIGHWAY 120

117-237
 2-58