


GENEVA LAKE

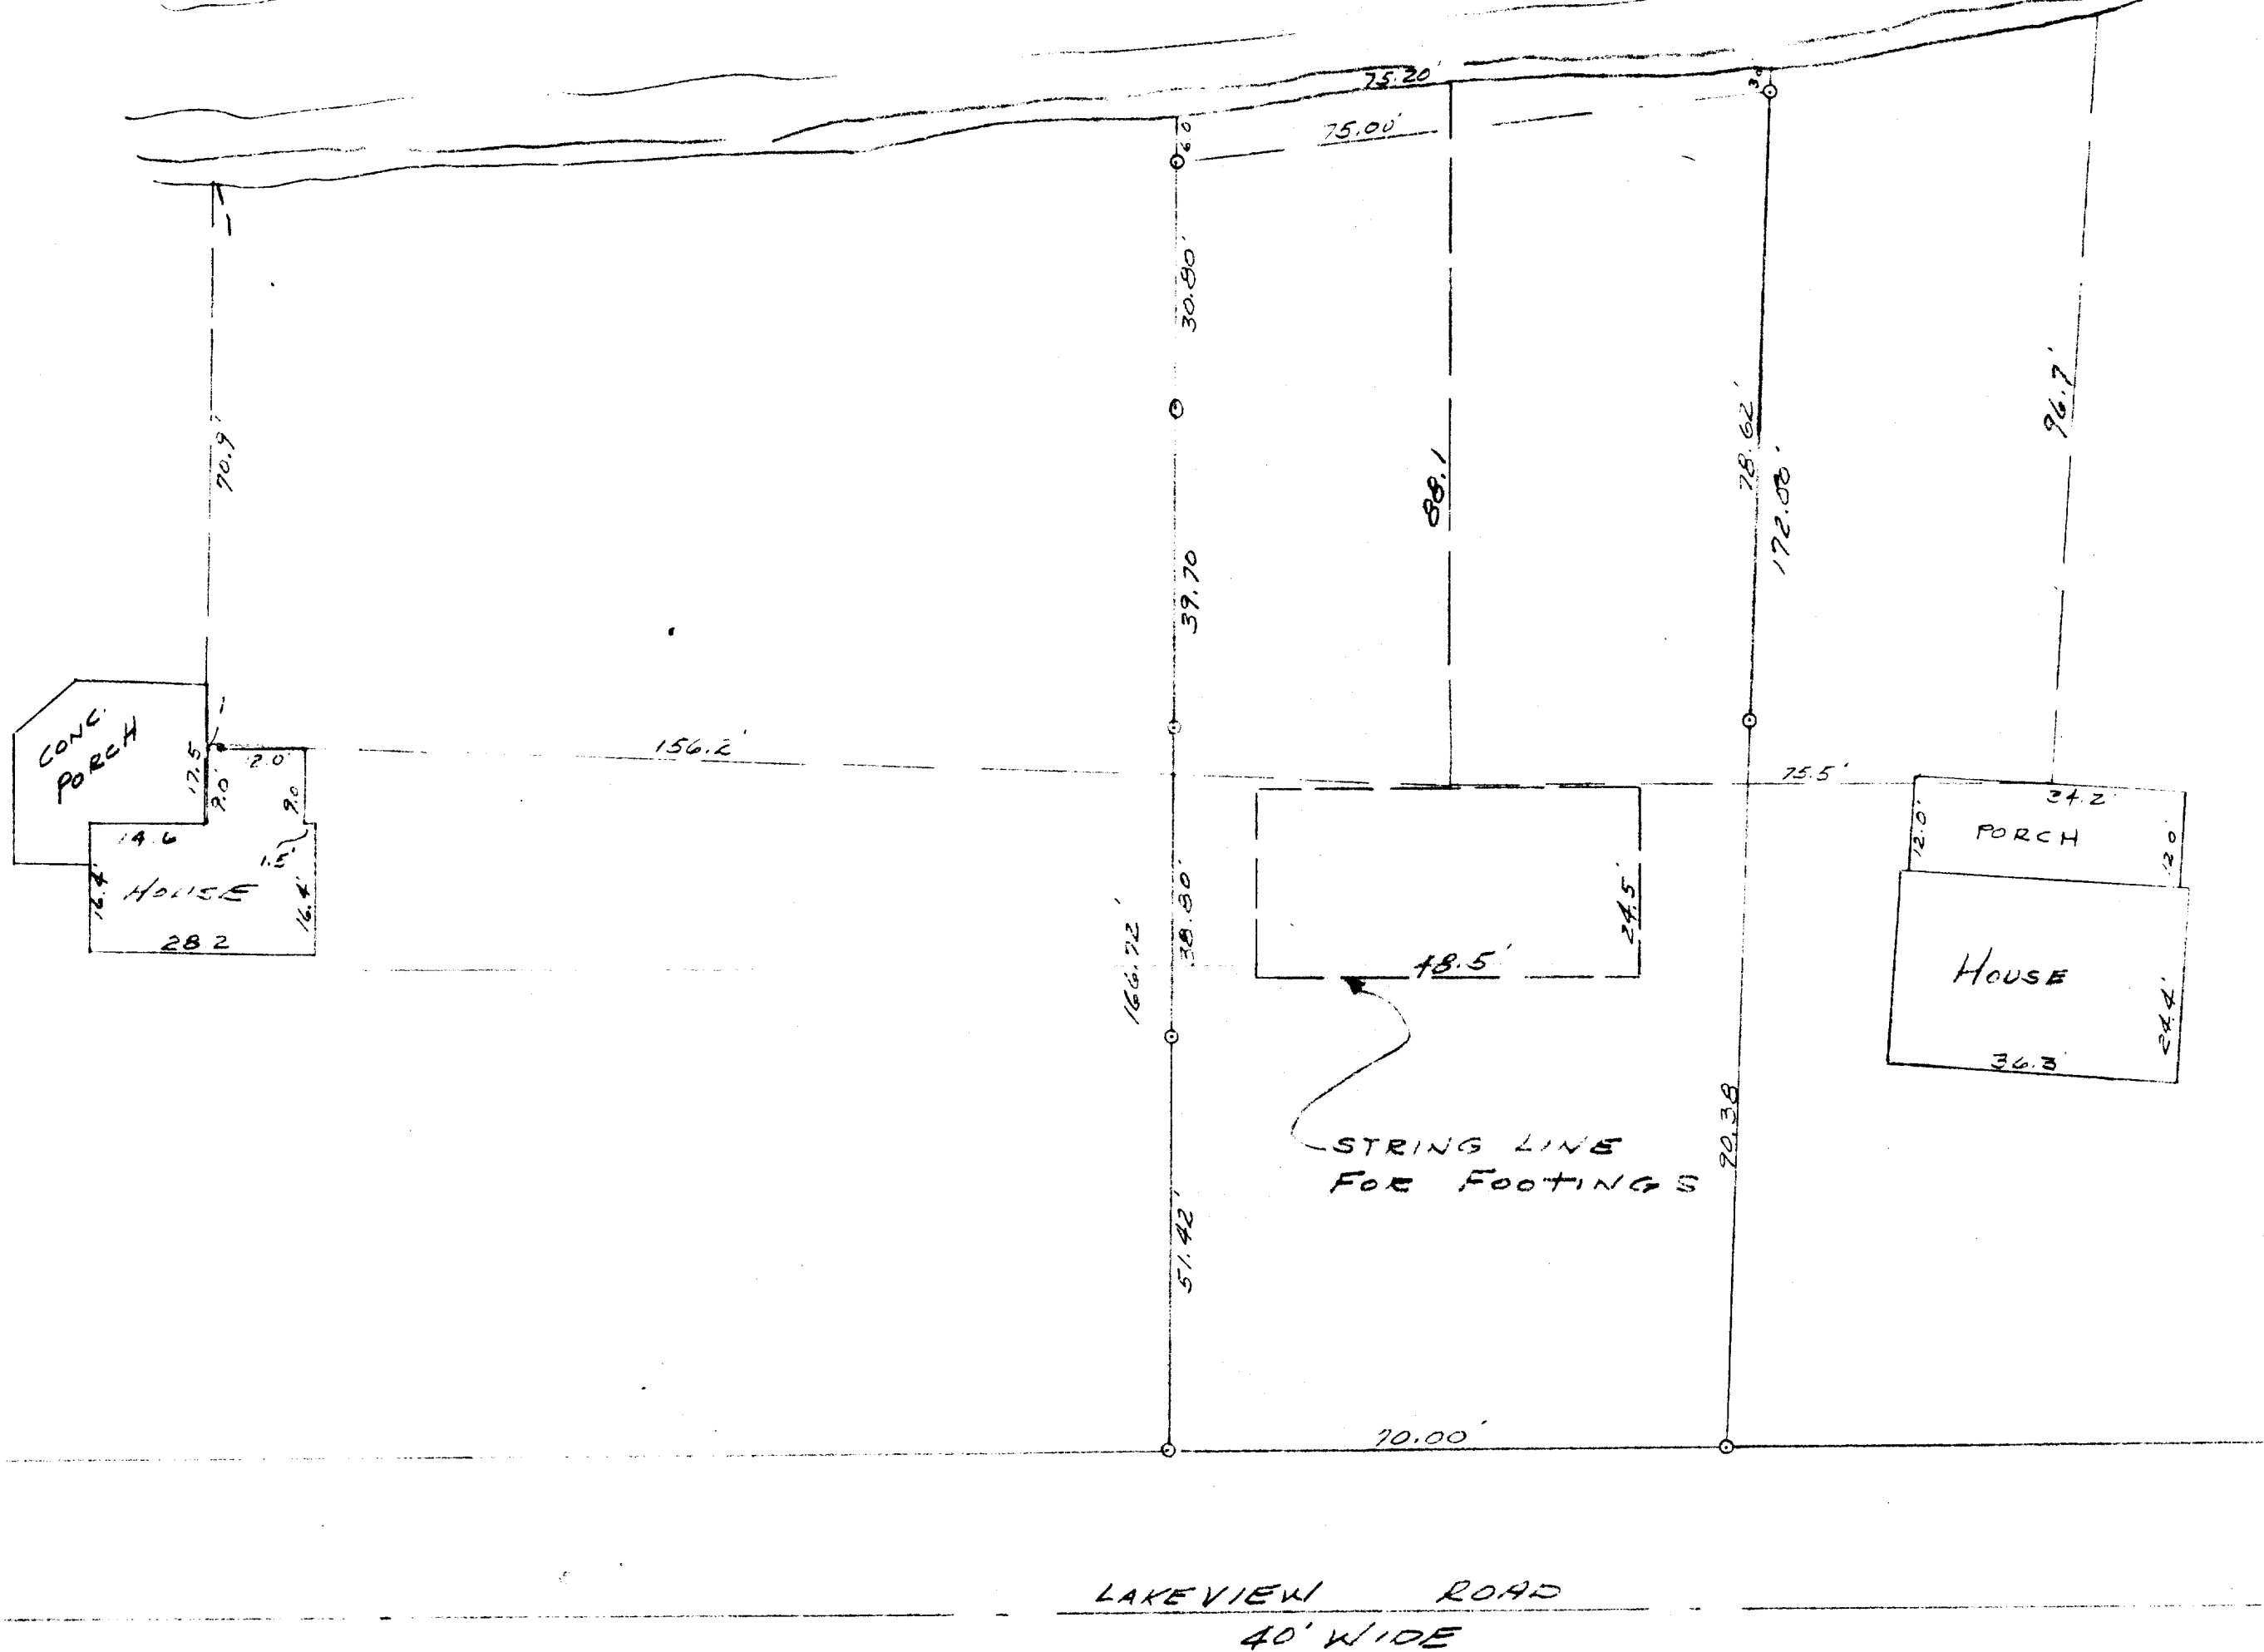

PLAT OF SURVEY OF

LOT 10 BLOCK 1 WOODALE ADDITION
LOCATED IN SECTION-9-T1N-R17E
WALWORTH COUNTY, WISCONSIN
EXCEPT THE EAST 10' THEREOF.

Lloyd S. Jensen
SURVEYOR

SCALE 1" = 20'

DATE Nov 1967

117-239.1