


SCALE 1"=20'
O-IRON PIPE
●-CONC. MONU.

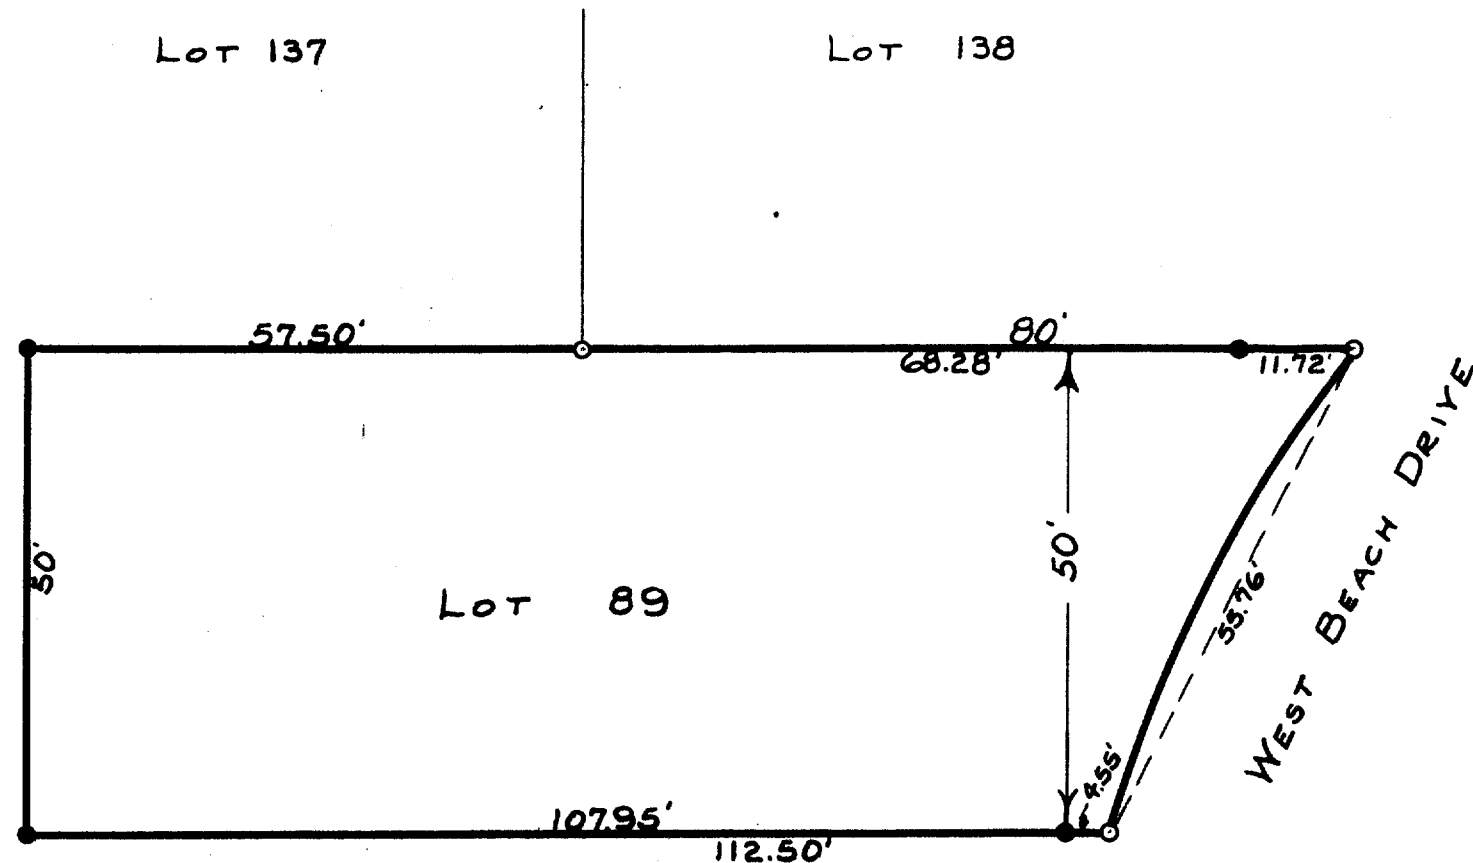

PLAT OF SURVEY OF LOT 89 OF LAKE GENEYA
BEACH SUBD., LOCATED IN SECTION 11, T1N
R17E OF WALWORTH COUNTY, WISCONSIN.

JULY 1944

Lloyd L. Jensen
COUNTY SURVEYOR

166B-80

117-24