


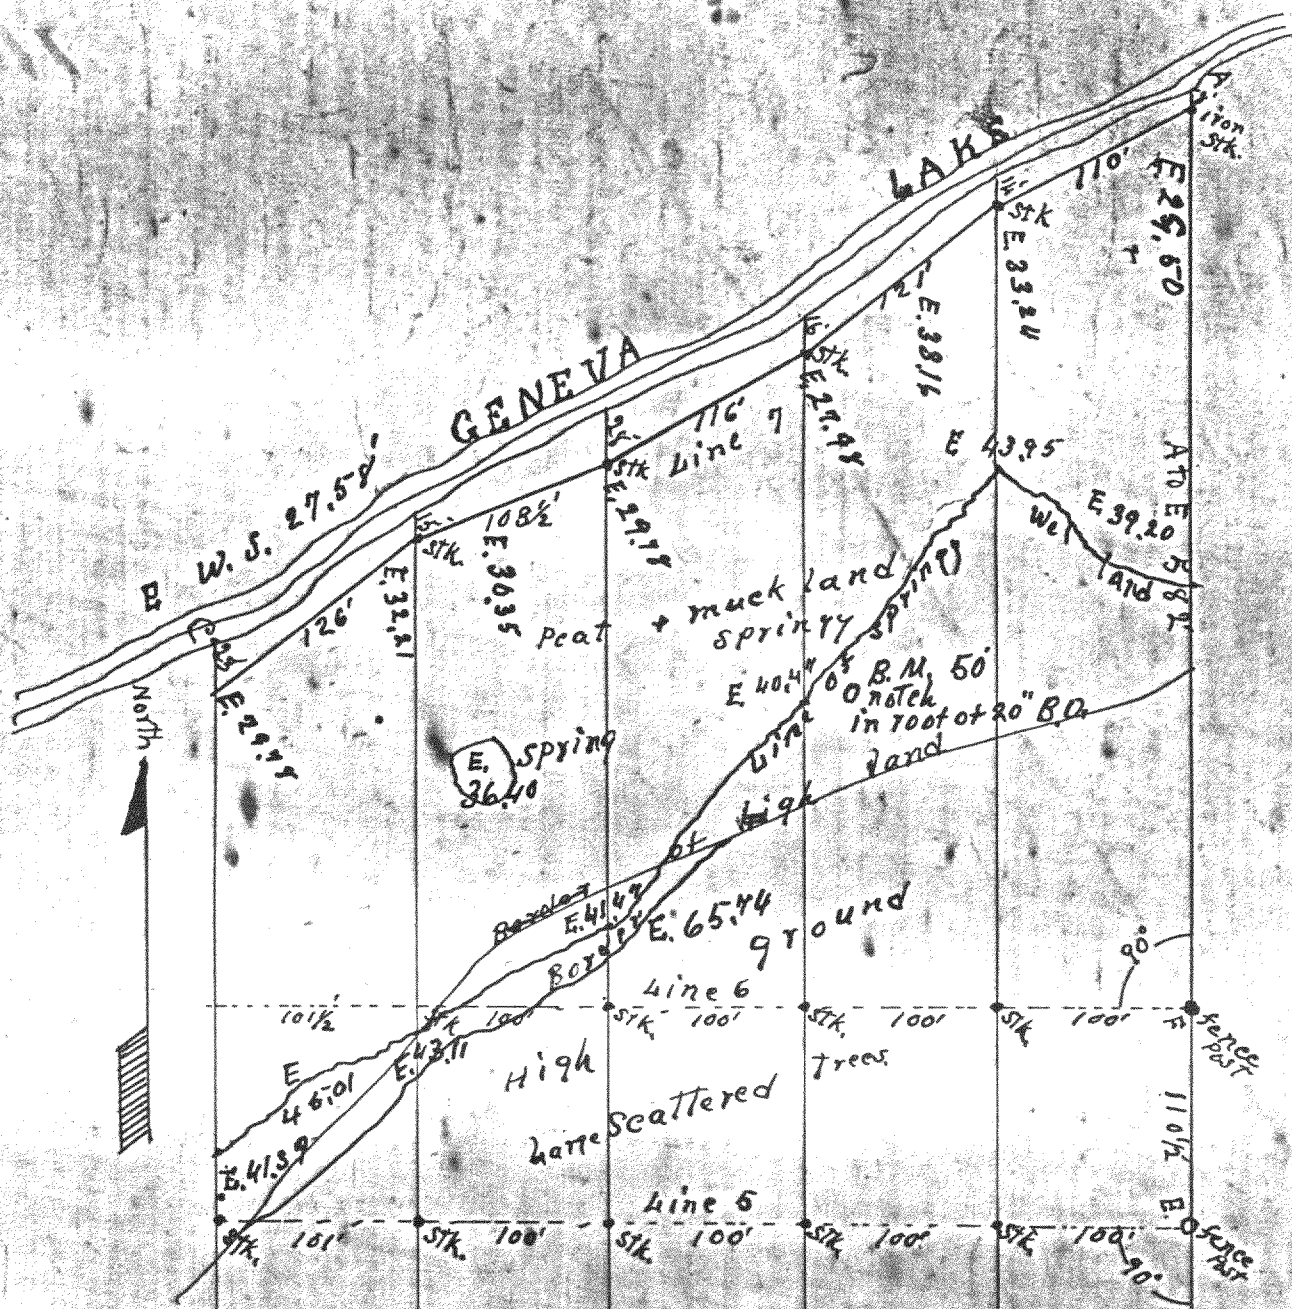

By request of Mrs. Louise Boyd Dickinson, we have surveyed and subdivided the tract of land as hereon shown.

This map correctly represents the survey.

2" by 16" stakes are set at all points marked "Stk."

Said contains 20.7 acres more or less.

Lines numbered 1 to 7 are lines of stks.

Lines 1, 2, 5+6 are at rt. angles to the 1/2 line.

All fences are on line except the north part of west line which is 1/2 to 1 1/2' west.

Tract is divided into 5 very desirable lots of equal width.

Sept. 28, 1922 J. G. Skeels, C.E.
Bessie M. Palmer, sur.

Scale 100 to 1" = 500' 1/4 Sect. line 11-1-17

Lot 5

Lot 4

Lot 3

Lot 2

Lot 1

Timber Large Oaks

Total area 20.7 acres

South line of Timber

Line 4

Line 1

Line 2

Line 3

Line 4

Line 5

Line 6

Line 7

Line 8

Line 9

Line 10

Line 11

Line 12

Line 13

Line 14

Line 15

Line 16

Line 17

Line 18

Line 19

Line 20

Chas. Wacker

East 1/2 line

Sect. 11-1-17

339' N to M

199' M to O

204' O to B

204' O to B

204' O to B

204' O to B

W. S. 27.5'

126'

108'

108'

Orchard

Fence on line

Open field

High ground

Large oaks


Public Highway

Water to Lake Geneva

Concrete Pavement

request of Mrs. Louise Boyd
 kinson, we have surveyed and
 divided the tract of land
 shown hereon.
 This map correctly represents the
 survey.
 64/16" stakes are set at all
 points marked "Stk."
 and contains 20.7 acres more
 or less.
 Lines numbered 1 to 7 are
 lines of stks.
 Lines 1, 2, 5 & 6 are at 11
 angles to the 1/8 line.
 All fences are on line except
 the north part of west line
 which is 1/2 to 1 1/2 west
 and is divided into 5
 very desirable lots of
 equal width.

28, 1922 J. G. Skeels, C.E.
 Bessie M. Palmer

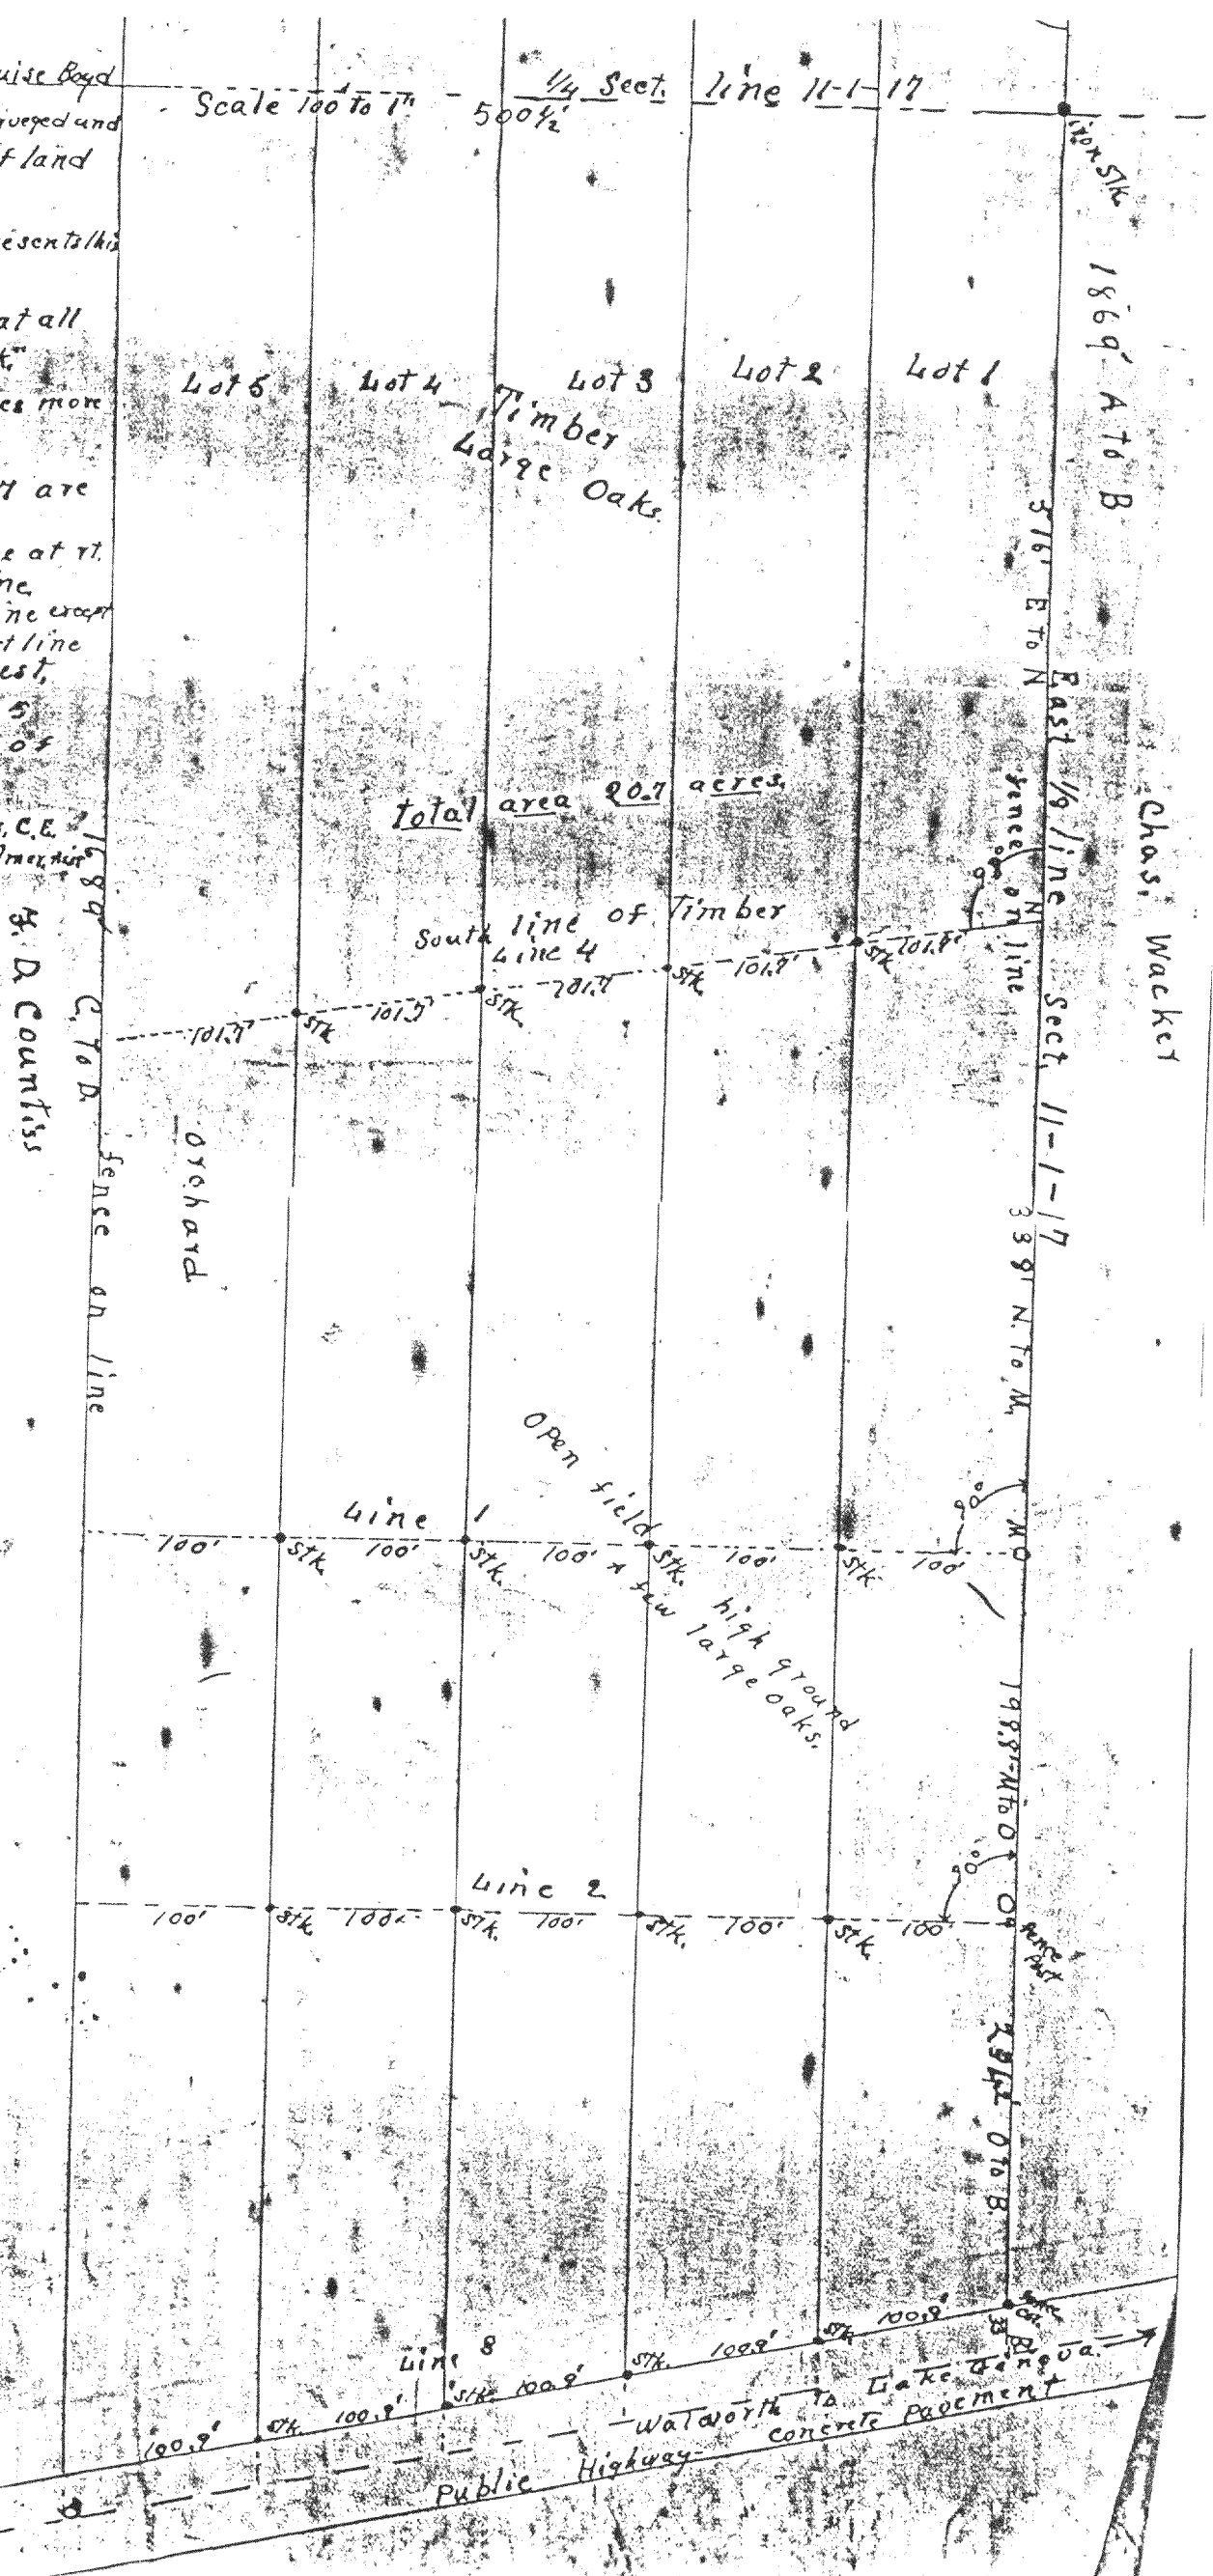

55. May 13+15


re-surveyed line
Dickinson's subdivis-
ion to $2\frac{1}{8}$ line sect. 11
and measured over 200'
required. Set on stk
turned out by and
found old stk at
line N. to lake shore.
ran directly over
No others found.
Set stks at intervals
between Lots 2 & 3.
Slow work thru timber
thicket jungle, very
thick with closet

A. B. Dickinson

between lots 2 & 3.
ion. Set line at rt L's
T. 1 N. R. 17 E. L. 11 N. W. 1/4
and set stake on line
at end of line. and sighted
sighted South road fence,
road fence, continued
Opp. Kimball house line
another old stk.

all along the line,
on account of how
dense,
is nearly all on lot 2.


Line between L-11-6 and L-11-4, L-11-5 + L-11-7

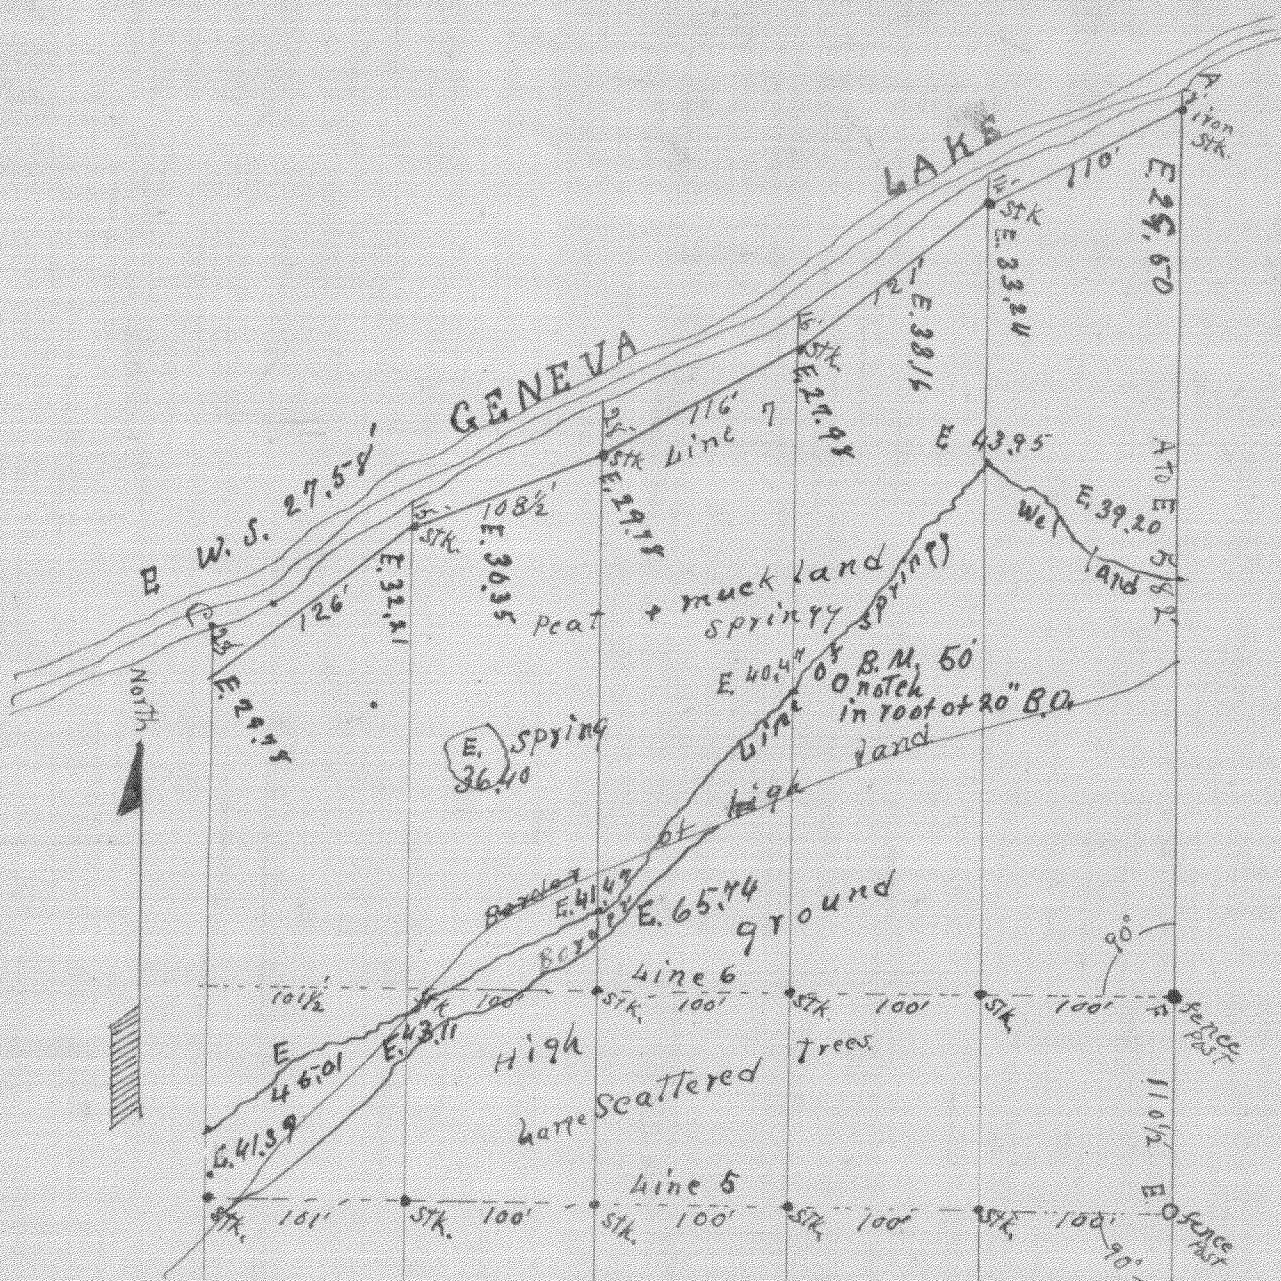

By request of Mrs. Louise Boyd Dickinson, we have surveyed and subdivided the tract of land as hereon shown. This map correctly represents the survey. 2" by 16" stakes are set at all points marked "Stk." Said contains 20.7 acres more or less. Lines numbered 1 to 7 are lines of stks. Lines 1, 2, 5 & 6 are at rt. angles to the 1/2 line. All fences are on line except the north part of west line which is 1/2 to 1 1/2 west. Tract is divided into 5 very desirable lots of equal width.

Sept. 28, 1922 J. G. Skeels, C.E.
Bessie M. Palmer, sur.

Scale 100' to 1" 1/2
G. D. Countiss
1689' C to D fence on line
Orchard

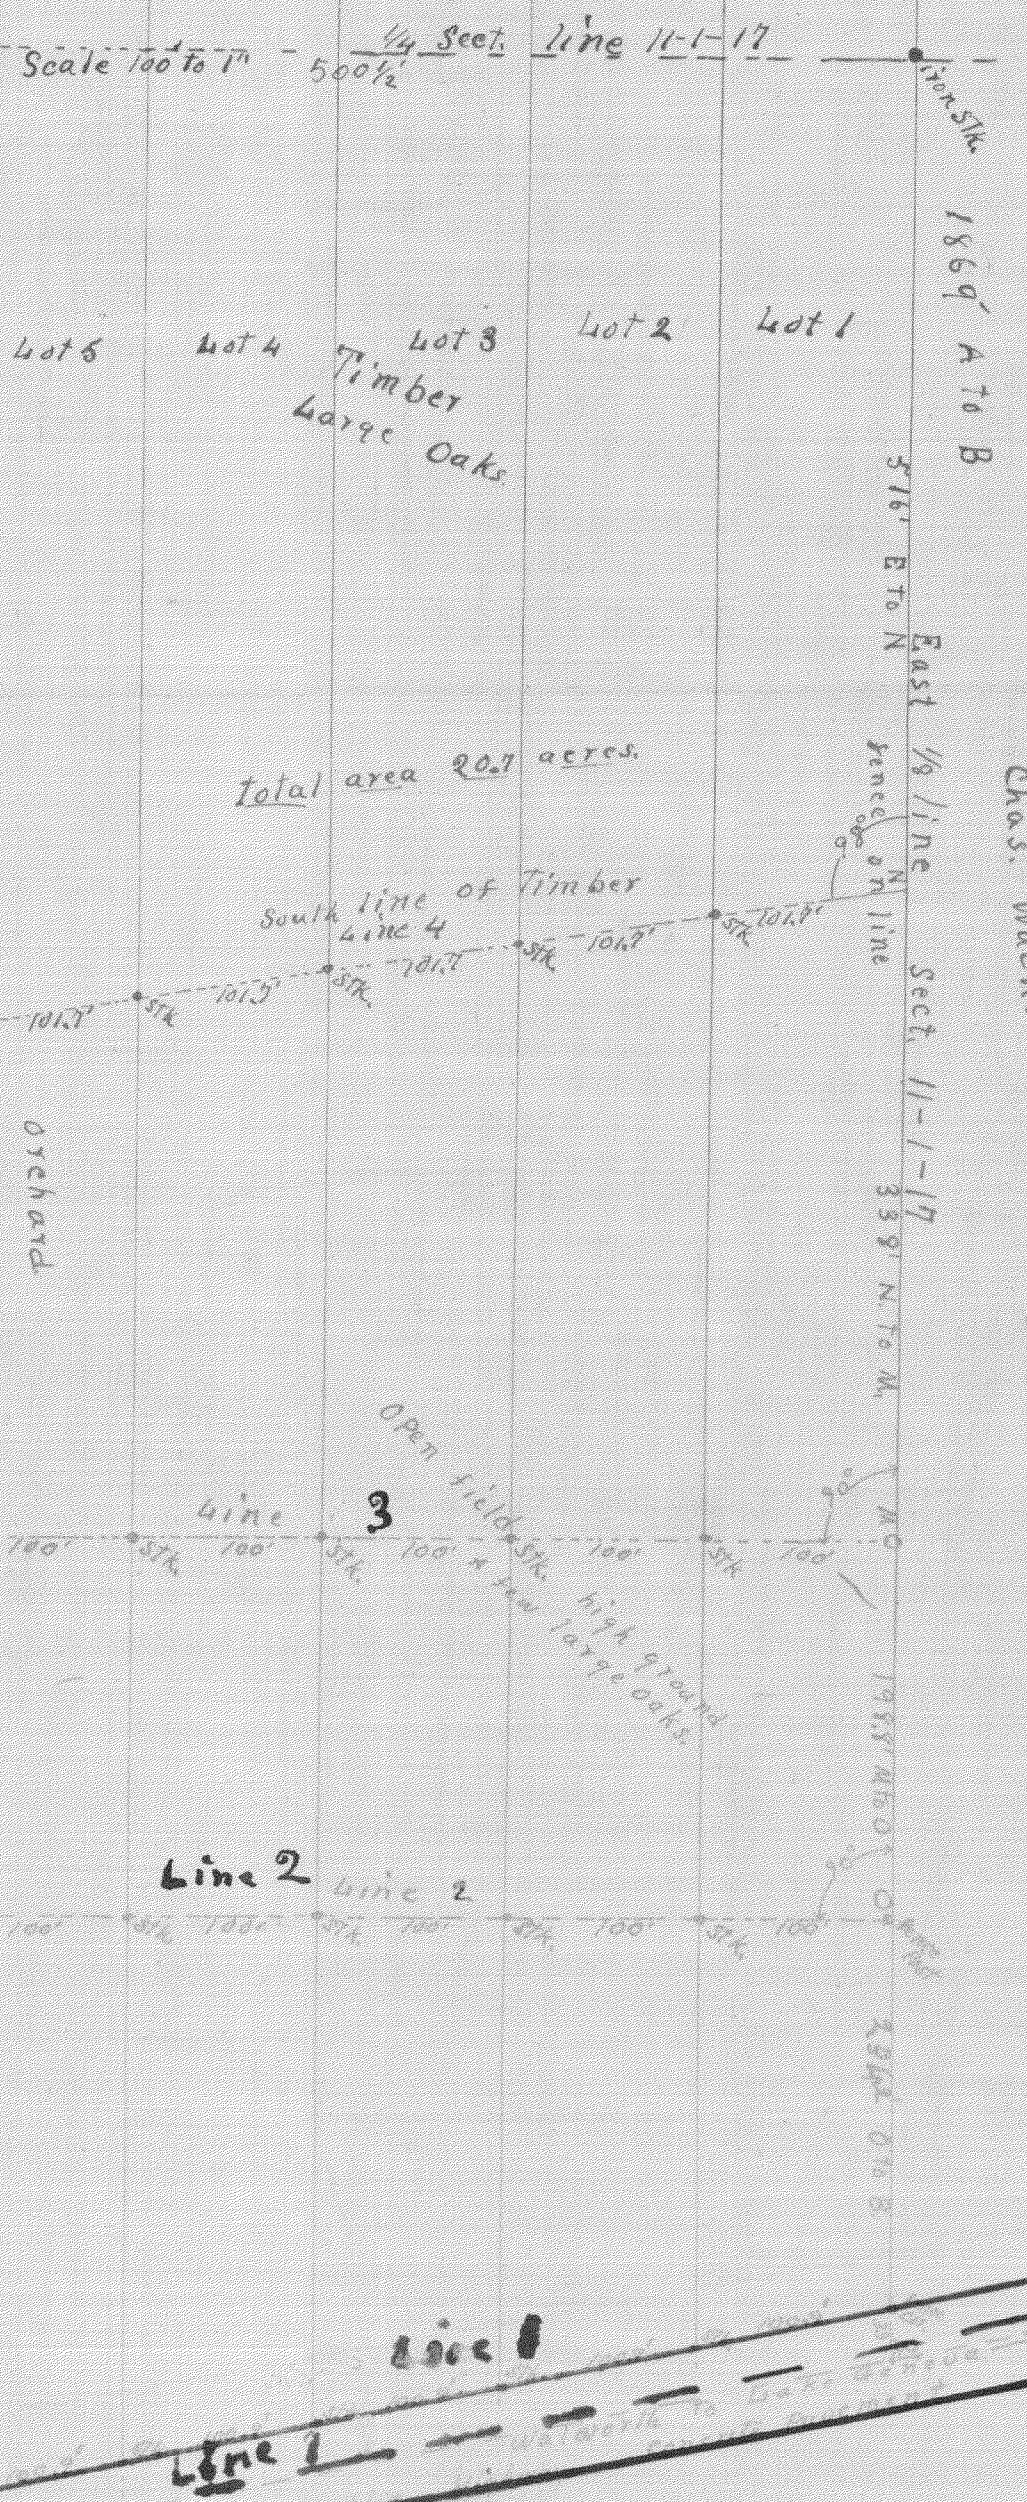

Scale 100' to 1" 1/2
line 11-1-17
1869' A to B
316' E to N
East 1/2 line
Sect. 11-1-17
339' N to M.
Chas. Mackey
Total area 20.7 acres.
South line of Timber
line 4
line 3
line 2
line 1
Open field
High ground
Scattered Trees
B.M. 50' in root of 20" B.O. land
1985' M to O
2914' O to B
1985' M to O
2914' O to B
1985' M to O
2914' O to B