



112-292.1

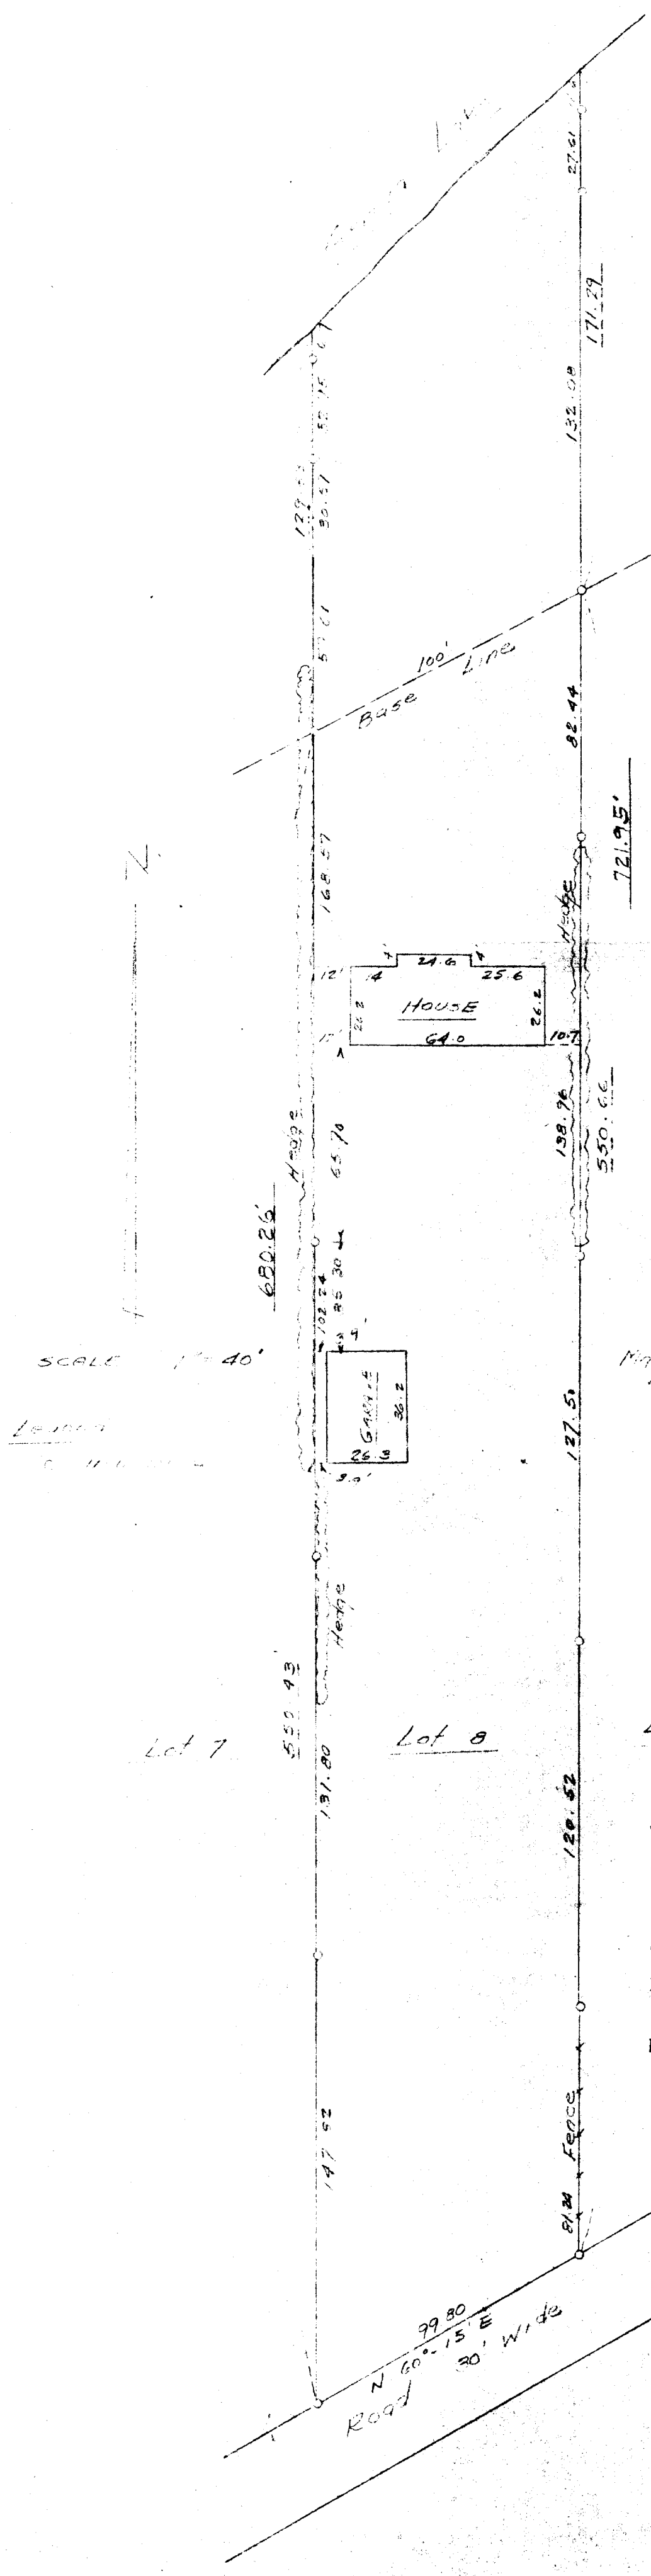

Lot 9 - The Brakes
Section 10, T1N R1E,
Walworth County, Wisconsin

May 7, 1966

Lloyd L. Jensen
Lloyd L. Jensen
County Surveyor

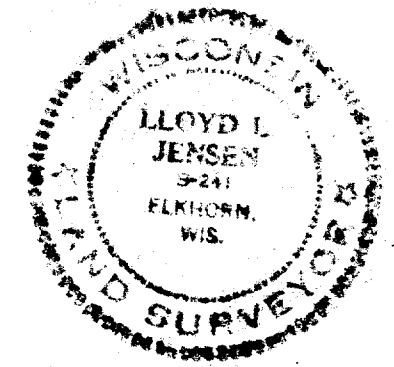

Lot 9

I hereby certify that I have surveyed the above described property and that the plat shown hereon is an accurate survey and a true representation thereof and correctly shows the exterior boundary lines and location of buildings located thereon.

May 9, 1966

Lloyd L. Jensen
Surveyor