


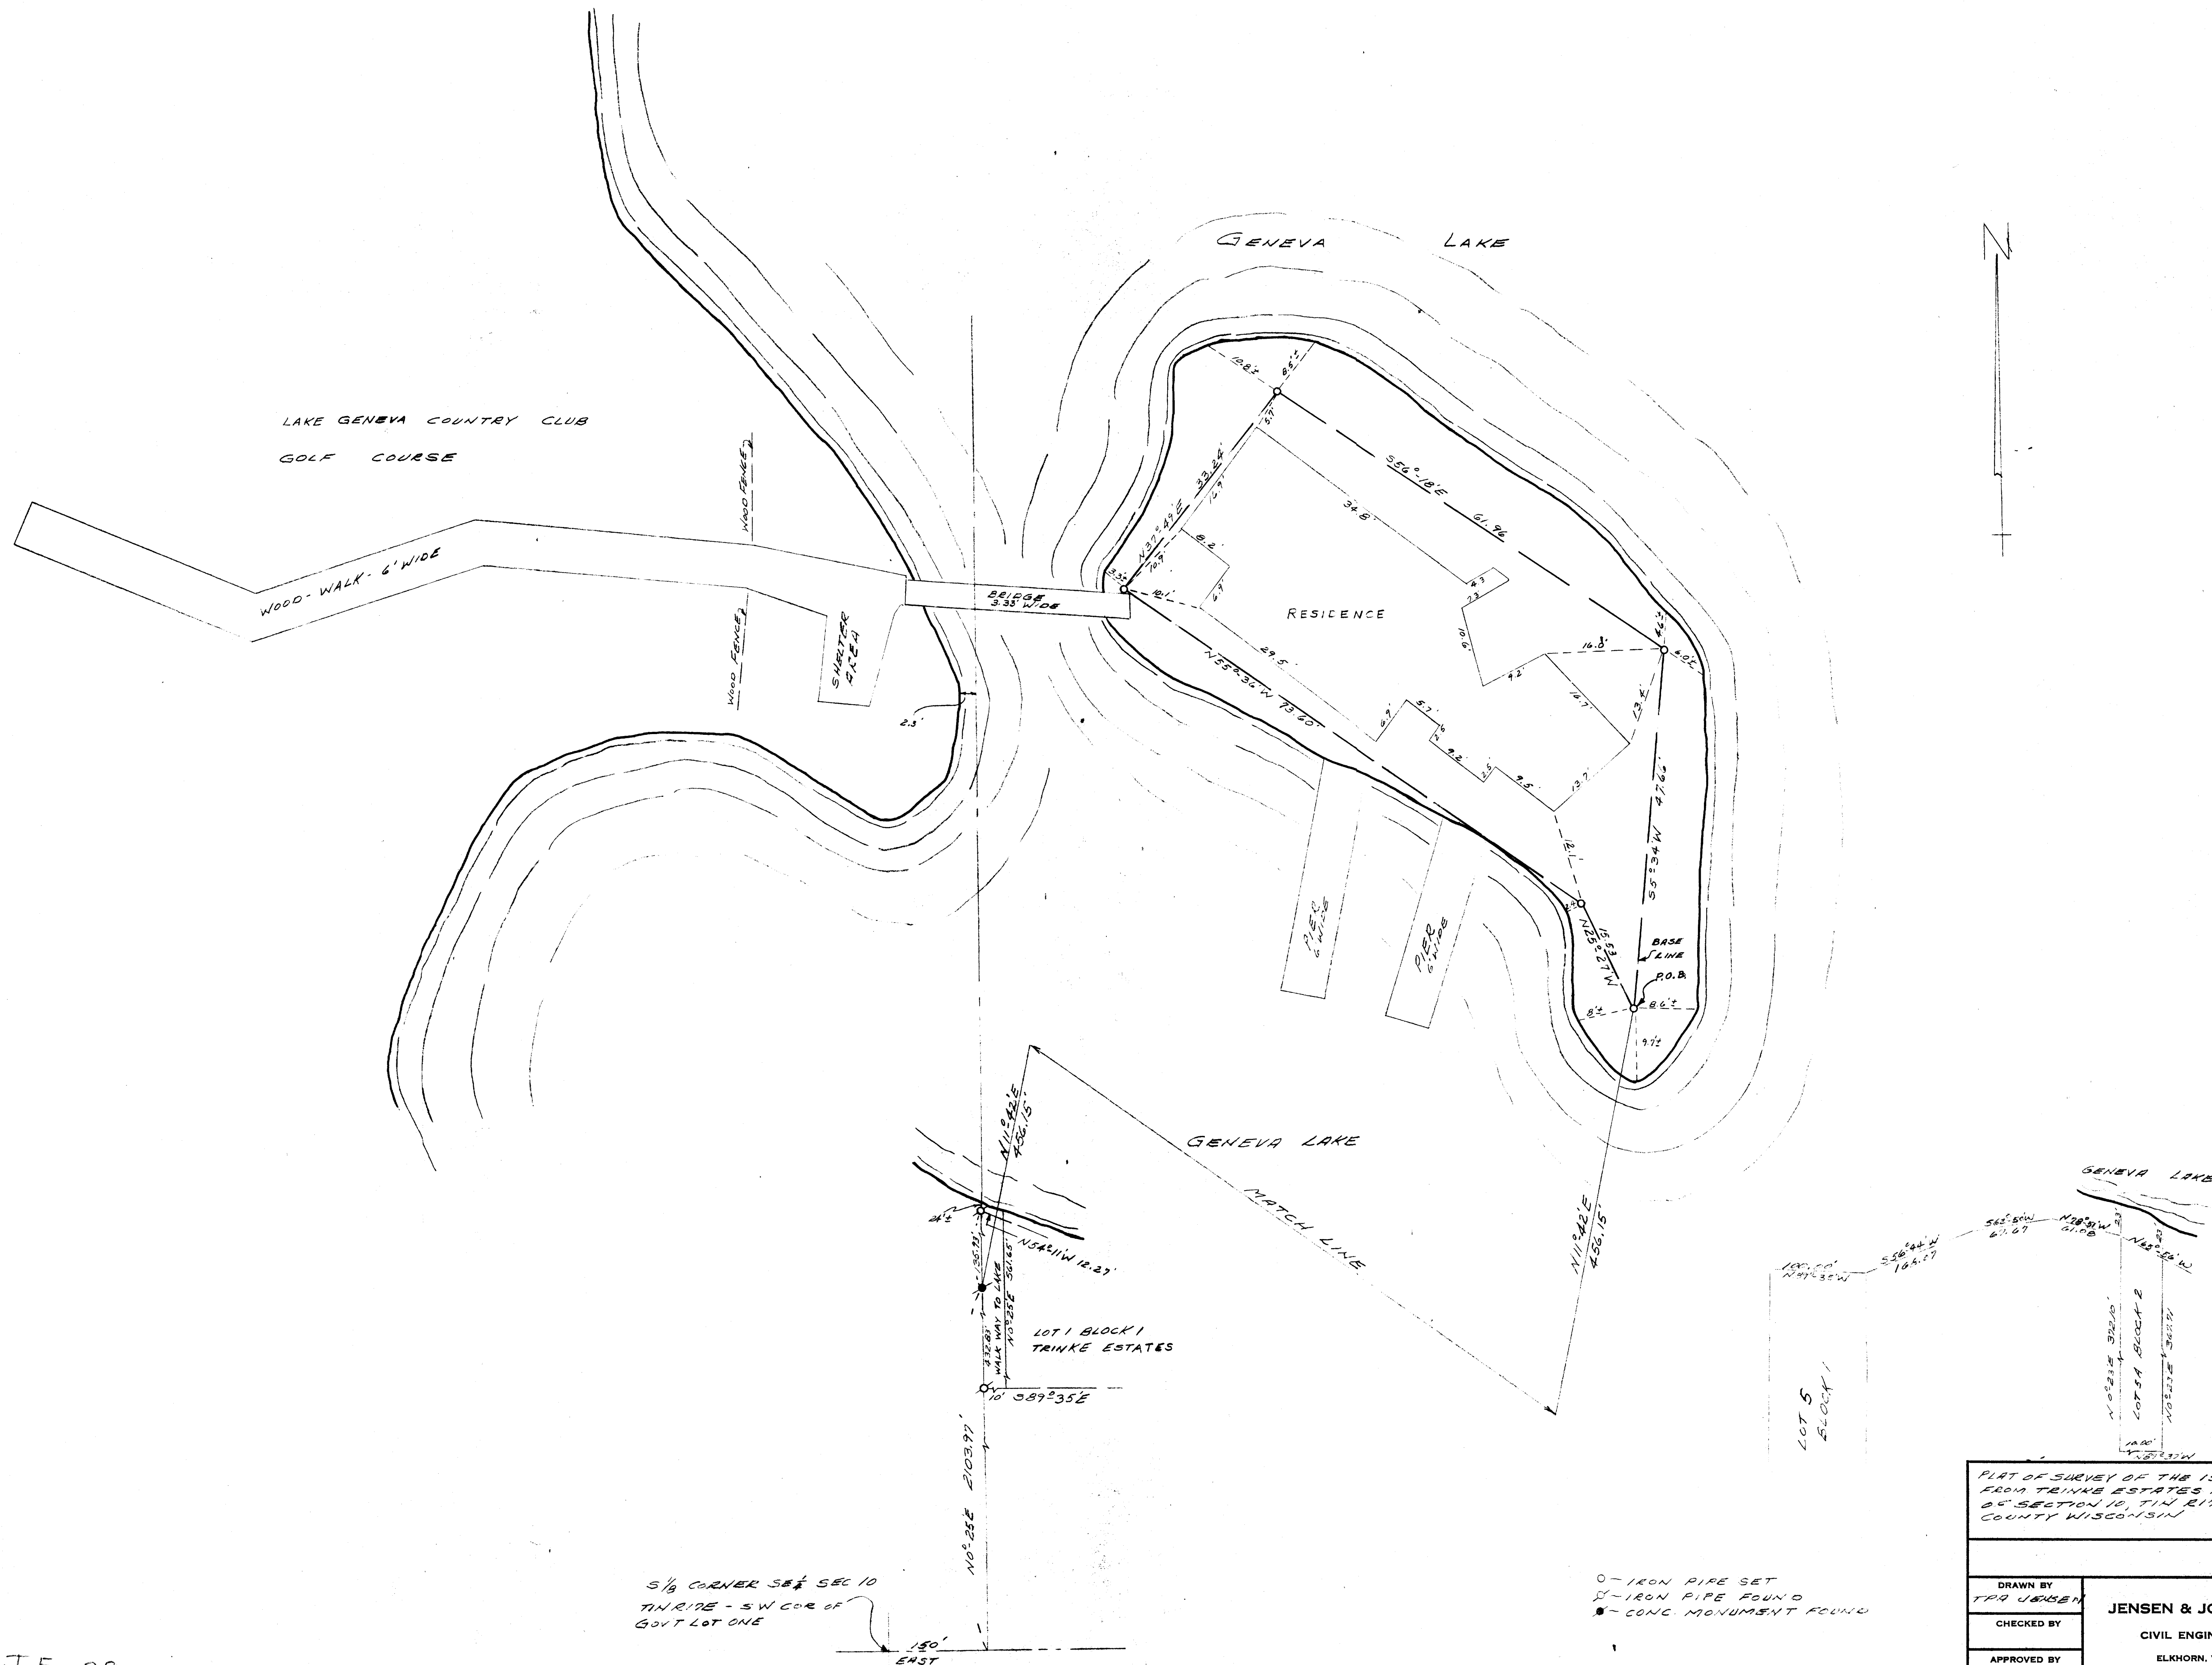

PLAT OF SURVEY OF THE ISLAND OFF SHORE FROM TRINKE ESTATES IN THE SE 1/4 1/4 OF SECTION 10, T1N R1E W1/4 NORTH COUNTY WISCONSIN

DRAWN BY TPA JENSEN	JENSEN & JOHNSON CIVIL ENGINEERS ELKHORN, WIS. DATE NOV 67	SCALE: 1" = 10'
CHECKED BY		REVISED
APPROVED BY		SHEET NO. 1 OF 1

ITE-38