

PREPARED FOR:
COLDWELL BANKERS PRIMUS
c/o DEBBIE COBIAN
226 BROAD STREET
LAKE GENEVA WI
53147



RIPARIAN RIGHTS LINES
BY
KNITTER METHOD

J.K. SURVEYING INC.
N3705 WILLOWBEND LANE
LAKE GENEVA, WI, 53147
262-248-3697

RIPARIAN RIGHTS SURVEY

- OF -

OUTLOT 1 OF CERTIFIED SURVEY MAP NO. 781, LOCATED IN THE
EAST 1/2 OF SECTION 11, TOWN 1 NORTH, RANGE 17 EAST,
TOWN OF LINN, COUNTY OF WALWORTH AND STATE OF WISCONSIN.

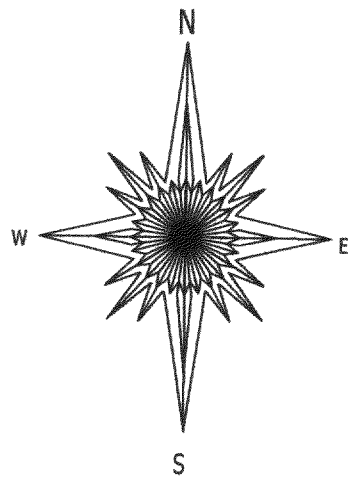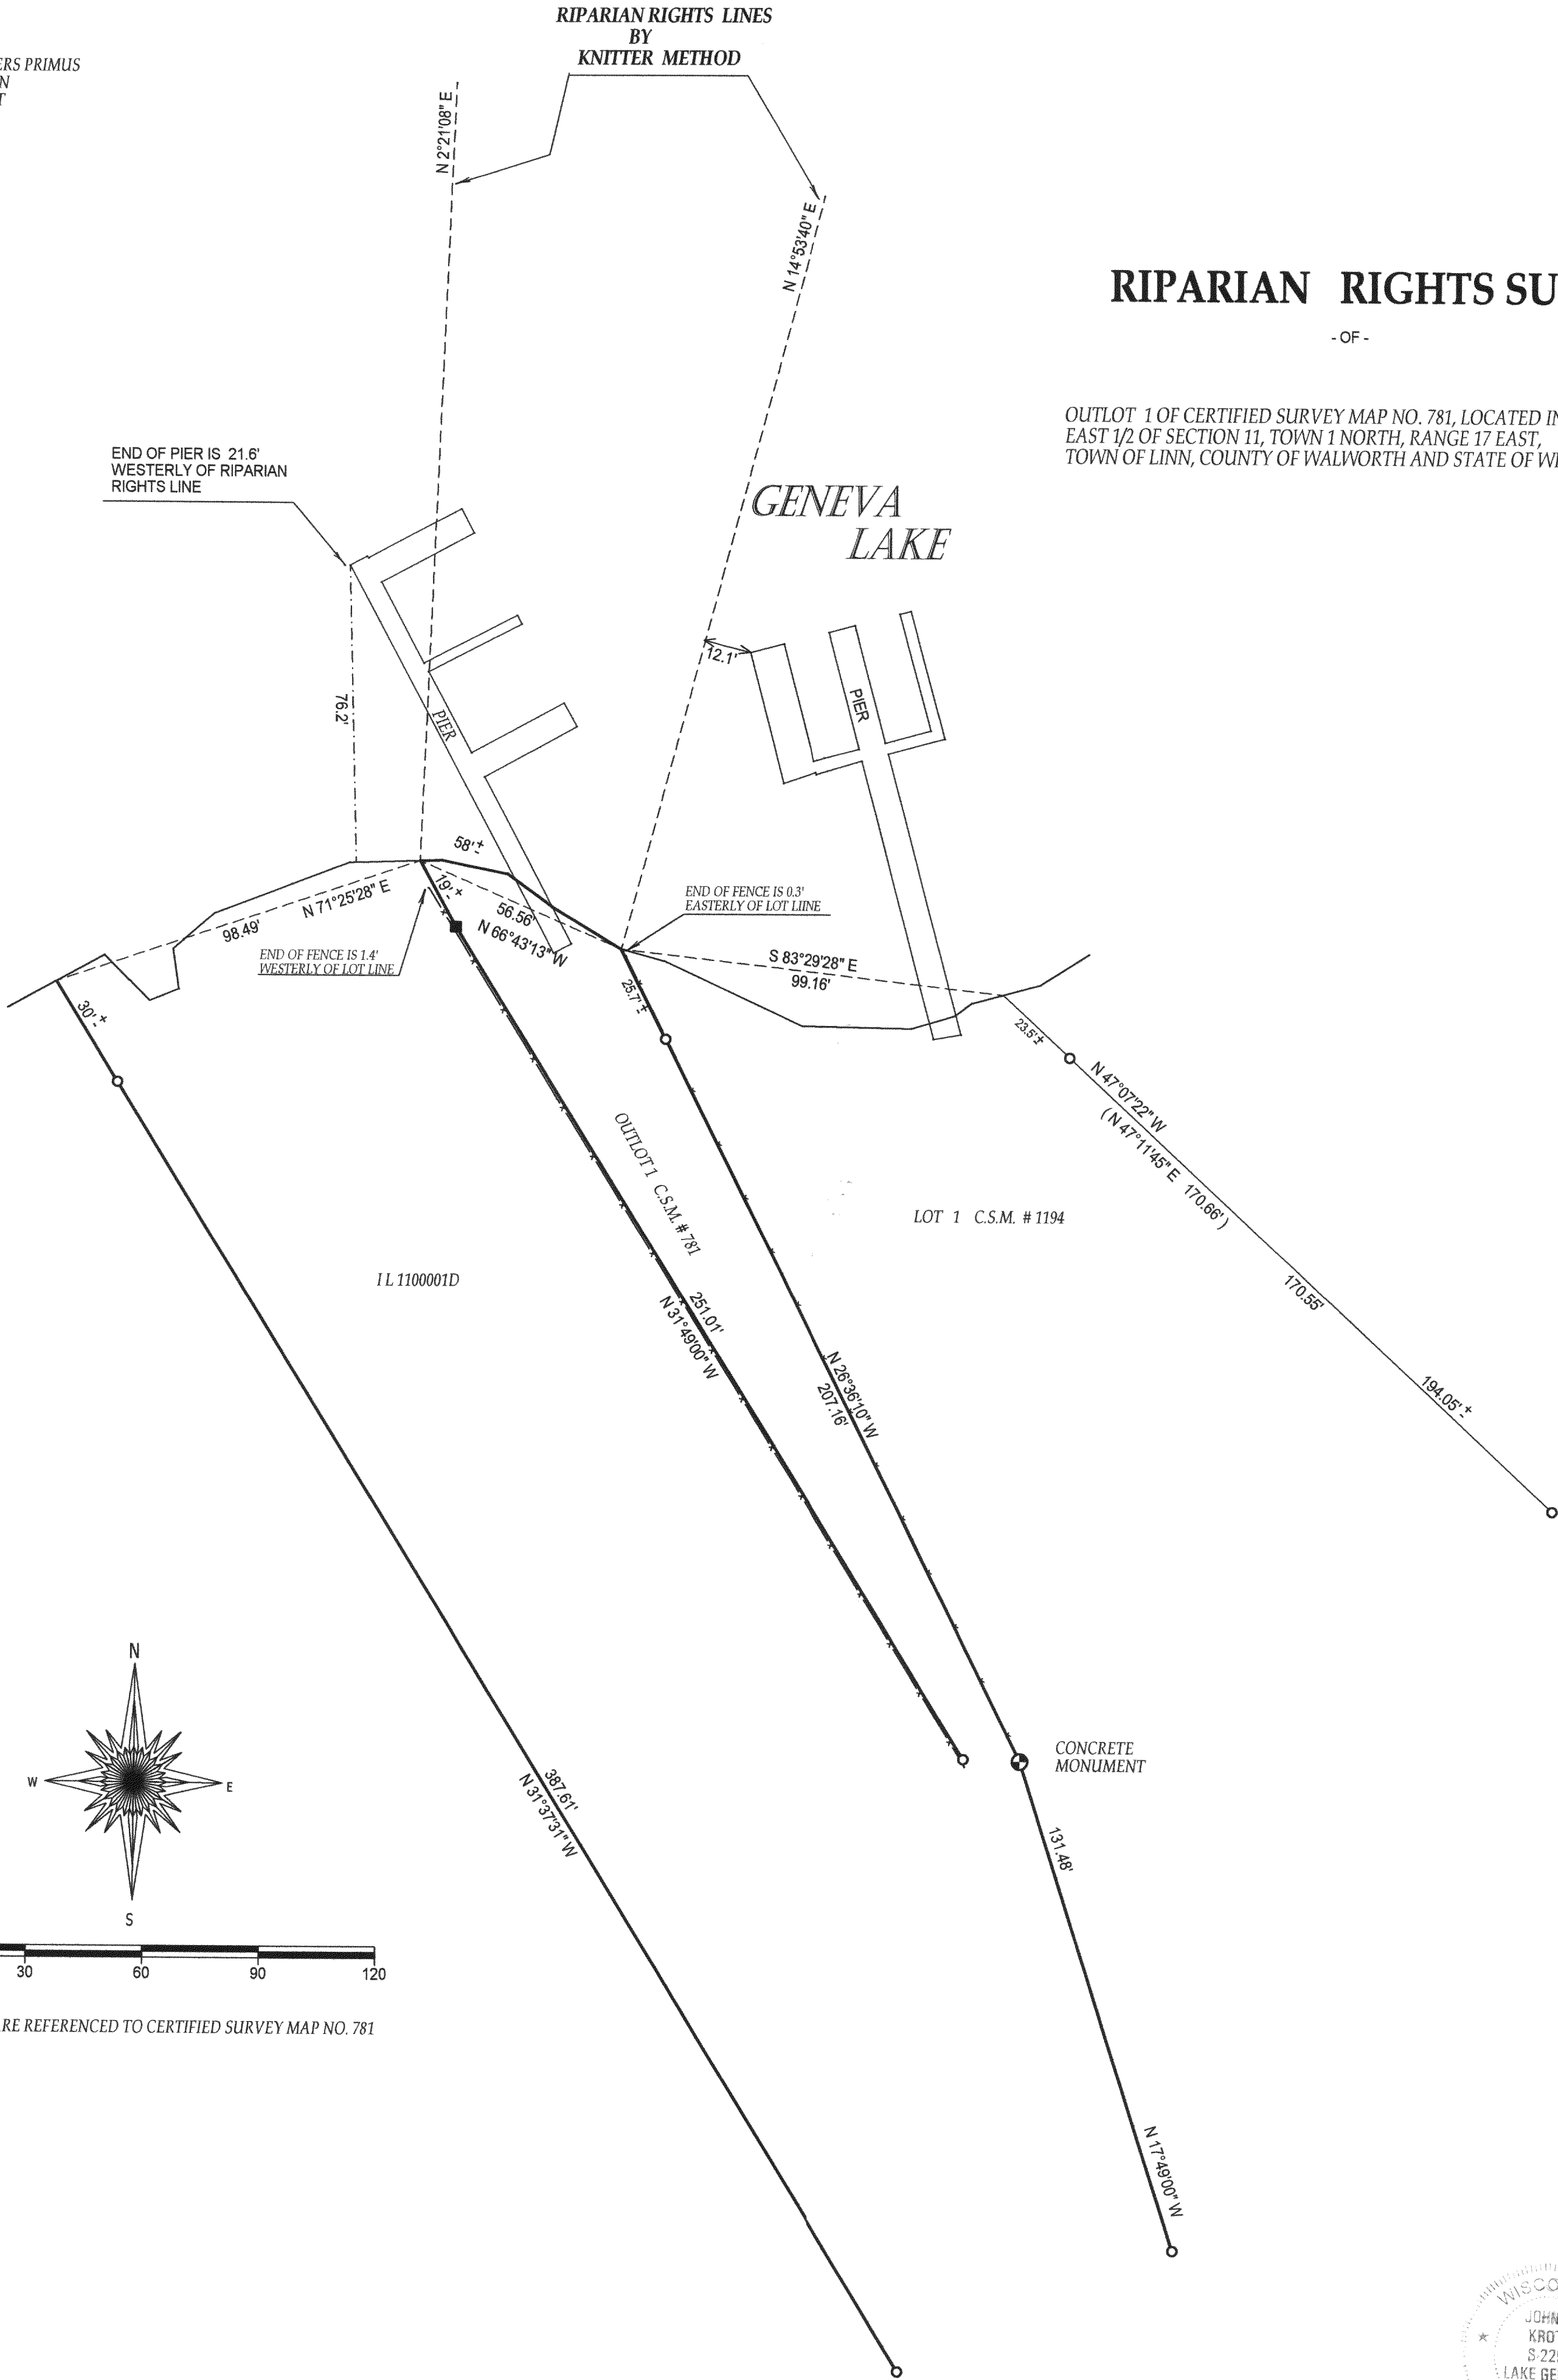

0 30 60 90 120

BEARINGS ARE REFERENCED TO CERTIFIED SURVEY MAP NO. 781



LEGEND

- () = recorded as
- = found iron bar
- = found iron pipe
- = set iron pipe
- = set iron bar

SCALE 1" = 30'

JOB # 04-193R

TAX ID # IA78100001

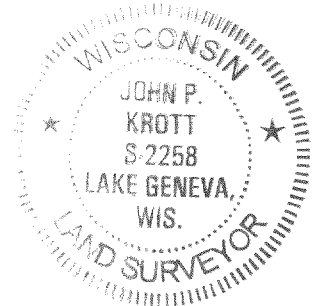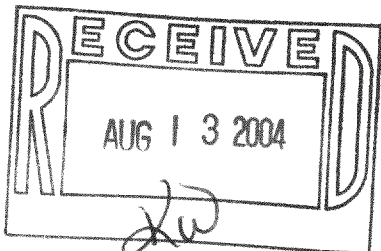

JOHN P. KROTT
S-2258
LAKE GENEVA, WIS.
LAND SURVEYOR

DATED THIS 17th, DAY OF MAY, 2004

117-2440