


PLAT OF SURVEY
LOT 3 OF BLOCK 1 FOREST REST

PART OF THE SE 1/4 OF THE SW 1/4 OF SECTION 35
TOWN 2 NORTH, RANGE 17 EAST &
PART OF THE NE 1/4 OF THE NW 1/4 OF SECTION 2
TOWN 1 NORTH, RANGE 17 EAST
WALWORTH COUNTY, WISCONSIN

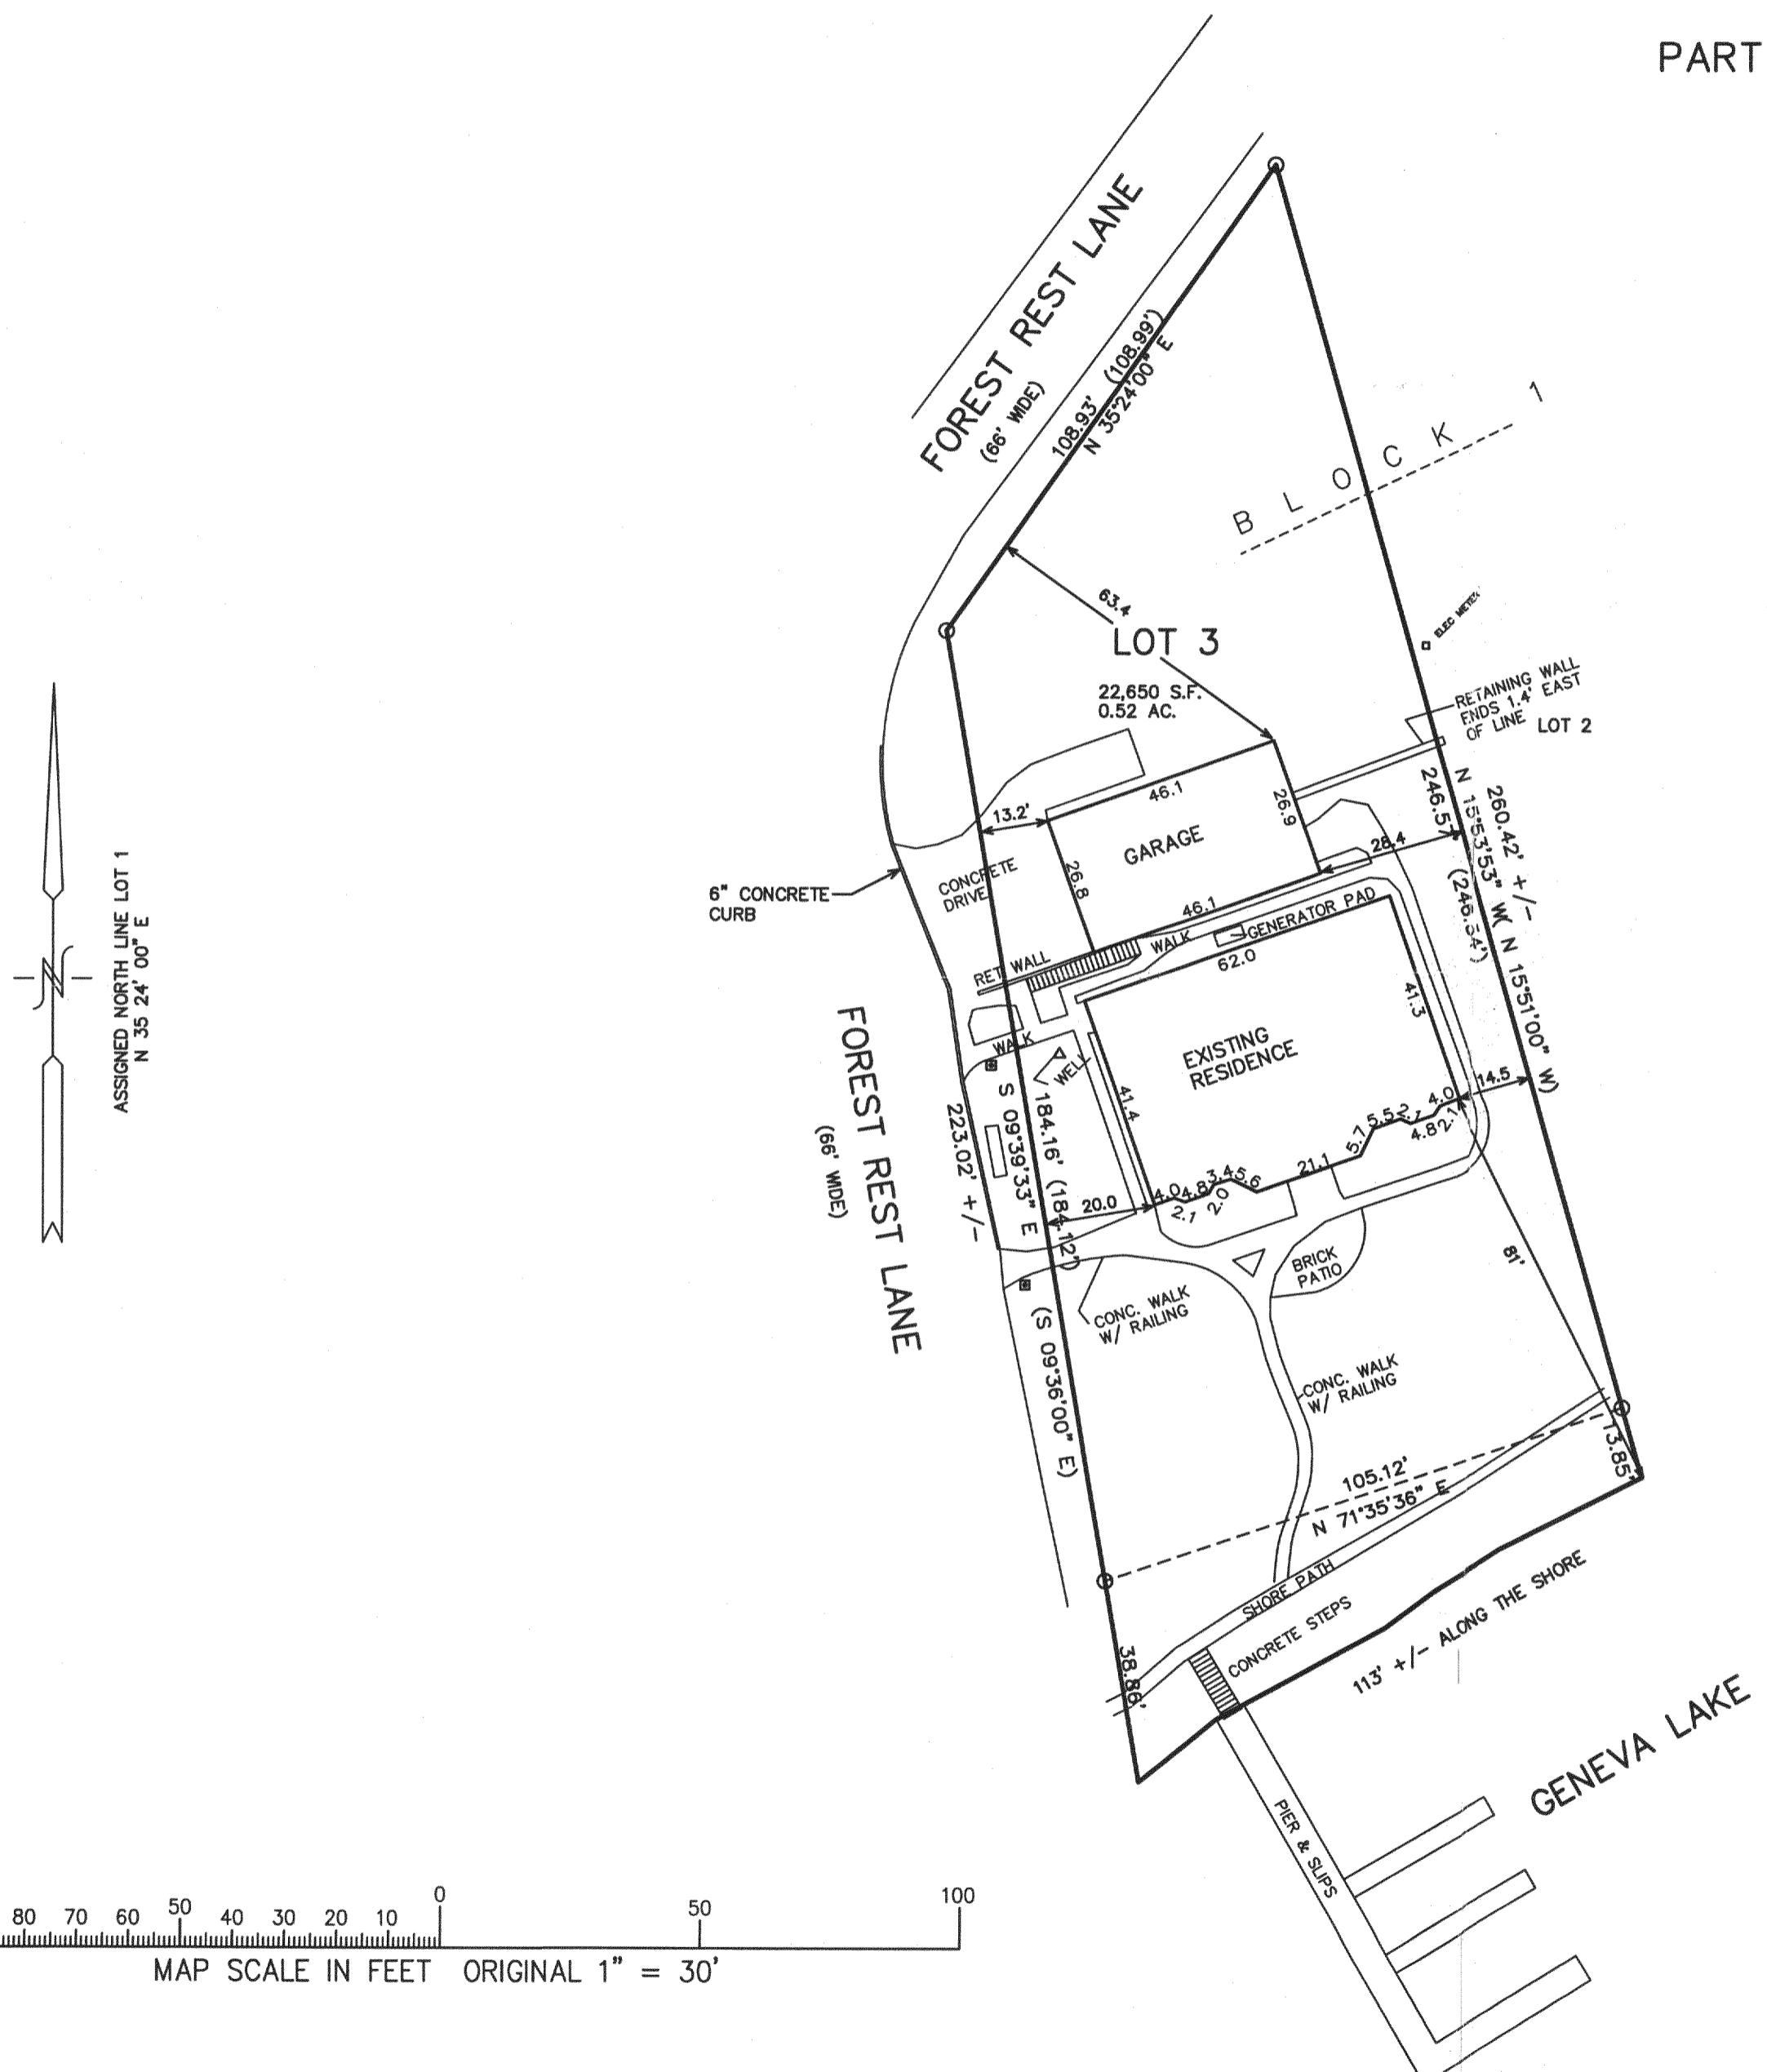


NOTE: COPIES OF THIS MAP TO WHICH THE FOLLOWING CERTIFICATE WILL APPLY SHOW SURVEYOR'S ORIGINAL SEAL AND SIGNATURE IN RED INK. COPIES BY ANY OTHER MEANS MAY HAVE ALTERATIONS WHICH DO NOT REPRESENT THE SURVEYOR'S WORK PRODUCT.

I HEREBY CERTIFY THAT THE ABOVE DESCRIBED PROPERTY HAS BEEN SURVEYED UNDER MY DIRECTION AND THAT THE ABOVE MAP IS A TRUE REPRESENTATION THEREOF AND SHOWS THE SIZE AND LOCATION OF THE PROPERTY, ITS EXTERIOR BOUNDARIES, THE LOCATION OF ALL VISIBLE STRUCTURES, AND DIMENSIONS OF ALL PRINCIPLE BUILDINGS THEREON, BOUNDARY FENCES, APPARENT EASEMENTS, ROADWAYS, AND VISIBLE ENCROACHMENTS, IF ANY. THIS SURVEY IS MADE FOR THE USE OF THE PRESENT OWNERS OF THE PROPERTY, AND ALSO THOSE WHO PURCHASE, MORTGAGE, OR GUARANTEE THE TITLE THERETO WITHIN ONE YEAR FROM THE DATE HEREOF.

DATED: SEPTEMBER 1, 2004

DATED: SEPTEMBER 1, 2004 REVISED 09-09-2004
RESURVEY TO TITLE SPEC.'S


PETER S. GORDON R.L.S. 210

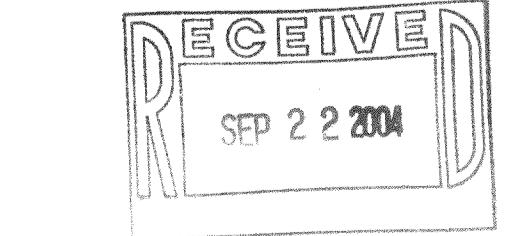

PROJECT NO.
5660
DATE:
09-01-2000
SHEET NO.
1 OF 1

WORK ORDERED BY:
REMAX GENEVA LAKE
101 BROAD STREET
LAKE GENEVA, WISCONSIN

FARRIS, HANSEN & ASSOCIATES, INC.
Engineering, Architecture, Surveying
7 Ridgway Court P.O. Box 437
ELKHORN, WISCONSIN 53121
Office: (414) 723-2098
Fax: (414) 723-5886

REVISIONS

IFR 0003

117-2468