


AMBIT LAND SURVEYING
P. O. BOX 42
Bassett, WI. 53101

PLAT OF SURVEY OF

PHONE 262-537-4874
FAX 262-537-4221

Lots 68 thru 74, Block 2 of LAKE VIEW PARK, a subdivision located in the Northeast Quarter of Section 16, Township 1 North, Range 17 East of the 4th Principal Meridian, Linn Township, Walworth County, Wisconsin.

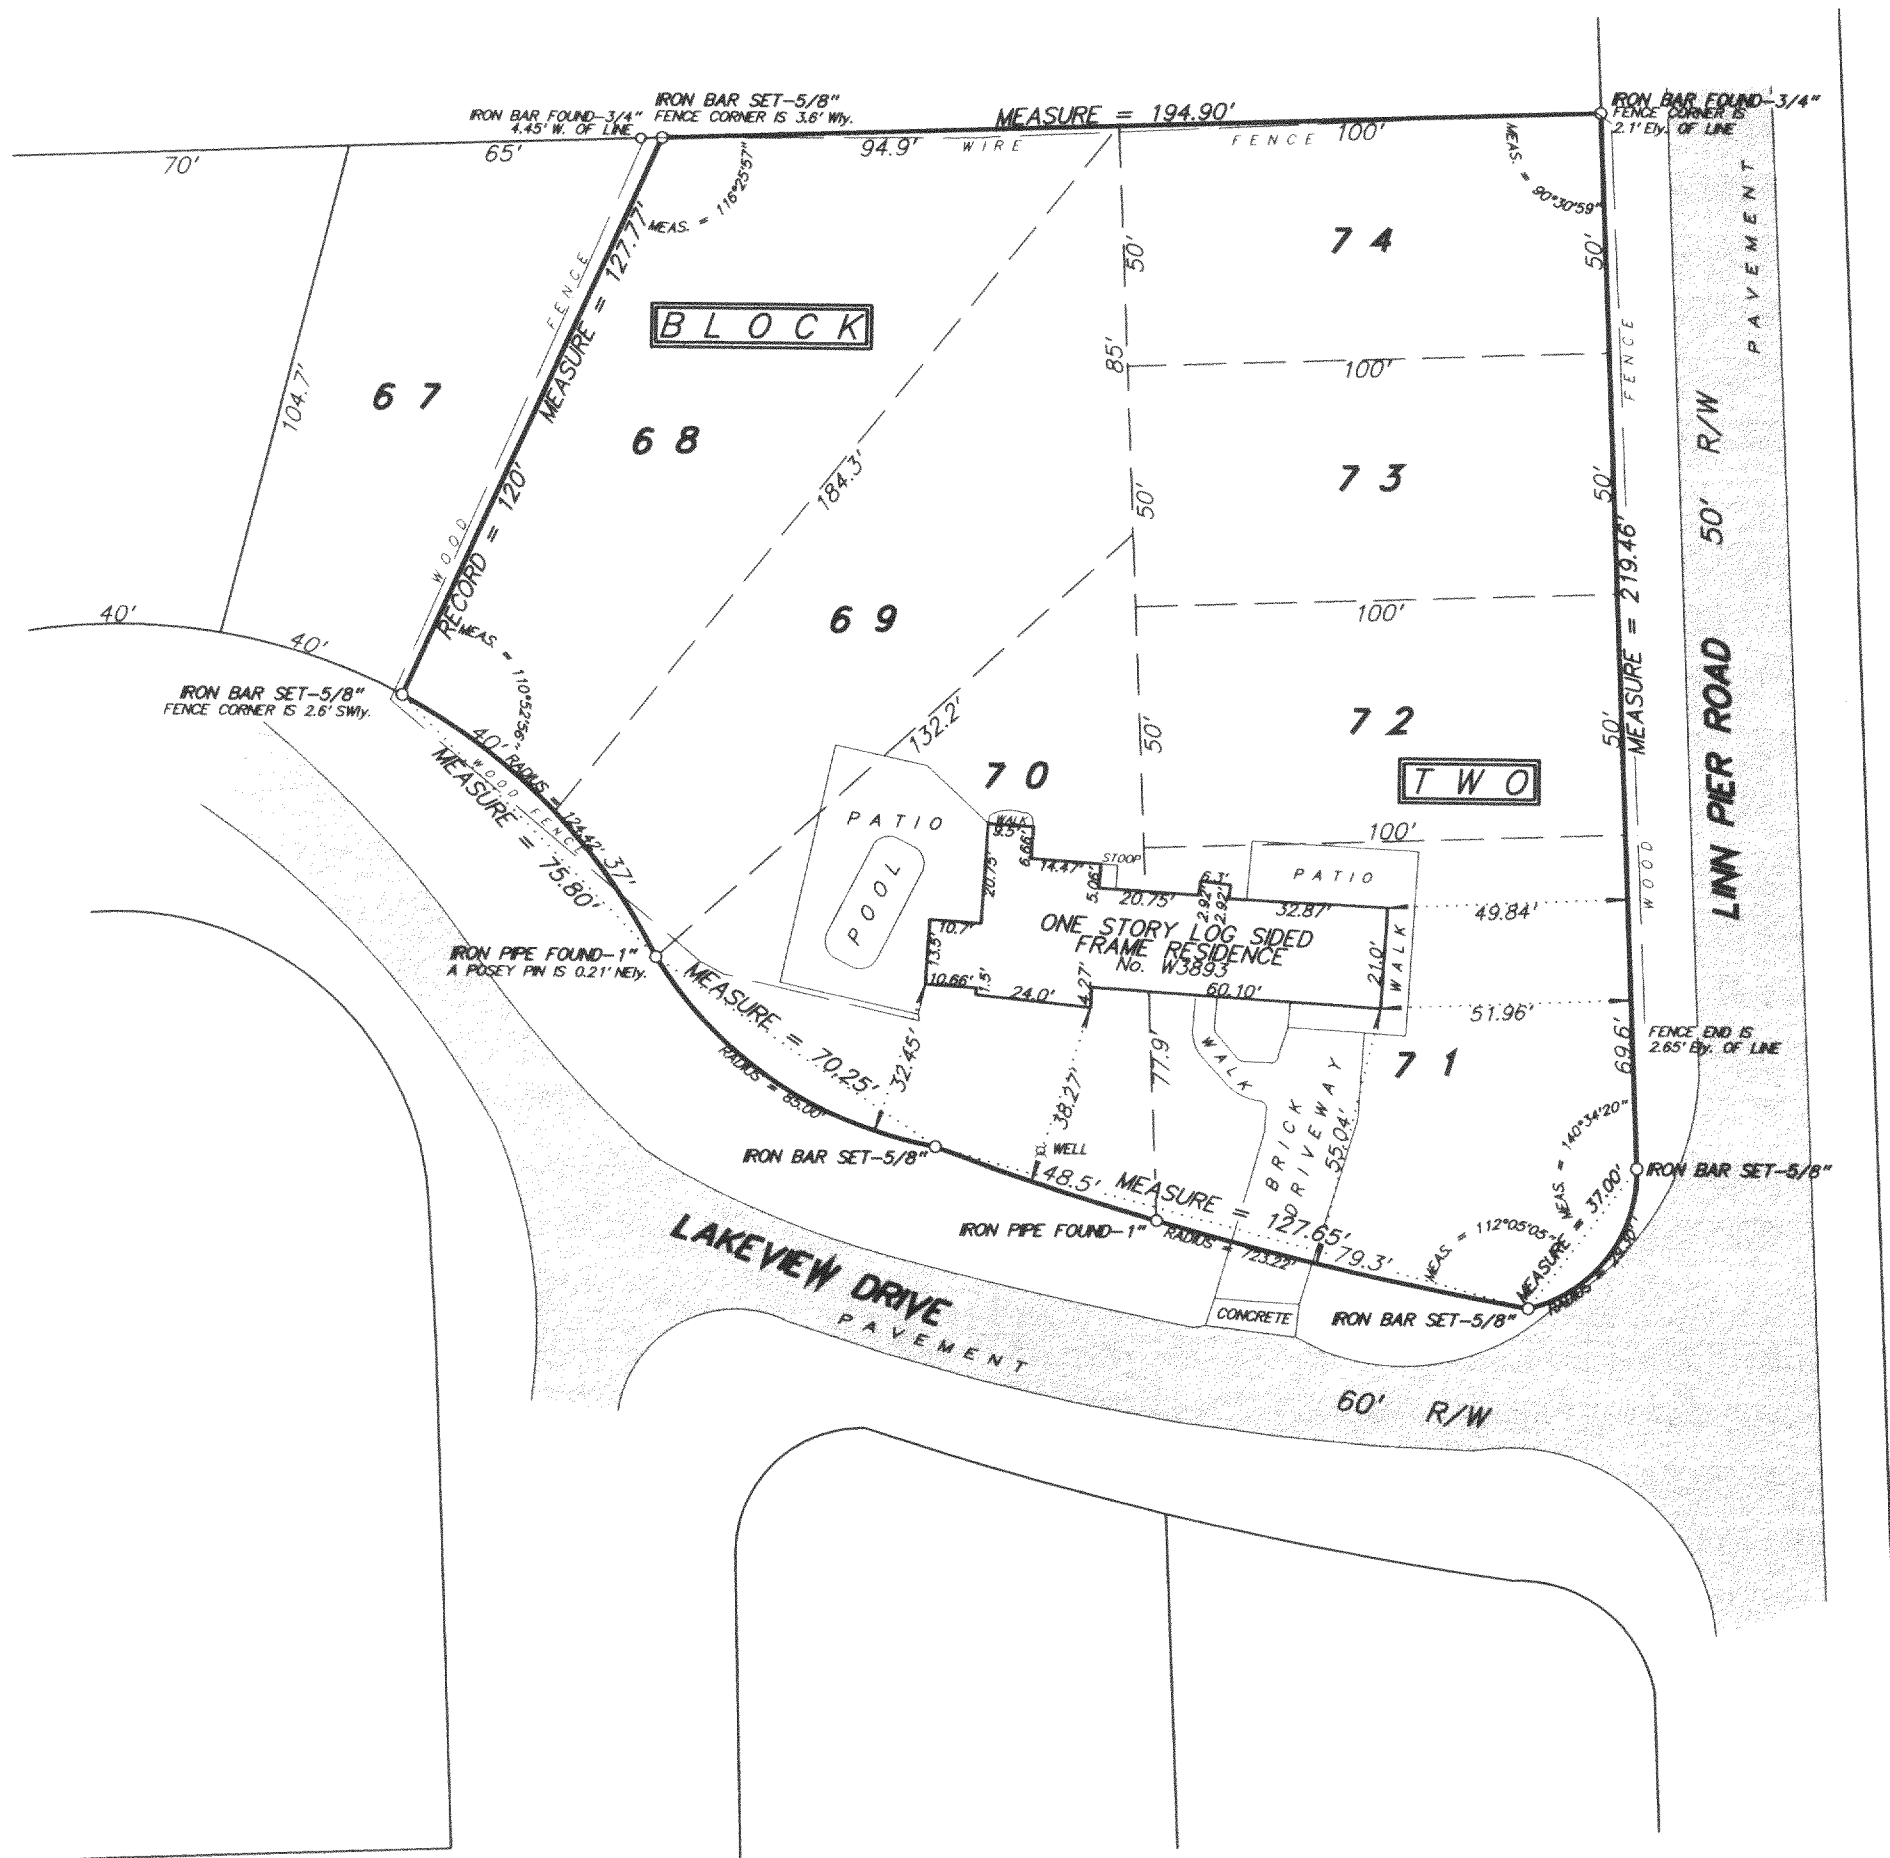

NOTE: BUILDING MEASUREMENTS & TIES ARE TO FOUNDATION



SCALE 1 inch = 40 feet

ORDERED BY P. Powell


JOB NO. 03336

I hereby certify that I have surveyed the above described property and the above plat is a true representation thereof and shows the size and location of the property, its exterior boundaries, the location and dimensions of all visible structures thereon, boundary fences, apparent easements and roadways and visible encroachments, if any.

This survey is made for the exclusive use of the present owners of the property, and also those who purchase, mortgage, or guarantee the title thereto within one year from the date hereof.

Dated at Bassett, Wisconsin this _____ day of _____ 2003.

Mark A. Bolender
Wisconsin Registered Land Surveyor S - 1784

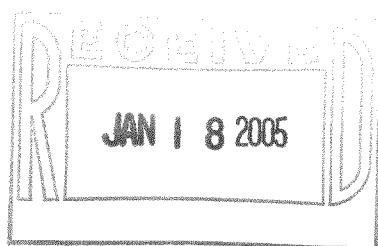

1LVP-15A

117-2506