




Plat of Survey of  
Part of Lot 13, Block 2, Woodale Addition, a subdivision  
located in T 1 N, R 17 E, Walworth County, Wisconsin.

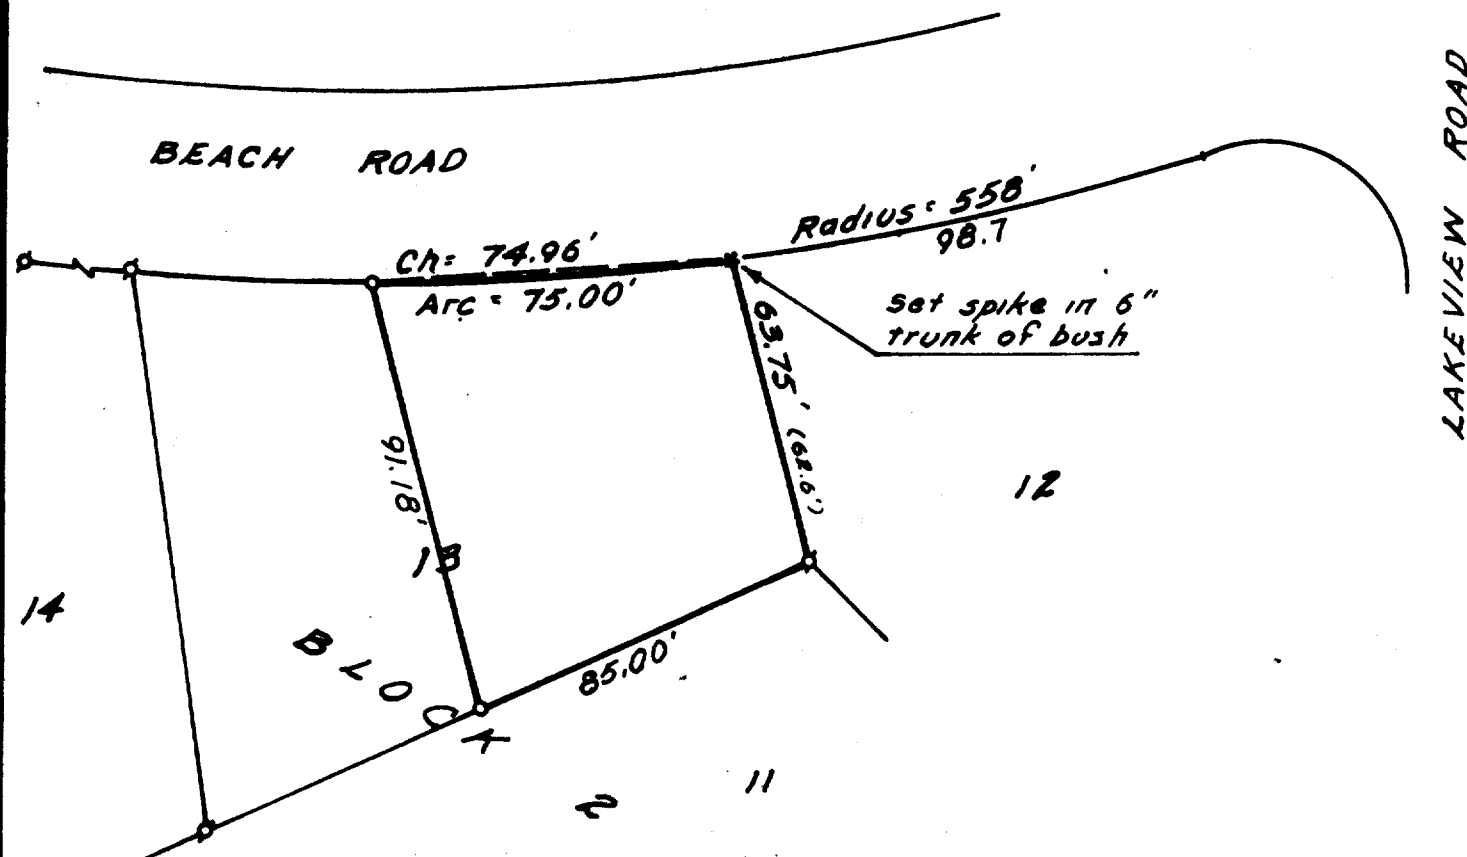

SCALE: 1"=40'

## LEGEND

- Ø — IRON PIPE FOUND  
 ○ — IRON PIPE PLACED  
 ● — CONCRETE MONUMENT  
 X — SPIKE  
 ( ) — Platted Distance

**I, HAROLD H. KOLB, DO HEREBY CERTIFY THAT I HAVE SURVEYED THE PROPERTY HEREON DESCRIBED ACCORDING TO THE OFFICIAL RECORDS, AND THAT THE PLAT HEREON IS A CORRECT REPRESENTATION OF THE LOT LINES, and that there are no apparent encroachments.**

Harold N. Kalk

**HAROLD H. KOLB**

**WISCONSIN REGISTERED LAND SURVEYOR, S-187**

DATE July 14, 1970



IW-25C

117-253