

Plat of Survey

of


Lot 24 of Linnwood 1st Addition,

a subdivision located in the Northeast 1/4 of Section 15, Town 1 North, Range 17 East, Town of Linn, Walworth County, Wisconsin.

Surveyed for: **Godfrey, Leibsle, Blackburn & Howarth, S.C.**
11 North Wisconsin Street •• Post Office Box 260
Elkhorn, Wisconsin 53121



Notes: 1) This survey plat is not certified unless signed and sealed in red ink.
2) This survey is subject to Wisconsin lien laws. This Plat of Survey is the notice of intent to file lien. Lien waiver required.

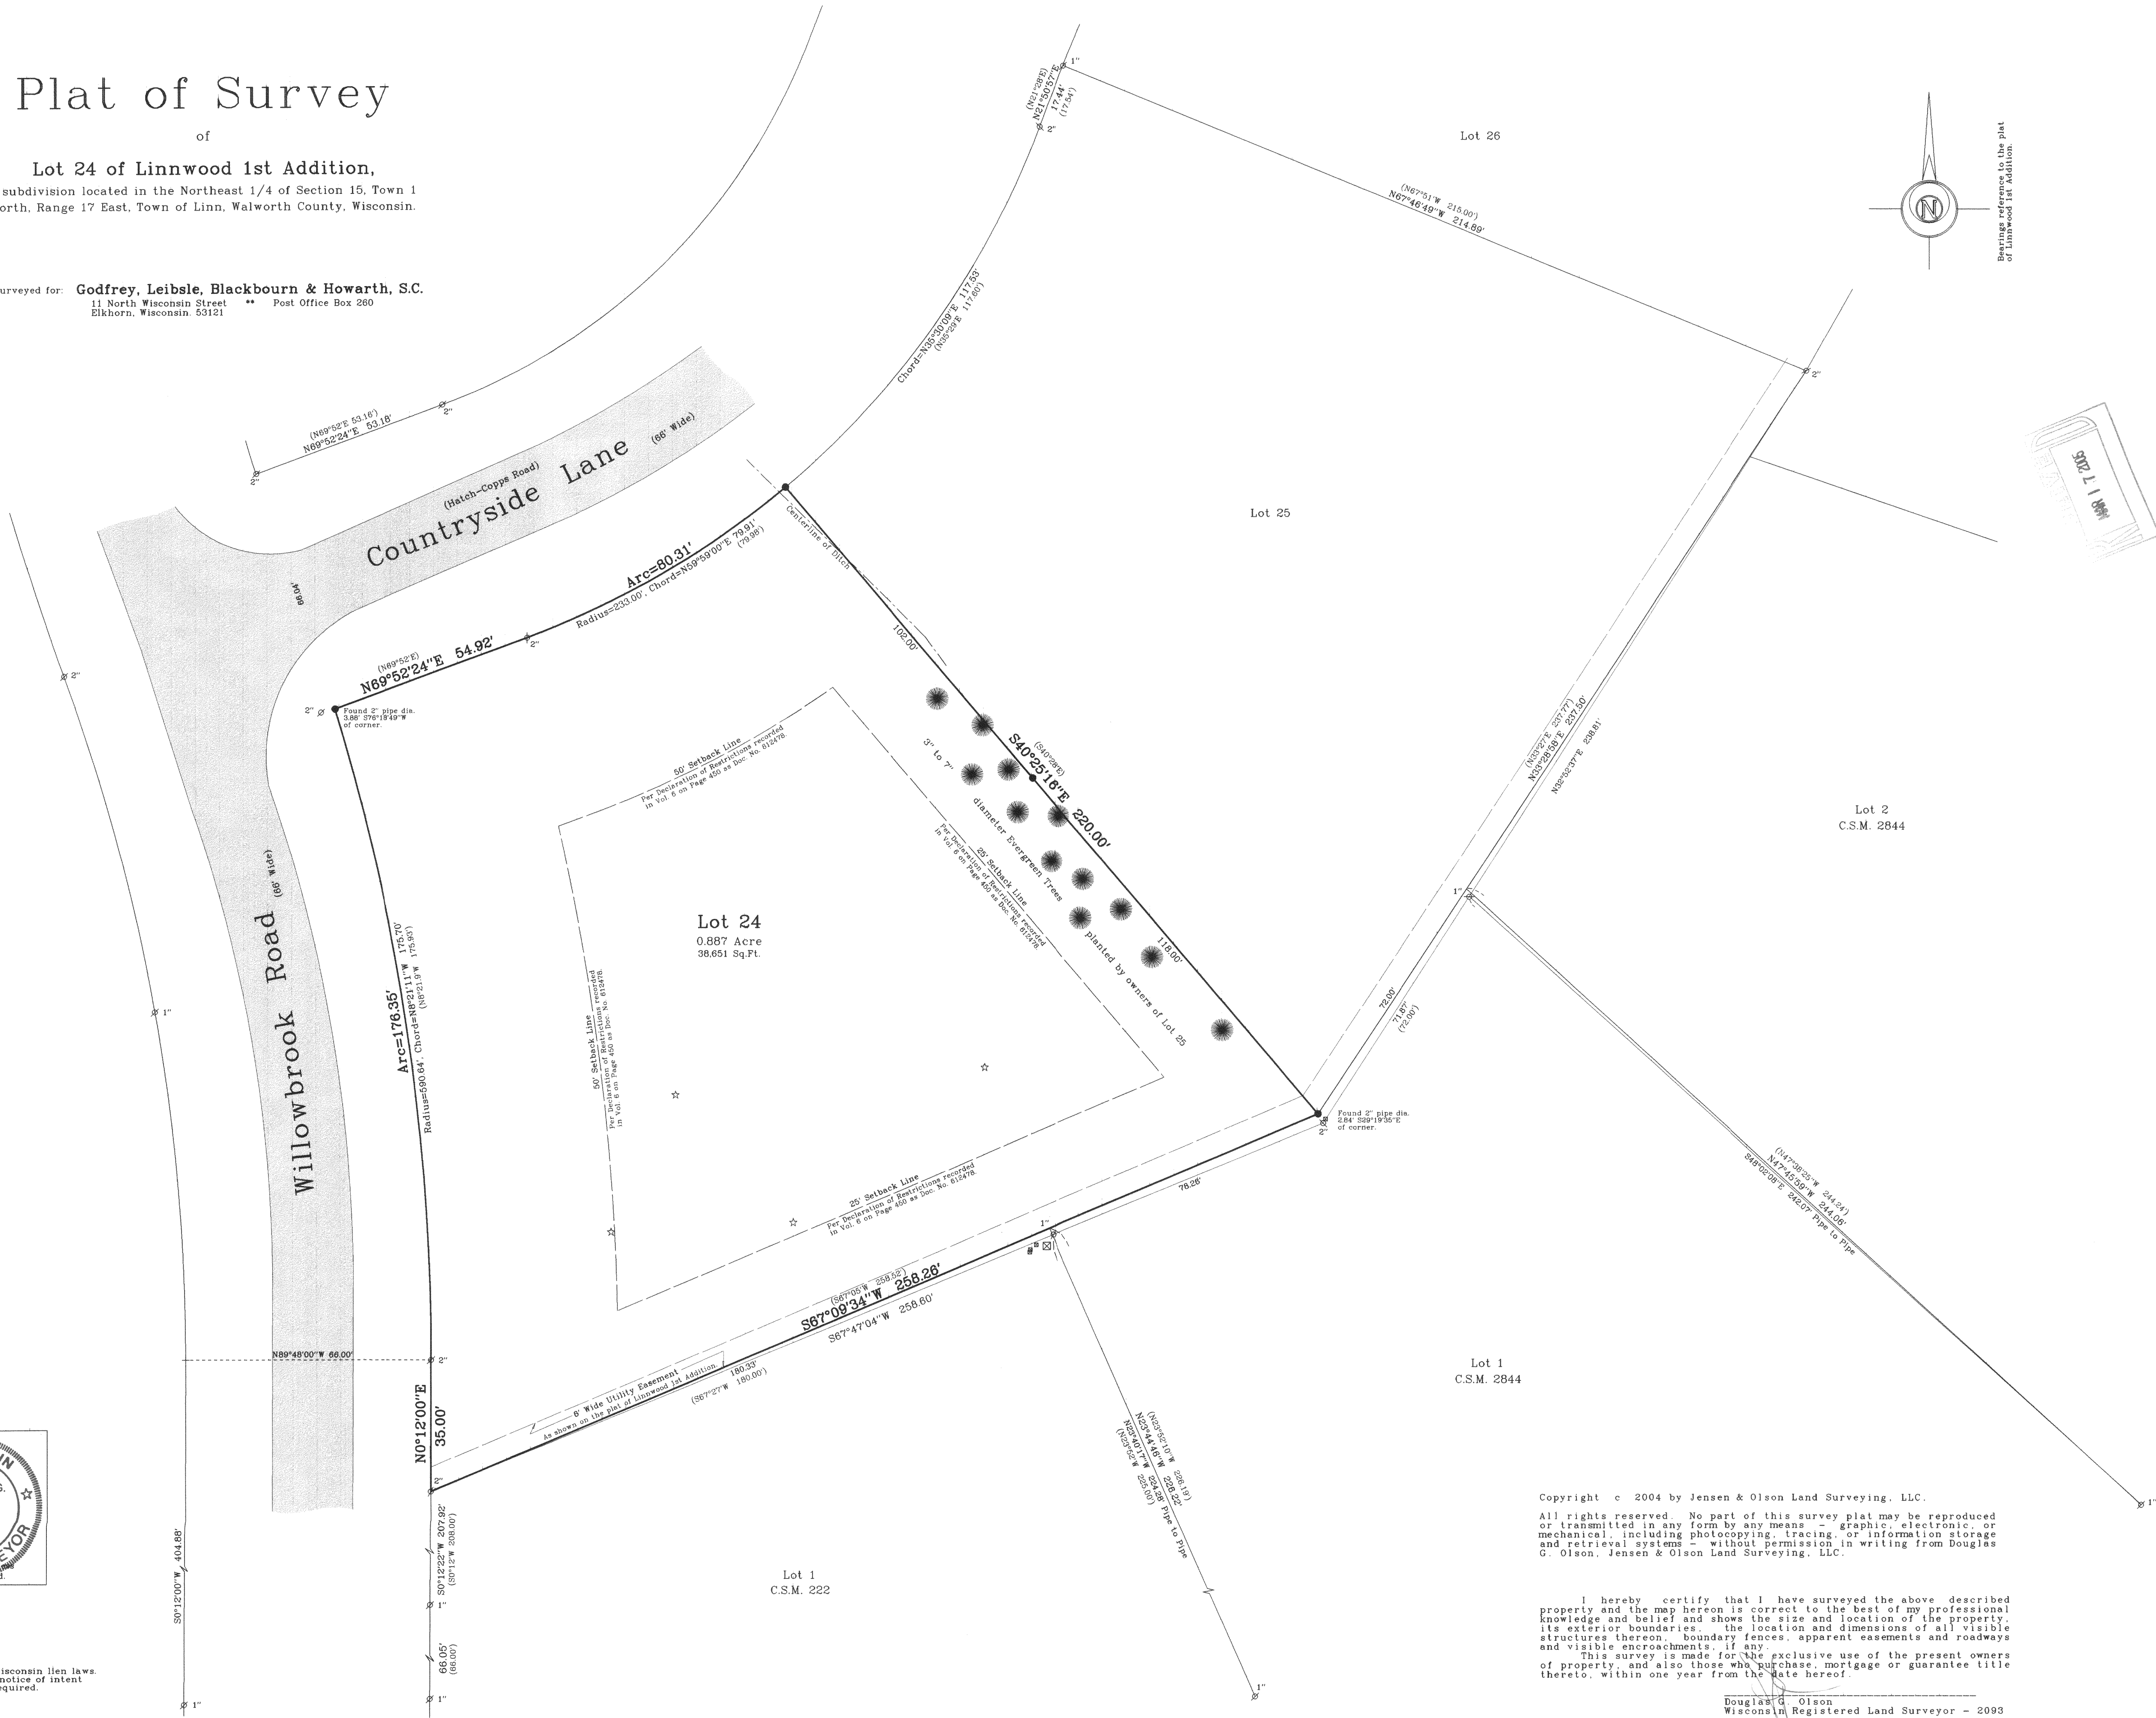

Copyright © 2004 by Jensen & Olson Land Surveying, LLC.
All rights reserved. No part of this survey plat may be reproduced or transmitted in any form by any means - graphic, electronic, or mechanical, including photocopying, tracing, or information storage and retrieval systems - without permission in writing from Douglas G. Olson, Jensen & Olson Land Surveying, LLC.

I hereby certify that I have surveyed the above described property and the map hereon is correct to the best of my professional knowledge and belief and shows the size and location of the property, its exterior boundaries, the location and dimensions of all visible structures thereon, boundary fences, apparent easements and roadways and visible encroachments, if any.
This survey is made for the exclusive use of the present owners of property, and also those who purchase, mortgage or guarantee title thereto, within one year from the date hereof.

Douglas G. Olson
Wisconsin Registered Land Surveyor - 2093

Survey date: December 16, 2004.
Revisions:

Scale in Feet
1" = 20'



Jensen & Olson Land Surveying, LLC



Legend
Found Iron Pipe, dia. indicated
Found Utility Box or Pedestal
Recorded Information
Soil Boring Tree
Asphalt Surface

Sheet 1 of 1 Sheets.

Job Reference Number

2004.201

2004.201

ILLWA 0009

117-2540