


PREPARED FOR : BEVERLY AND ROBERT HAMMERSCHMIDT
890 PINEGROVE CT.
WHEATON IL. 60187

PLAT OF SURVEY


J.K. SURVEYING INC.
N3705 WILLOWBEND LANE
LAKE GENEVA, WI, 53147
262-248-3697

- OF -

LOT 129 AND THE EAST 58 FEET OF LOT 132 IN THE SUBDIVISION
KNOWN AS LAKE GENEVA BEACH, LOCATED IN SECTION 11 TOWN
1 NORTH, RANGE 17 EAST, WALWORTH COUNTY, WISCONSIN.

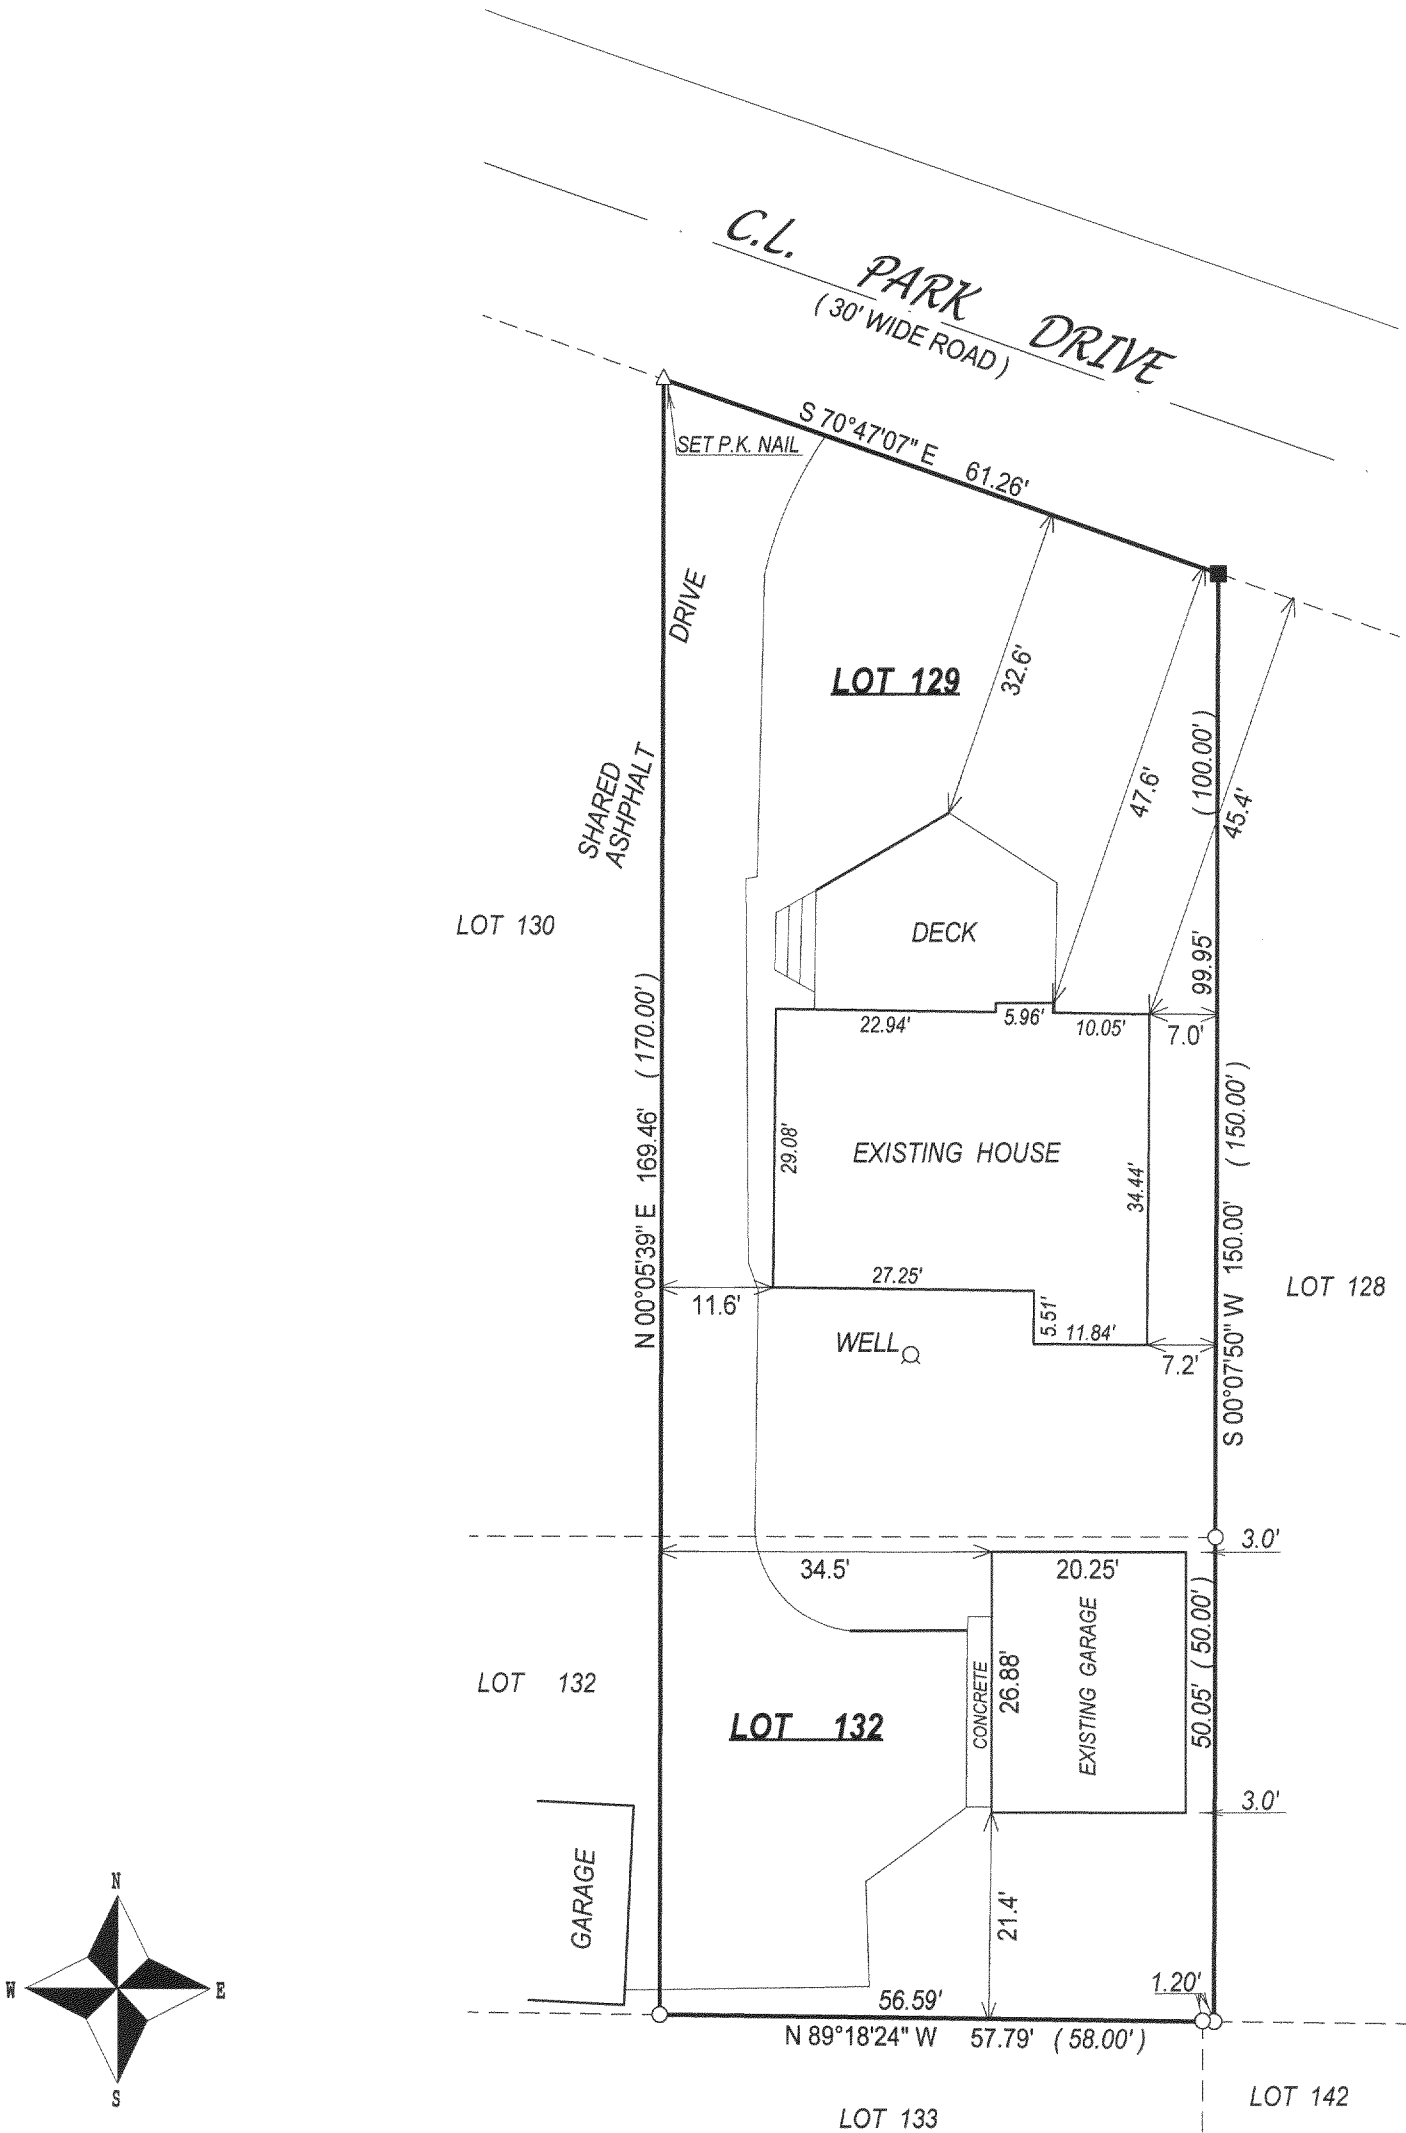

RECEIVED
FEB 18 2005

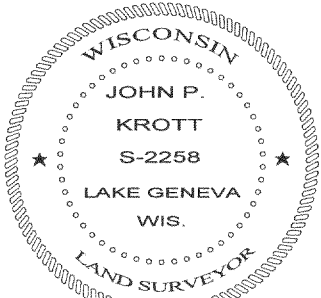

John P. Krott

JOHN KROTT S - 2258
Wisconsin Registered Land Surveyor
(original if signed in red)

DATED THIS THE 6th DAY OF OCTOBER 2004.

117-2544