


# PLAT OF SURVEY

FOR: HAP ARNOLD, SUPERB BUILDERS

DATE: 11/28/2005

DESCRIPTION: BEING ALL THAT PART OF LOT 10 AND THE EAST 1/2 OF LOT 11 ELGIN CLUB SUBDIVISION, LOCATED IN PART OF THE SW 1/4 OF SECTION 4, TOWN 1 NORTH, RANGE 17 EAST, TOWN OF LINN, WALWORTH COUNTY, WISCONSIN.

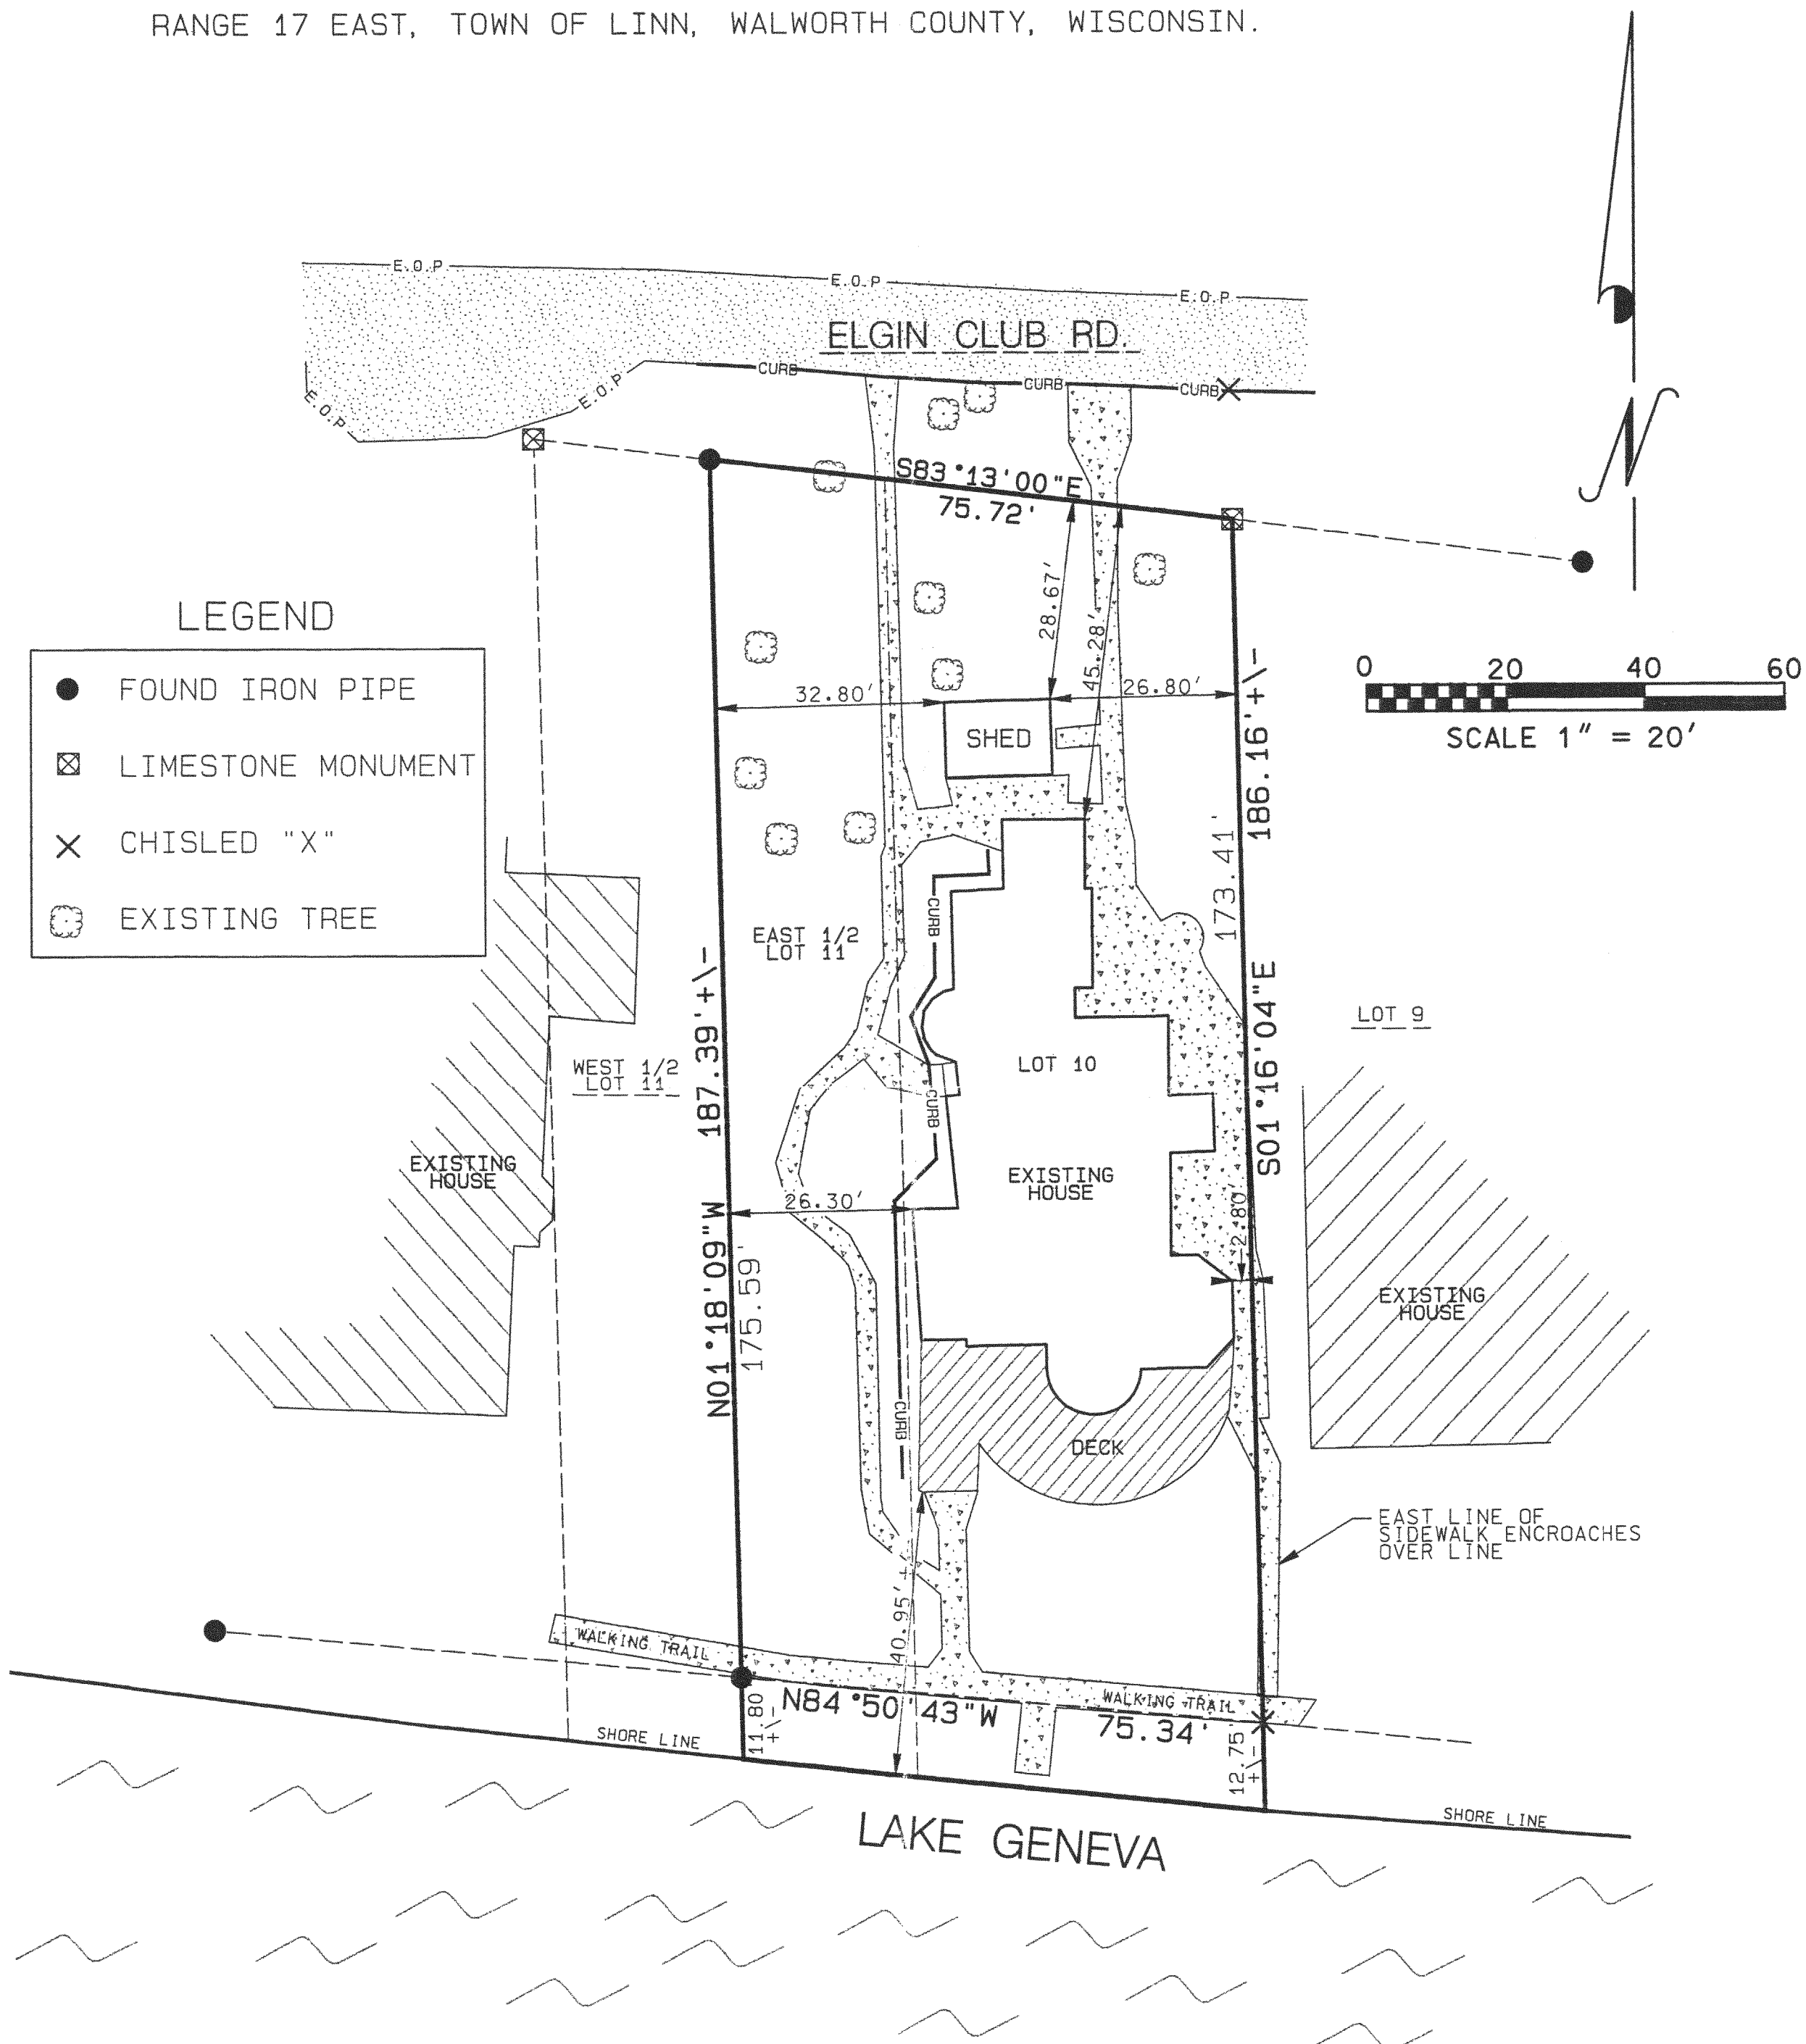

I PAUL H. VAN HENKELUM R.L.S. # 1931 HEREBY  
CERTIFY THAT THIS SURVEY WAS MADE IN ACCORDANCE WITH THE MINIMUM STANDARDS FOR PROPERTY SURVEYS (CHAPTER A-E7) STATE OF WISCONSIN AND HAS BEEN PREPARED UNDER MY DIRECTION AND CONTROL AND IS CORRECT TO THE BEST OF MY KNOWLEDGE AND BELIEF.

PAUL H. VAN HENKELUM  
S-1931  
JUKWONAGO, WI

PAUL H. VAN HENKELUM, R.L.S. # 1931  
RSV\*05231SURVEY.DGN 11/28+5

IFC - 10

RECEIVED  
JAN 24

**RSV**  
**ENGINEERING, INC.**  
Engineers Land Surveyors Environmental Scientists  
801 MAIN STREET MUKWONAGO, WISCONSIN 53149 (262)363-2004



**RSV**  
ENGINEERING, INC.