


AS-BUILT FOUNDATION PLAT OF SURVEY

LOTS 22 AND 24 OF LAKE GENEVA CLUB

LOCATED IN PART OF NW 1/4 OF SECTION 8, TOWN 1 NORTH,
RANGE 17 EAST, TOWN OF LINN, WALWORTH COUNTY, WISCONSIN

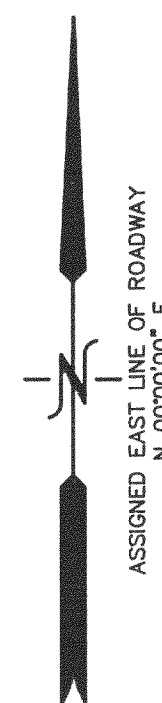

BENCH MARK
FOUND "PK" NAIL
IN PAVEMENT
ELEV. = 895.80'

EXISTING RESIDENCE
ENTRY ELEV. = 896.2'

LOT 20

S 88°45'20" E (82.72')
82.65'

FOUND IRON PIPE STAKE
N 51°11' W, 0.57' FROM
IRON PIPE STAKE AT
CORNER

POWER POLE

UTILITIES ALONG
PROPERTY LINE

LOT 22


AS-BUILT
FOUNDATION
(FIELD LOCATED 03/03/06)

SEPTIC TANK

CHIMNEY

S 00°04'12" E
100.14'
(100.12')

LEGEND
○ = FOUND IRON PIPE STAKE
△ = FOUND "PK" NAIL IN PAVEMENT
(XXX) = RECORDED AS

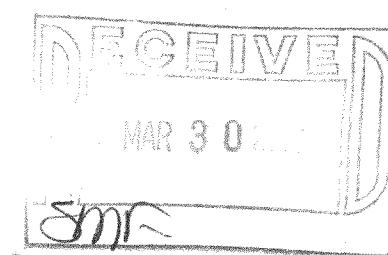


NOTE: COPIES OF THIS MAP TO WHICH THE FOLLOWING CERTIFICATE
WILL APPLY SHOW THE SURVEYOR'S ORIGINAL SEAL AND SIGNATURE
IN RED INK. COPIES BY ANY OTHER MEANS MAY HAVE ALTERATIONS
WHICH DO NOT REPRESENT THE SURVEYOR'S WORK PRODUCT.

I HEREBY CERTIFY THAT THE ABOVE DESCRIBED PROPERTY HAS BEEN
SURVEYED UNDER MY DIRECTION AND THAT THE ABOVE MAP IS A TRUE
REPRESENTATION THEREOF AND SHOWS THE SIZE AND LOCATION OF
THE PROPERTY AND ITS EXTERIOR BOUNDARIES. THIS SURVEY IS
MADE FOR THE USE OF THE PRESENT OWNERS OF THE PROPERTY, AND
ALSO THOSE WHO PURCHASE, MORTGAGE, OR GUARANTEE THE TITLE
THERE TO WITHIN ONE YEAR FROM THE DATE HEREOF.

DATED: JANUARY 6, 2005

PETER S. GORDON R.L.S. 2101

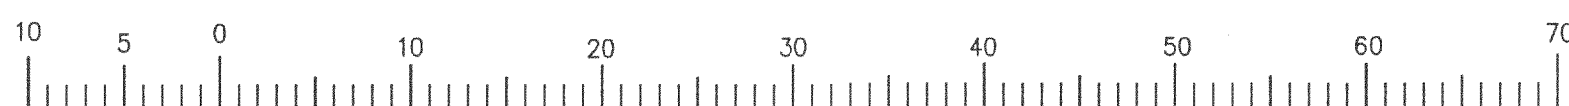

MAP SCALE IN FEET ORIGINAL 1" = 10'

WORK ORDERED BY -
VERNE GILBERT
F & S PROPERTIES
P.O. BOX 85
WALWORTH, WI 53184

FARRIS, HANSEN & ASSOCIATES, INC.
ENGINEERING - ARCHITECTURE - SURVEYING
7 RIDGWAY COURT P.O. BOX 437
ELKHORN, WISCONSIN 53121
OFFICE: (262) 723-2098 FAX: (262) 723-5886

REVISIONS
03/03/2006
TO SHOW SIZE
AND LOCATION
OF AS-BUILT
FOUNDATION

PROJECT NO.
6956
DATE:
01/06/06
SHEET NO.
1 OF 1