

PREPARED FOR:
 ERNIE & JOANNE ISADORE
 820 NORTH 5th AVE.
 ST. CHARLES, IL 60174

PLAT OF SURVEY

OF


PATHFINDER SURVEYING, INC.
 W2888 KRUEGER RD.
 LAKE GENEVA, WI, 53147
 262-248-3697

A PARCEL OF LAND LOCATED IN SECTION 5, T.1.N. , R.17.E. , WALWORTH COUNTY WISCONSIN.
 DESCRIBED AS FOLLOWS: LOT 1 OF CERTIFIED SURVEY MAP NO. 99 RECORDED SEPTEMBER 30,
 1971 IN VOL. 1 OF CERTIFIED SURVEYS PAGE 99.

ALSO: PART OF LOT 1 OF CERTIFIED SURVEY MAP NO. 43. AS RECORDED IN VOLUME 1 PAGE 43
 OF CERTIFIED SURVEYS. BEGINNING AT THE SOUTHEAST CORNER OF SAID LOT 1; THENCE
 S 56°21'12" W A DISTANCE OF 153.63 FEET TO A POINT; THENCE N 39°28'59" W A DISTANCE OF 257.01
 FEET TO A POINT; THENCE N 50°33'00" E A DISTANCE OF 115.23 FEET TO A POINT; THENCE S 22°25'20" E
 A DISTANCE OF 101.39 FEET TO A POINT; THENCE S 60°27'49" E A DISTANCE OF 188.11 FEET TO THE POINT
 OF BEGINNING.

JUL 28 2006

SMF

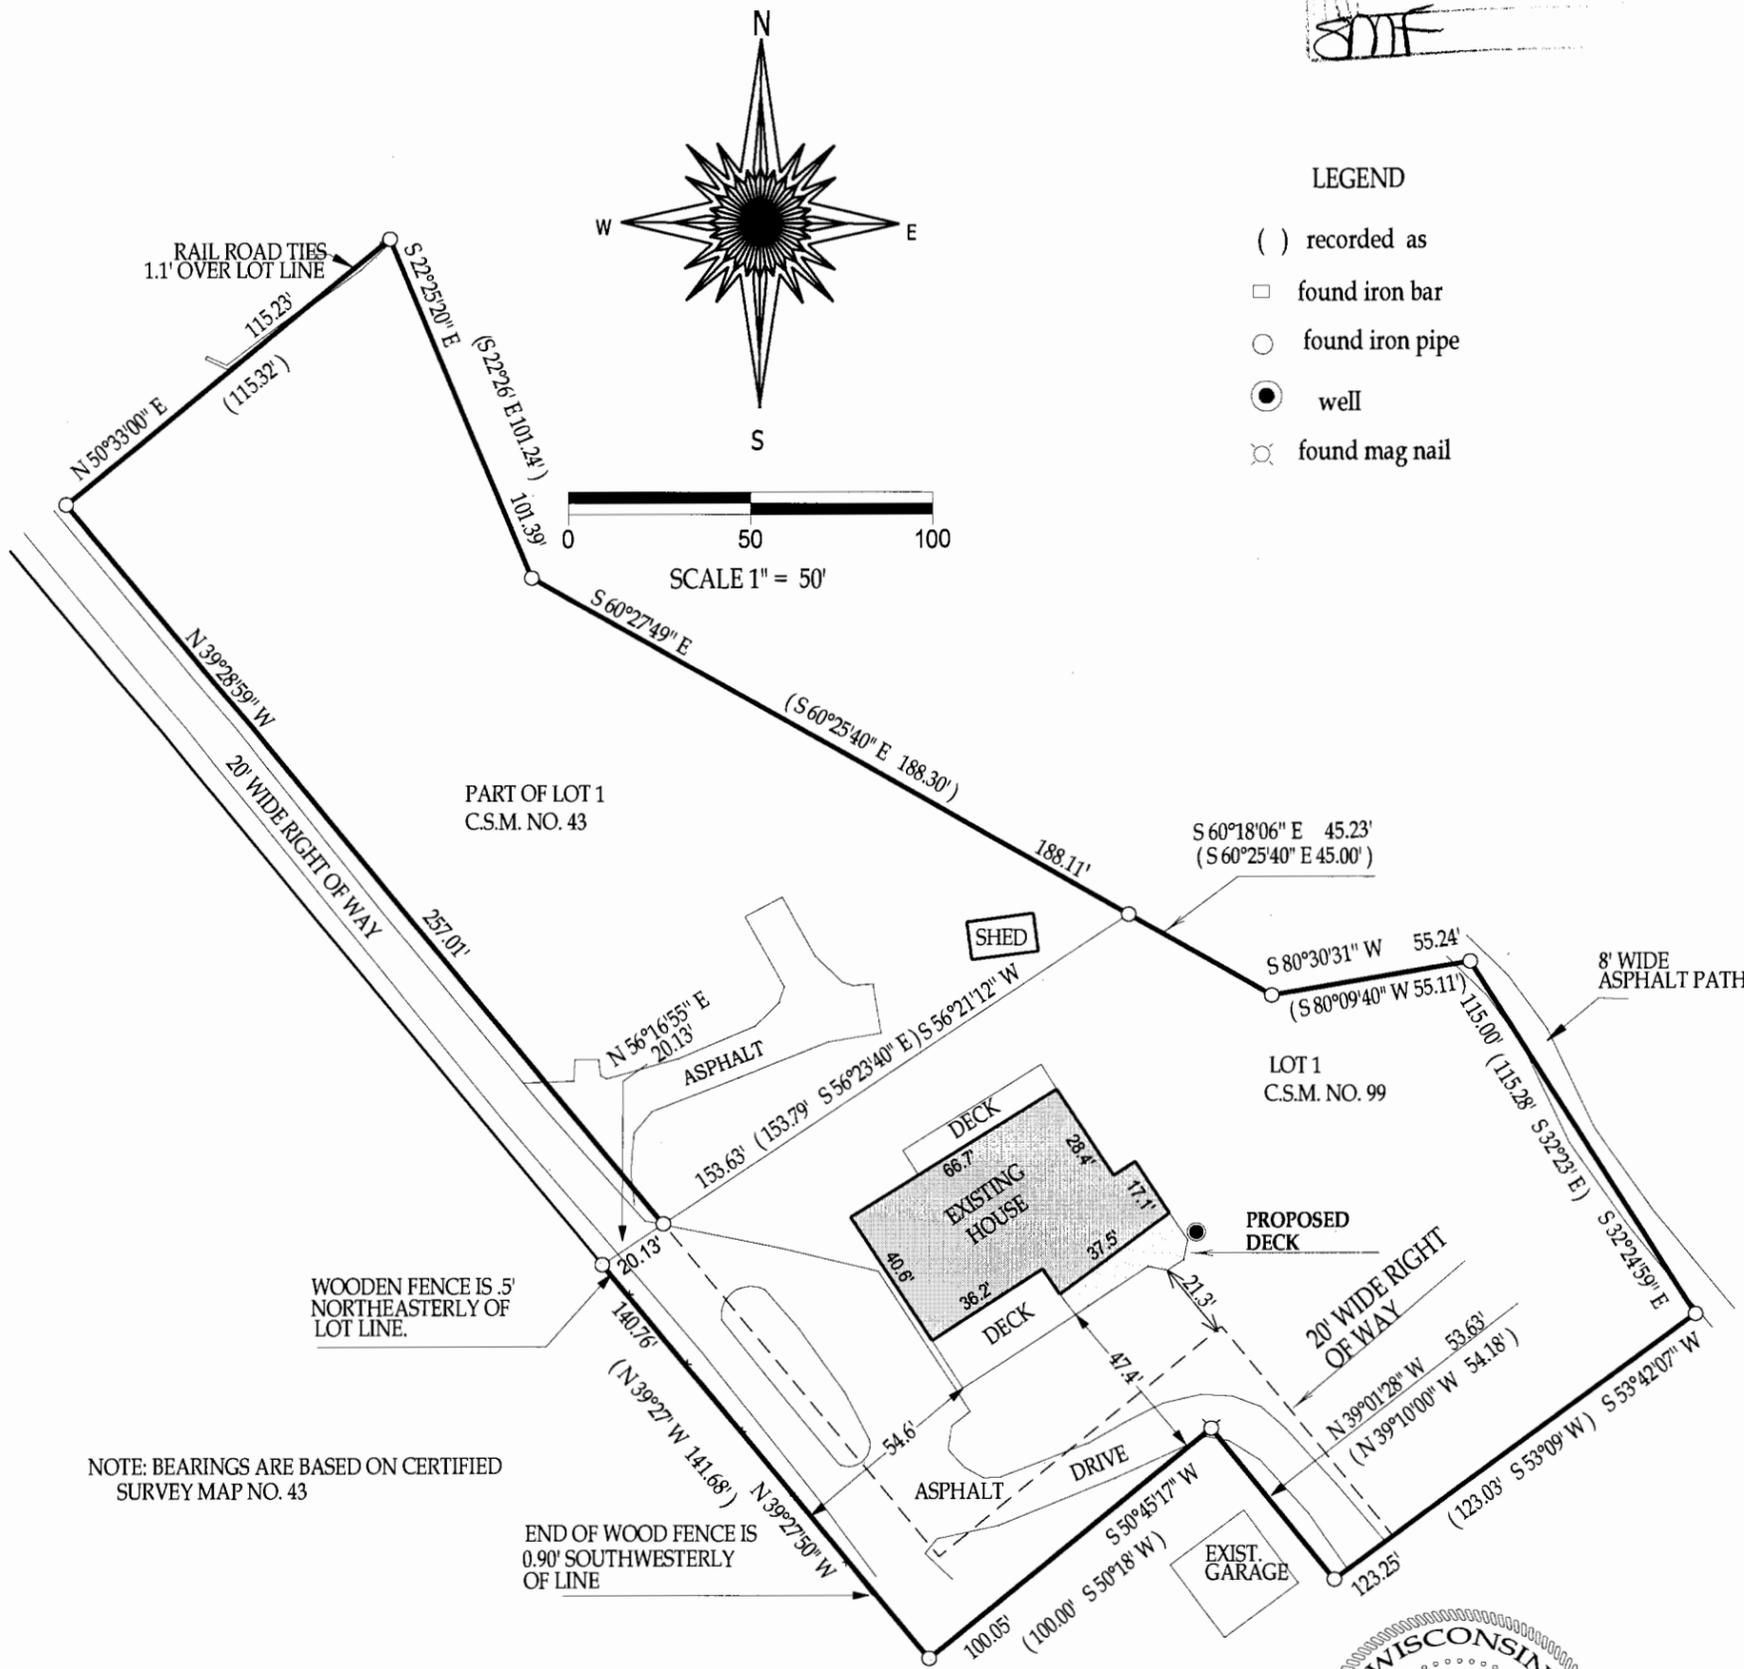

LEGEND

- () recorded as
- found iron bar
- found iron pipe
- well
- ⊗ found mag nail

NOTE: BEARINGS ARE BASED ON CERTIFIED SURVEY MAP NO. 43

COMPARE LEGAL DESCRIPTION ABOVE AND DRAWING WITH DEED. FOR BUILDING RESTRICTIONS AND EASEMENTS NOT SHOWN, REFER TO DEED. ABSTRACT SOURCES AND LOCAL MUNICIPAL CODES. NOTIFY THE SURVEYOR IMMEDIATELY OF ANY DISCREPANCY.

"I hereby certify that I have surveyed the above described property and that the above map is a true representation thereof and shows the size and location of all visible structures, apparent easements and encroachments if any."
 This survey is made for the present owners of the property, and those who purchase, mortgage, or guarantee the title thereto, within one year from the date hereof.

DATED THIS 17th, DAY OF JUNE, 1997

DATE OF LAST REVISION: 7/12/2006

John P. Krott
 JOHN KROTT S - 2258
 Wisconsin Registered Land Surveyor
 (original if signed in red)



JOB NUMBER 970324 / IA-990001 & IA-430001

117-2704