


FARRIS, HANSEN & ASSOCIATES, INC.
ENGINEERING — ARCHITECTURE — SURVEYING
7 RIDGWAY COURT — P.O. BOX 437 — ELKHORN, WISCONSIN 53121
PHONE: (262) 723-2098 FAX: (262) 723-5886
PLAT OF SURVEY


Recd
10/18/06
SMF

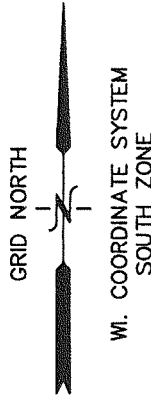


THE LAND REFERRED TO IN THIS POLICY IS DESCRIBED AS FOLLOWS:
Lot 1 of Certified Survey Map No. 3905, recorded in the office of the Register of Deeds for Walworth County, Wisconsin on February 24, 2006 in Volume 24 of Certified Survey Maps on Pages 10-13, as Document No. 669211, located in the NE 1/4 of the SW 1/4 and part of the NW 1/4 and NE 1/4 of the SE 1/4 of Section 33, Town 1 North, Range 17 East, Town of Linn, Walworth County, Wisconsin and an Affidavit of Correction recorded as Document No. 674454.

— WORK ORDERED BY —
LUANN SMITH
PO BOX 460
LAKE GENEVA, WI. 53147

MOHAWK ROAD 66' WDE ROW

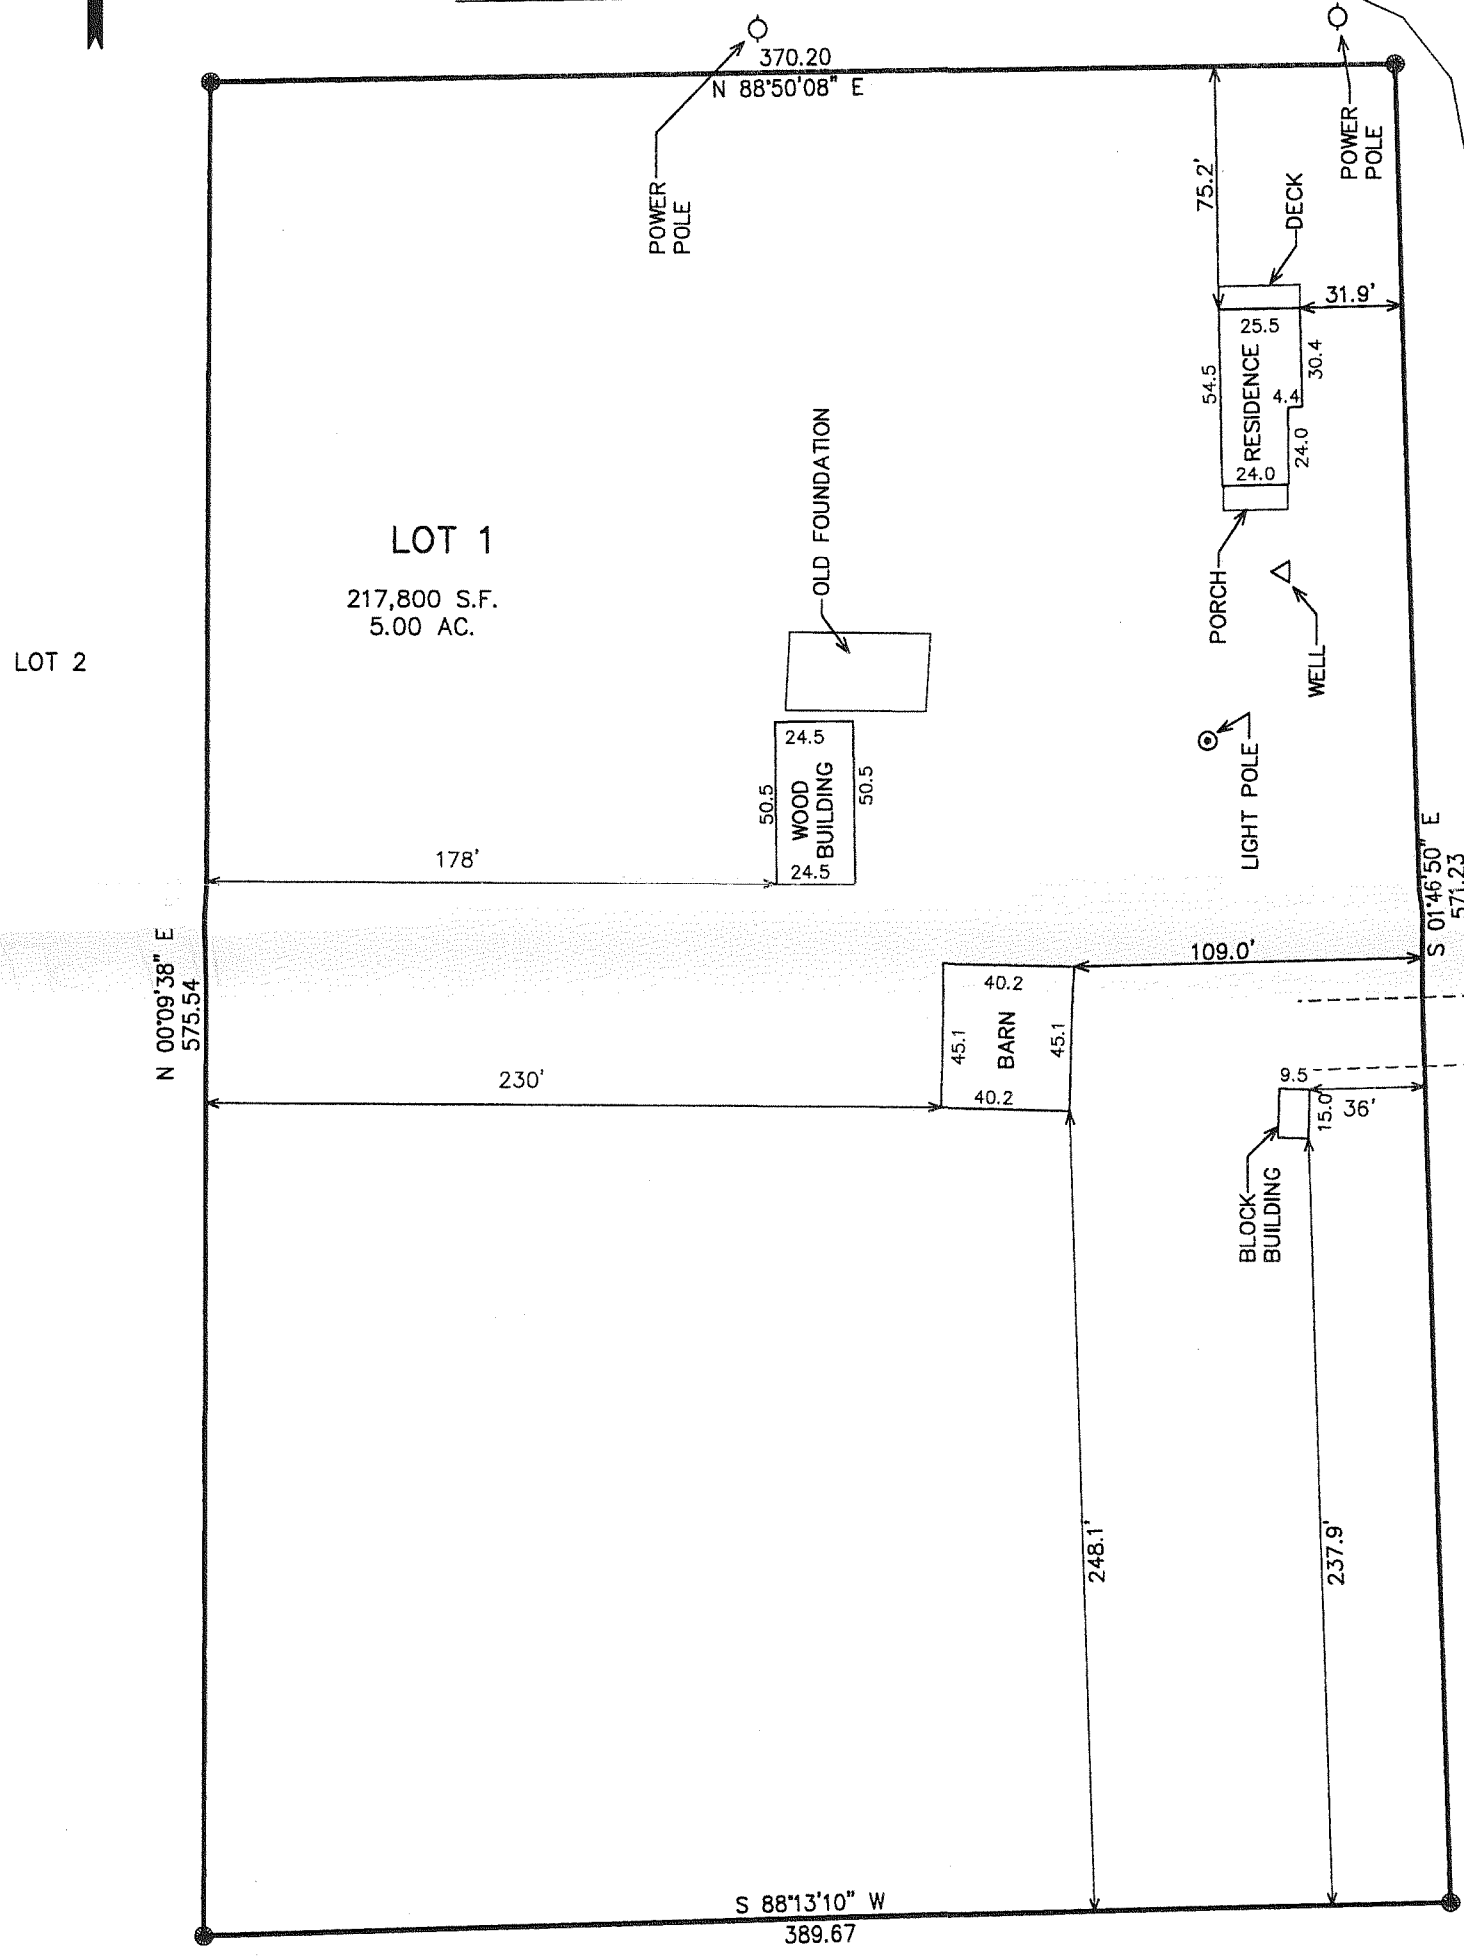

NOTE: THE LOCATION OF THE SEPTIC SYSTEM AREA IS NOT APPARENT.

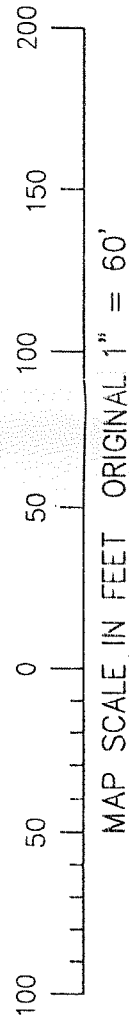


LEGEND
● = FOUND IRON REBAR STAKE

NOTE: COPIES OF THIS MAP TO WHICH THE FOLLOWING CERTIFICATE WILL APPLY SHOW SURVEYOR'S ORIGINAL SEAL AND SIGNATURE IN RED INK. COPIES BY ANY OTHER MEANS MAY HAVE ALTERATIONS WHICH DO NOT REPRESENT THE SURVEYOR'S WORK PRODUCT.

I HEREBY CERTIFY THAT THE ABOVE DESCRIBED PROPERTY HAS BEEN SURVEYED UNDER MY DIRECTION AND THAT THE ABOVE MAP IS A TRUE REPRESENTATION THEREOF AND SHOWS THE SIZE AND LOCATION OF THE PROPERTY, ITS EXTERIOR BOUNDARIES, THE LOCATION OF ALL VISIBLE STRUCTURES, AND DIMENSIONS OF ALL PRINCIPLE BUILDINGS THEREON, BOUNDARY FENCES, APPARENT EASEMENTS, ROADWAYS, AND VISIBLE ENCROACHMENTS, IF ANY. THIS SURVEY IS MADE FOR THE USE OF THE PRESENT OWNERS OF THE PROPERTY, AND ALSO THOSE WHO PURCHASE, MORTGAGE, OR GUARANTEE THE TITLE THERETO WITHIN ONE YEAR FROM THE DATE HEREOF.

DATED: OCT. 5, 2006

PETER S. GORDON R.L.S. 2101

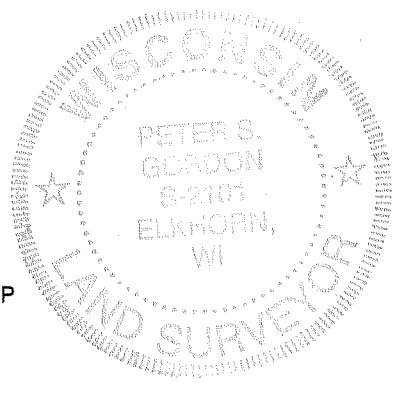

PROJECT: 6948.06.01
DATE: 10-05-2006
SHEET 1 OF 1

10/5/2006 X:\Projects\6948\DCAD\1111\1111.csm3905

IA3905-1

117-2718