


HAROLD H. KOLB

REGISTERED PROFESSIONAL LAND SURVEYOR
LAKE GENEVA, WISCONSIN

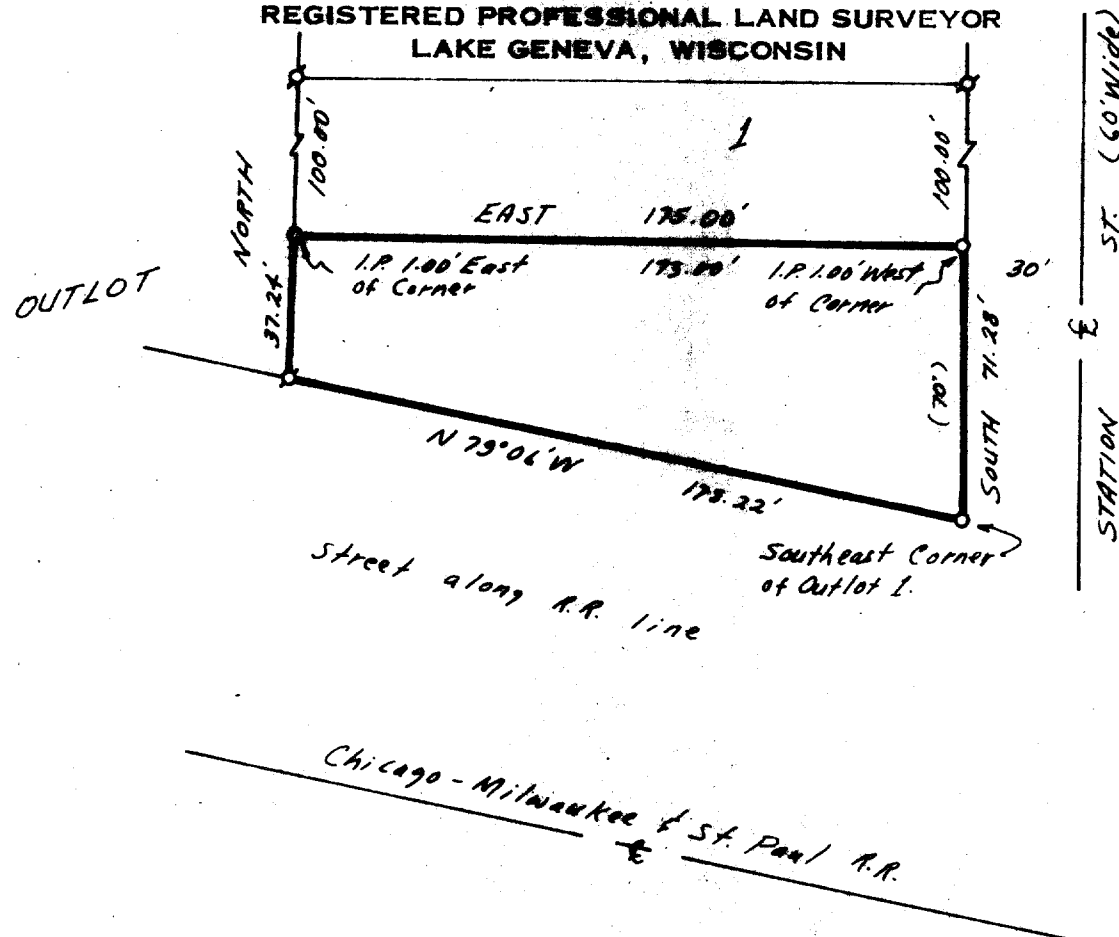

SCALE: 1" = 50'

LEGEND

- - IRON PIPE FOUND
- - IRON PIPE PLACED
- - CONCRETE MONUMENT
- x - SPIKE
- () - As platted

PLAT OF SURVEY OF
A part of Outlot 1, Village of Zenda Subdivision,
located in the Southeast 1/4 of Section 28, T 1 N,
R 17 E, Walworth County, Wisconsin and described
as follows: Beginning at the Southeast Corner
of said Outlot 1, thence N 79° 06' W 178.22 feet;
thence North 37.24 feet; thence East 175.00 feet;
thence South 71.28 feet to the place of beginning.
Containing 0.22 acres.

I, HAROLD H. KOLB, DO HEREBY CERTIFY THAT I HAVE
SURVEYED THE PROPERTY HEREON DESCRIBED ACCORDING
TO THE OFFICIAL RECORDS, AND THAT THE PLAT HEREON
IS A CORRECT REPRESENTATION OF THE LOT LINES.



Harold H. Kolb
HAROLD H. KOLB
WISCONSIN REGISTERED LAND SURVEYOR, S-187
DATE April 28, 1971

Z-31

117-272