
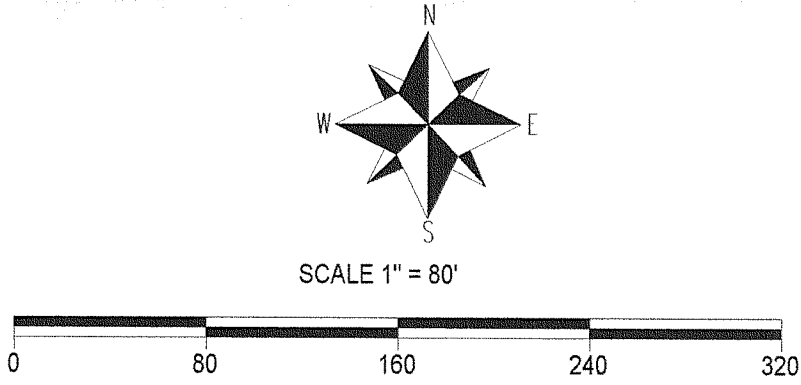
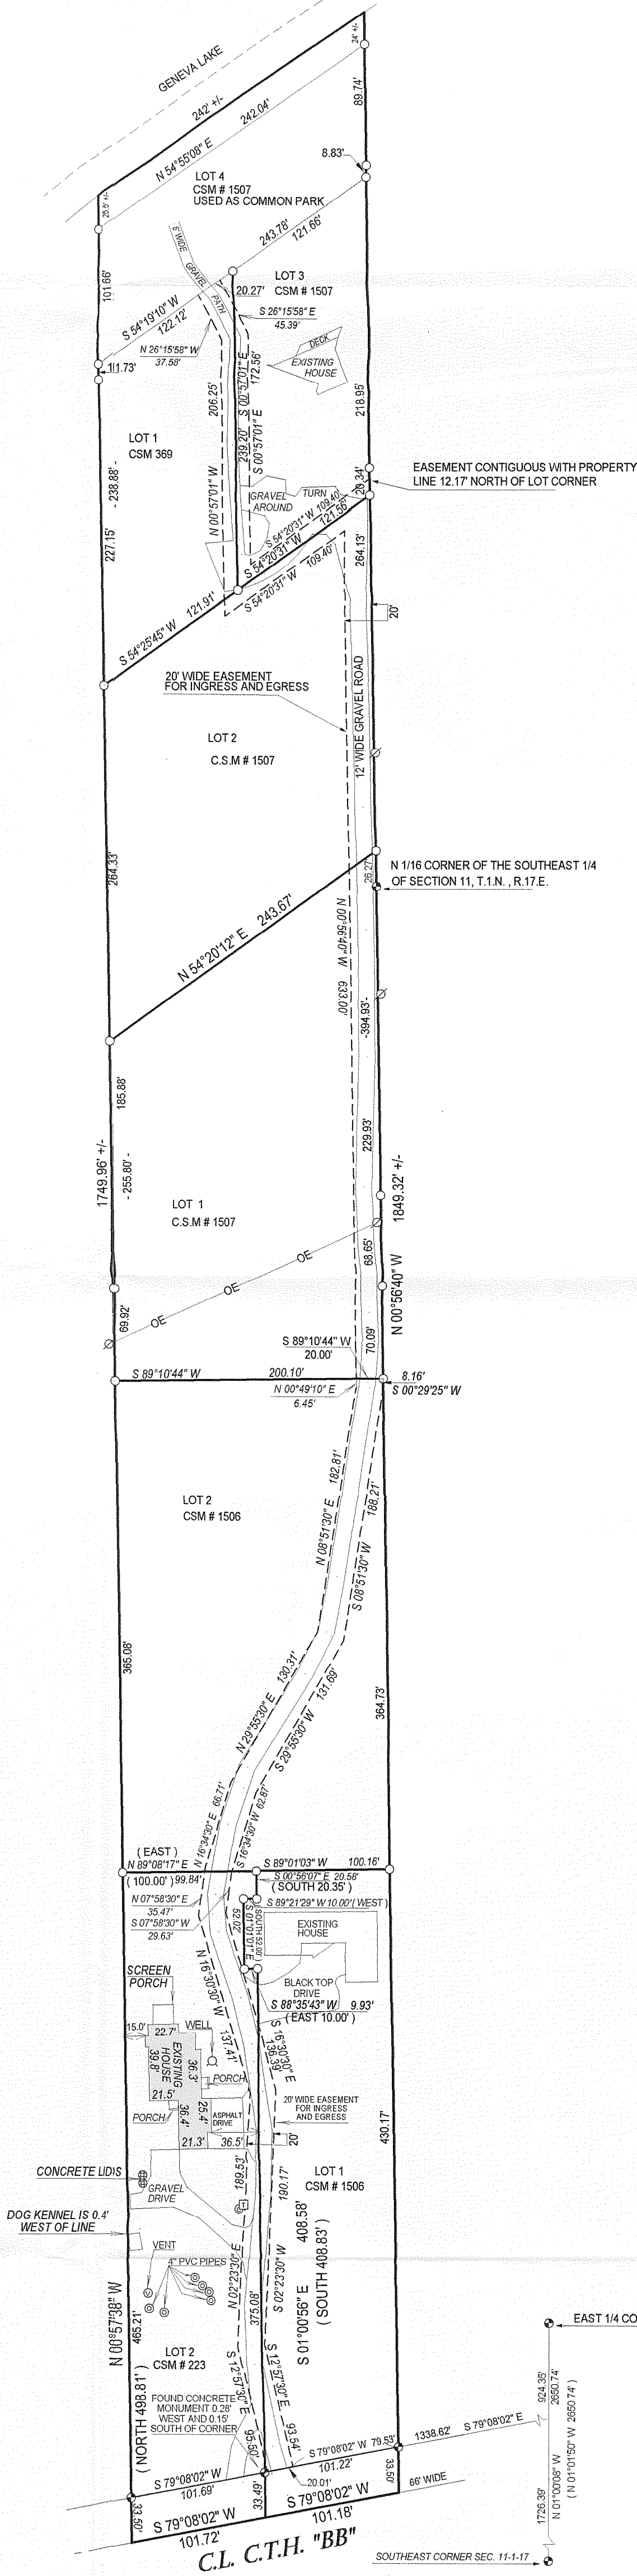
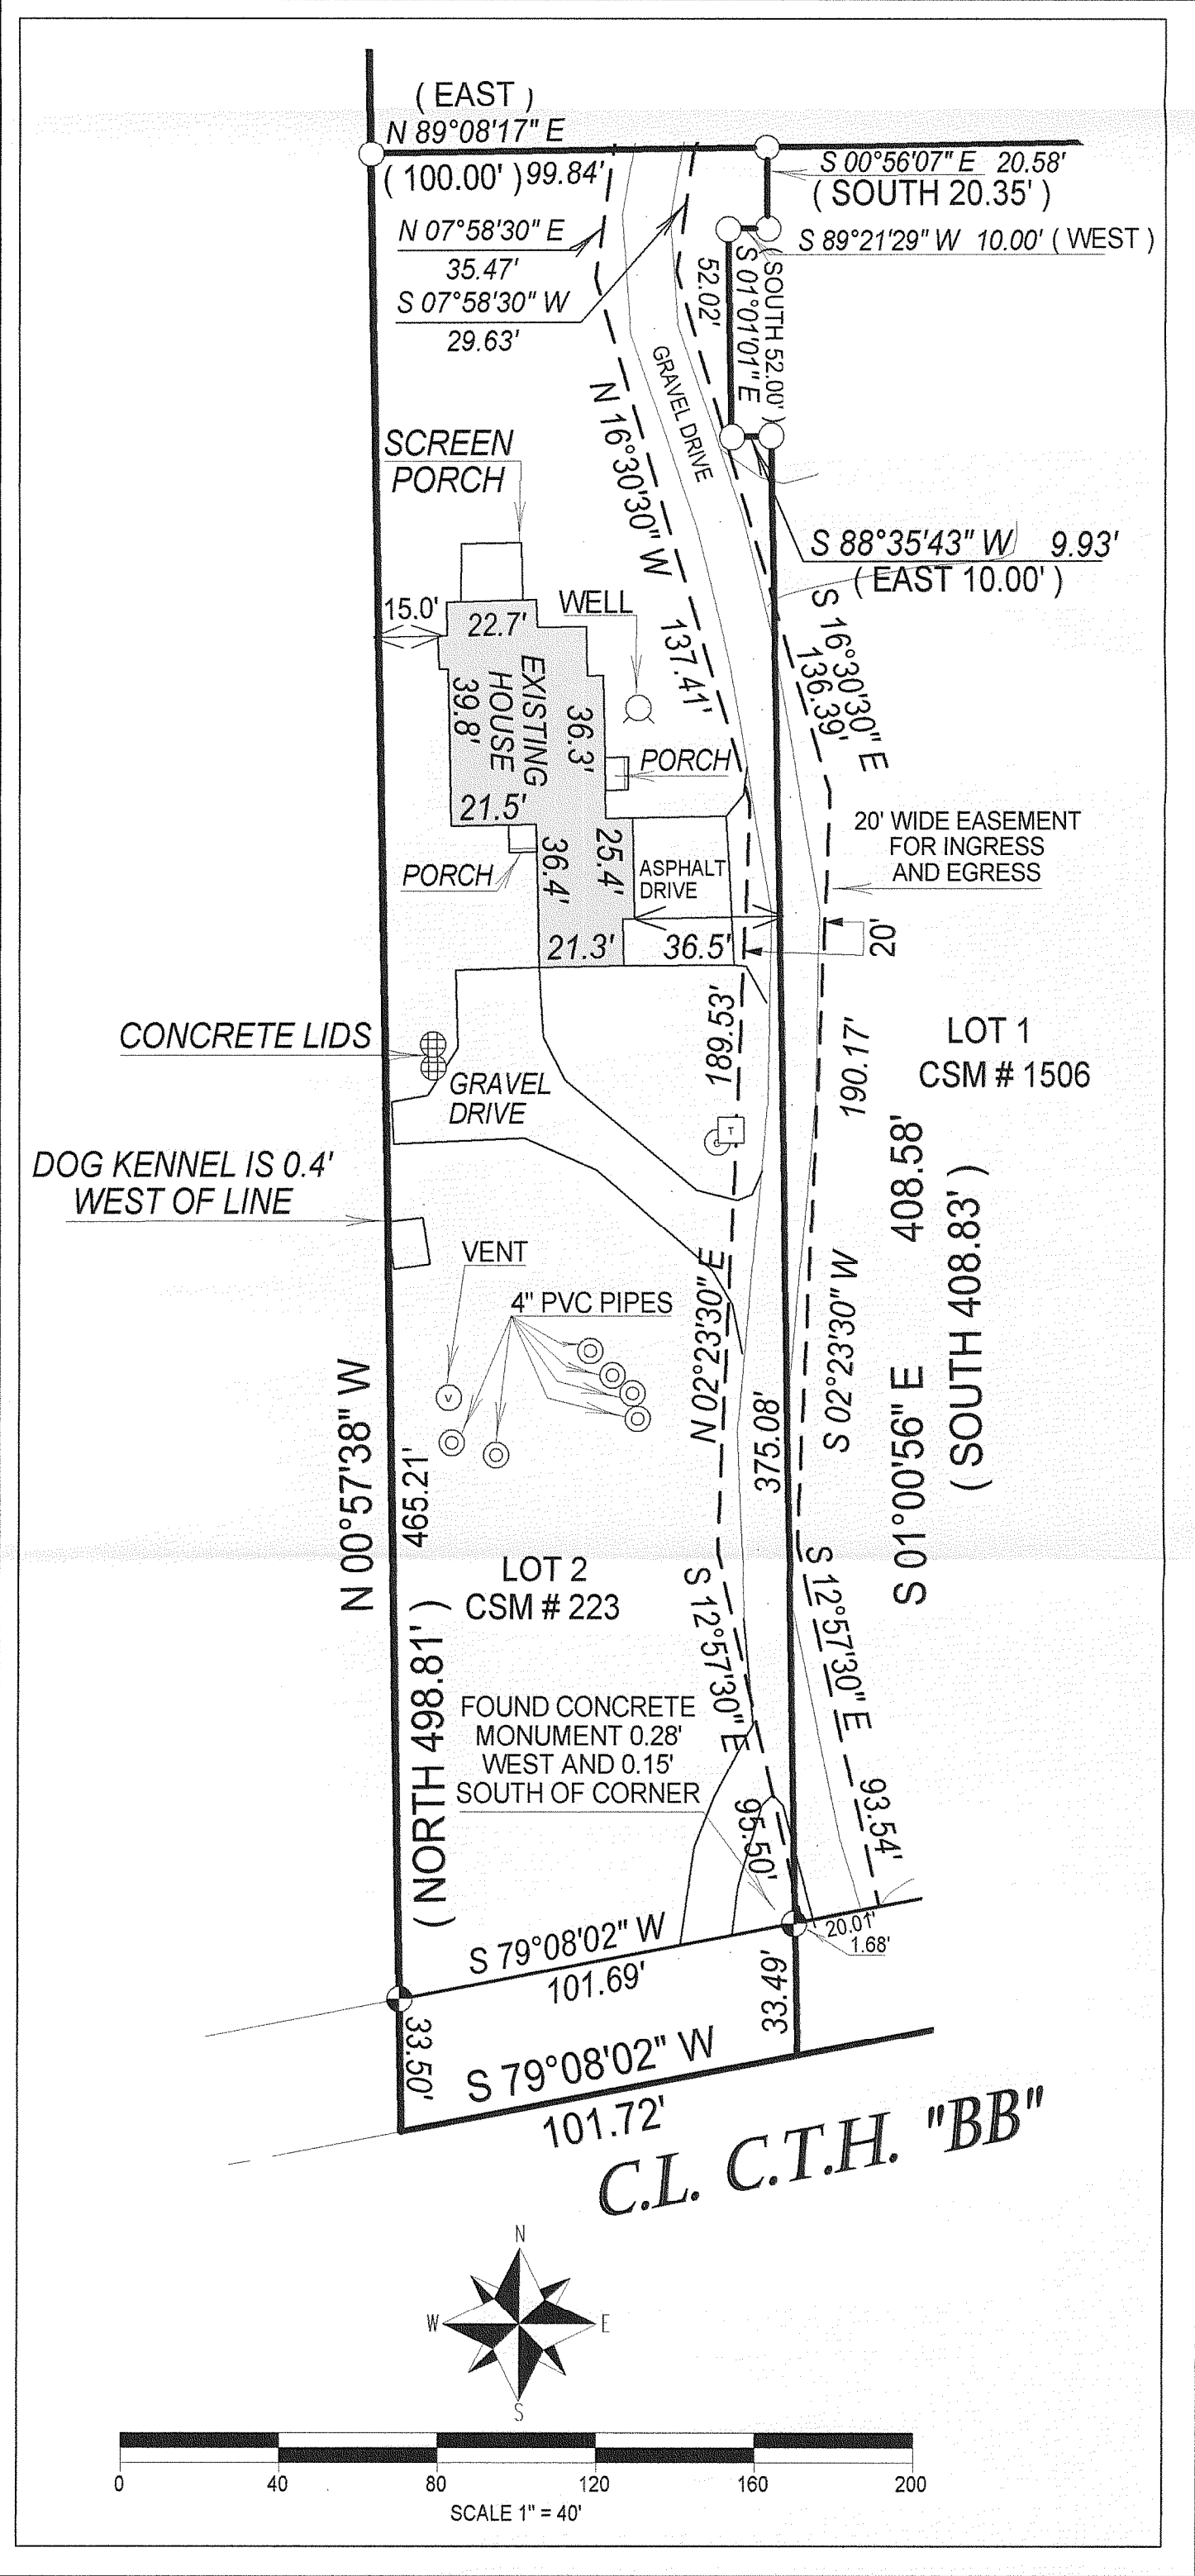


PLAT OF SURVEY

-OF-

LOT 2 OF CERTIFIED SURVEY MAP NO. 223 LOCATED IN THE SOUTHEAST 1/4  
OF SECTION 11, TOWN 1 NORTH, RANGE 17 EAST, WALWORTH COUNTY,  
WISCONSIN.

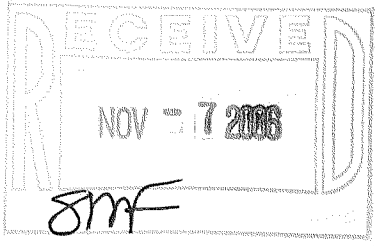


BEARINGS REFERENCED TO CERTIFIED SURVEY MAP NO. 1506

- 5" concrete monument w / iron pin
- ( ) = recorded as
- found iron bar
- found iron pipe
- set iron pipe
- set iron bar
- power pole
- TRANSFORMER
- CABLE PEDISTAL

COMPARE LEGAL DESCRIPTION ABOVE AND DRAWING WITH DEED. FOR BUILDING RESTRICTIONS AND  
EASEMENTS NOT SHOWN REFER TO DEED. ABSTRACT SOURCES AND LOCAL MUNICIPAL CODES. NOTIFY  
THE SURVEYOR IMMEDIATELY OF ANY DISCREPANCY.

"I hereby certify that I have surveyed the above described property and that  
the above map, to the best of my knowledge and belief, is a true representation  
thereof and shows the size and location of all visible structures, apparent  
easements and encroachments if any."  
This survey is made for the present owners of the property, and those who  
purchase, mortgage, or guarantee the title thereto, within one year from  
the date hereof.

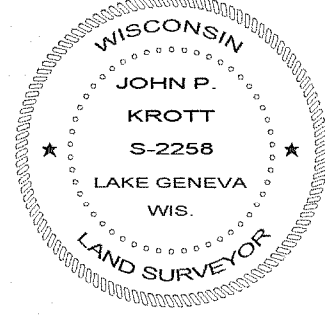

JOHN KROTT S - 2258  
Wisconsin Registered Land Surveyor  
(original if signed in red)  
DATE OF LAST REVISION 8-29-06  
DATE: 6-29-1998  
JOB NUMBER: 98099 1-17-JA22300002