


Lot 3 of Certified Survey Map No. 3905, recorded in the office of the Register of Deeds for Walworth County, Wisconsin on February 24, 2006 in Volume 24 of Certified Survey Maps on Pages 10-13, as Document No. 669211, located in the NE 1/4 of the SW 1/4 and part of the NW 1/4 and NE 1/4 of the SE 1/4 of Section 33, Town 1 North, Range 17 East, Town of Linn, Walworth County, Wisconsin and an Affidavit of Correction recorded as Document No. 674454.

GRID NORTH

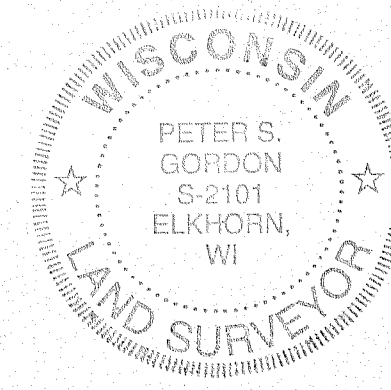

I HEREBY CERTIFY THAT THE ABOVE DESCRIBED PROPERTY HAS BEEN SURVEYED UNDER MY DIRECTION AND THAT THE ABOVE MAP IS A TRUE REPRESENTATION THEREOF AND SHOWS THE SIZE AND LOCATION OF THE PROPERTY, ITS EXTERIOR BOUNDARIES, THE LOCATION OF ALL VISIBLE STRUCTURES, AND DIMENSIONS OF ALL PRINCIPLE BUILDINGS THEREON, BOUNDARY FENCES, APPARENT EASEMENTS, ROADWAYS, AND VISIBLE ENCROACHMENTS, IF ANY. THIS SURVEY IS MADE FOR THE USE OF THE PRESENT OWNERS OF THE PROPERTY, AND ALSO THOSE WHO PURCHASE, MORTGAGE, OR GUARANTEE THE TITLE THERETO WITHIN ONE YEAR FROM THE DATE HEREOF.

DATE: NOVEMBER 6, 2008



PETER S. GORDON R.L.S. 2101

REVISIONS

PROJECT NO. 6948.6.3
DATE: 11-01-06
SHEET NO. 1 OF 1

11/6/2006 X:\Projects\6948\DCAD\LOT3

1A3905-3

117-2742