



of

Parcel 1: Lot 19 of Elgin Club Subdivision, according to the recorded plat thereof, Town of Linn, Walworth County, Wisconsin.

Surveyed for: **Keefe Real Estate, Inc.**
751 Geneva Parkway
P.O. Box 460
Lake Geneva, Wisconsin. 53147

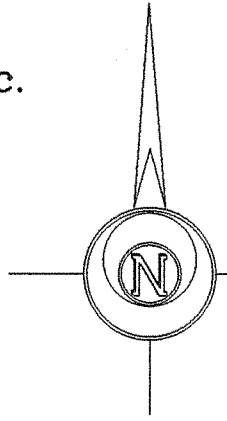

bearings reference to the
plat of Elgin Club.

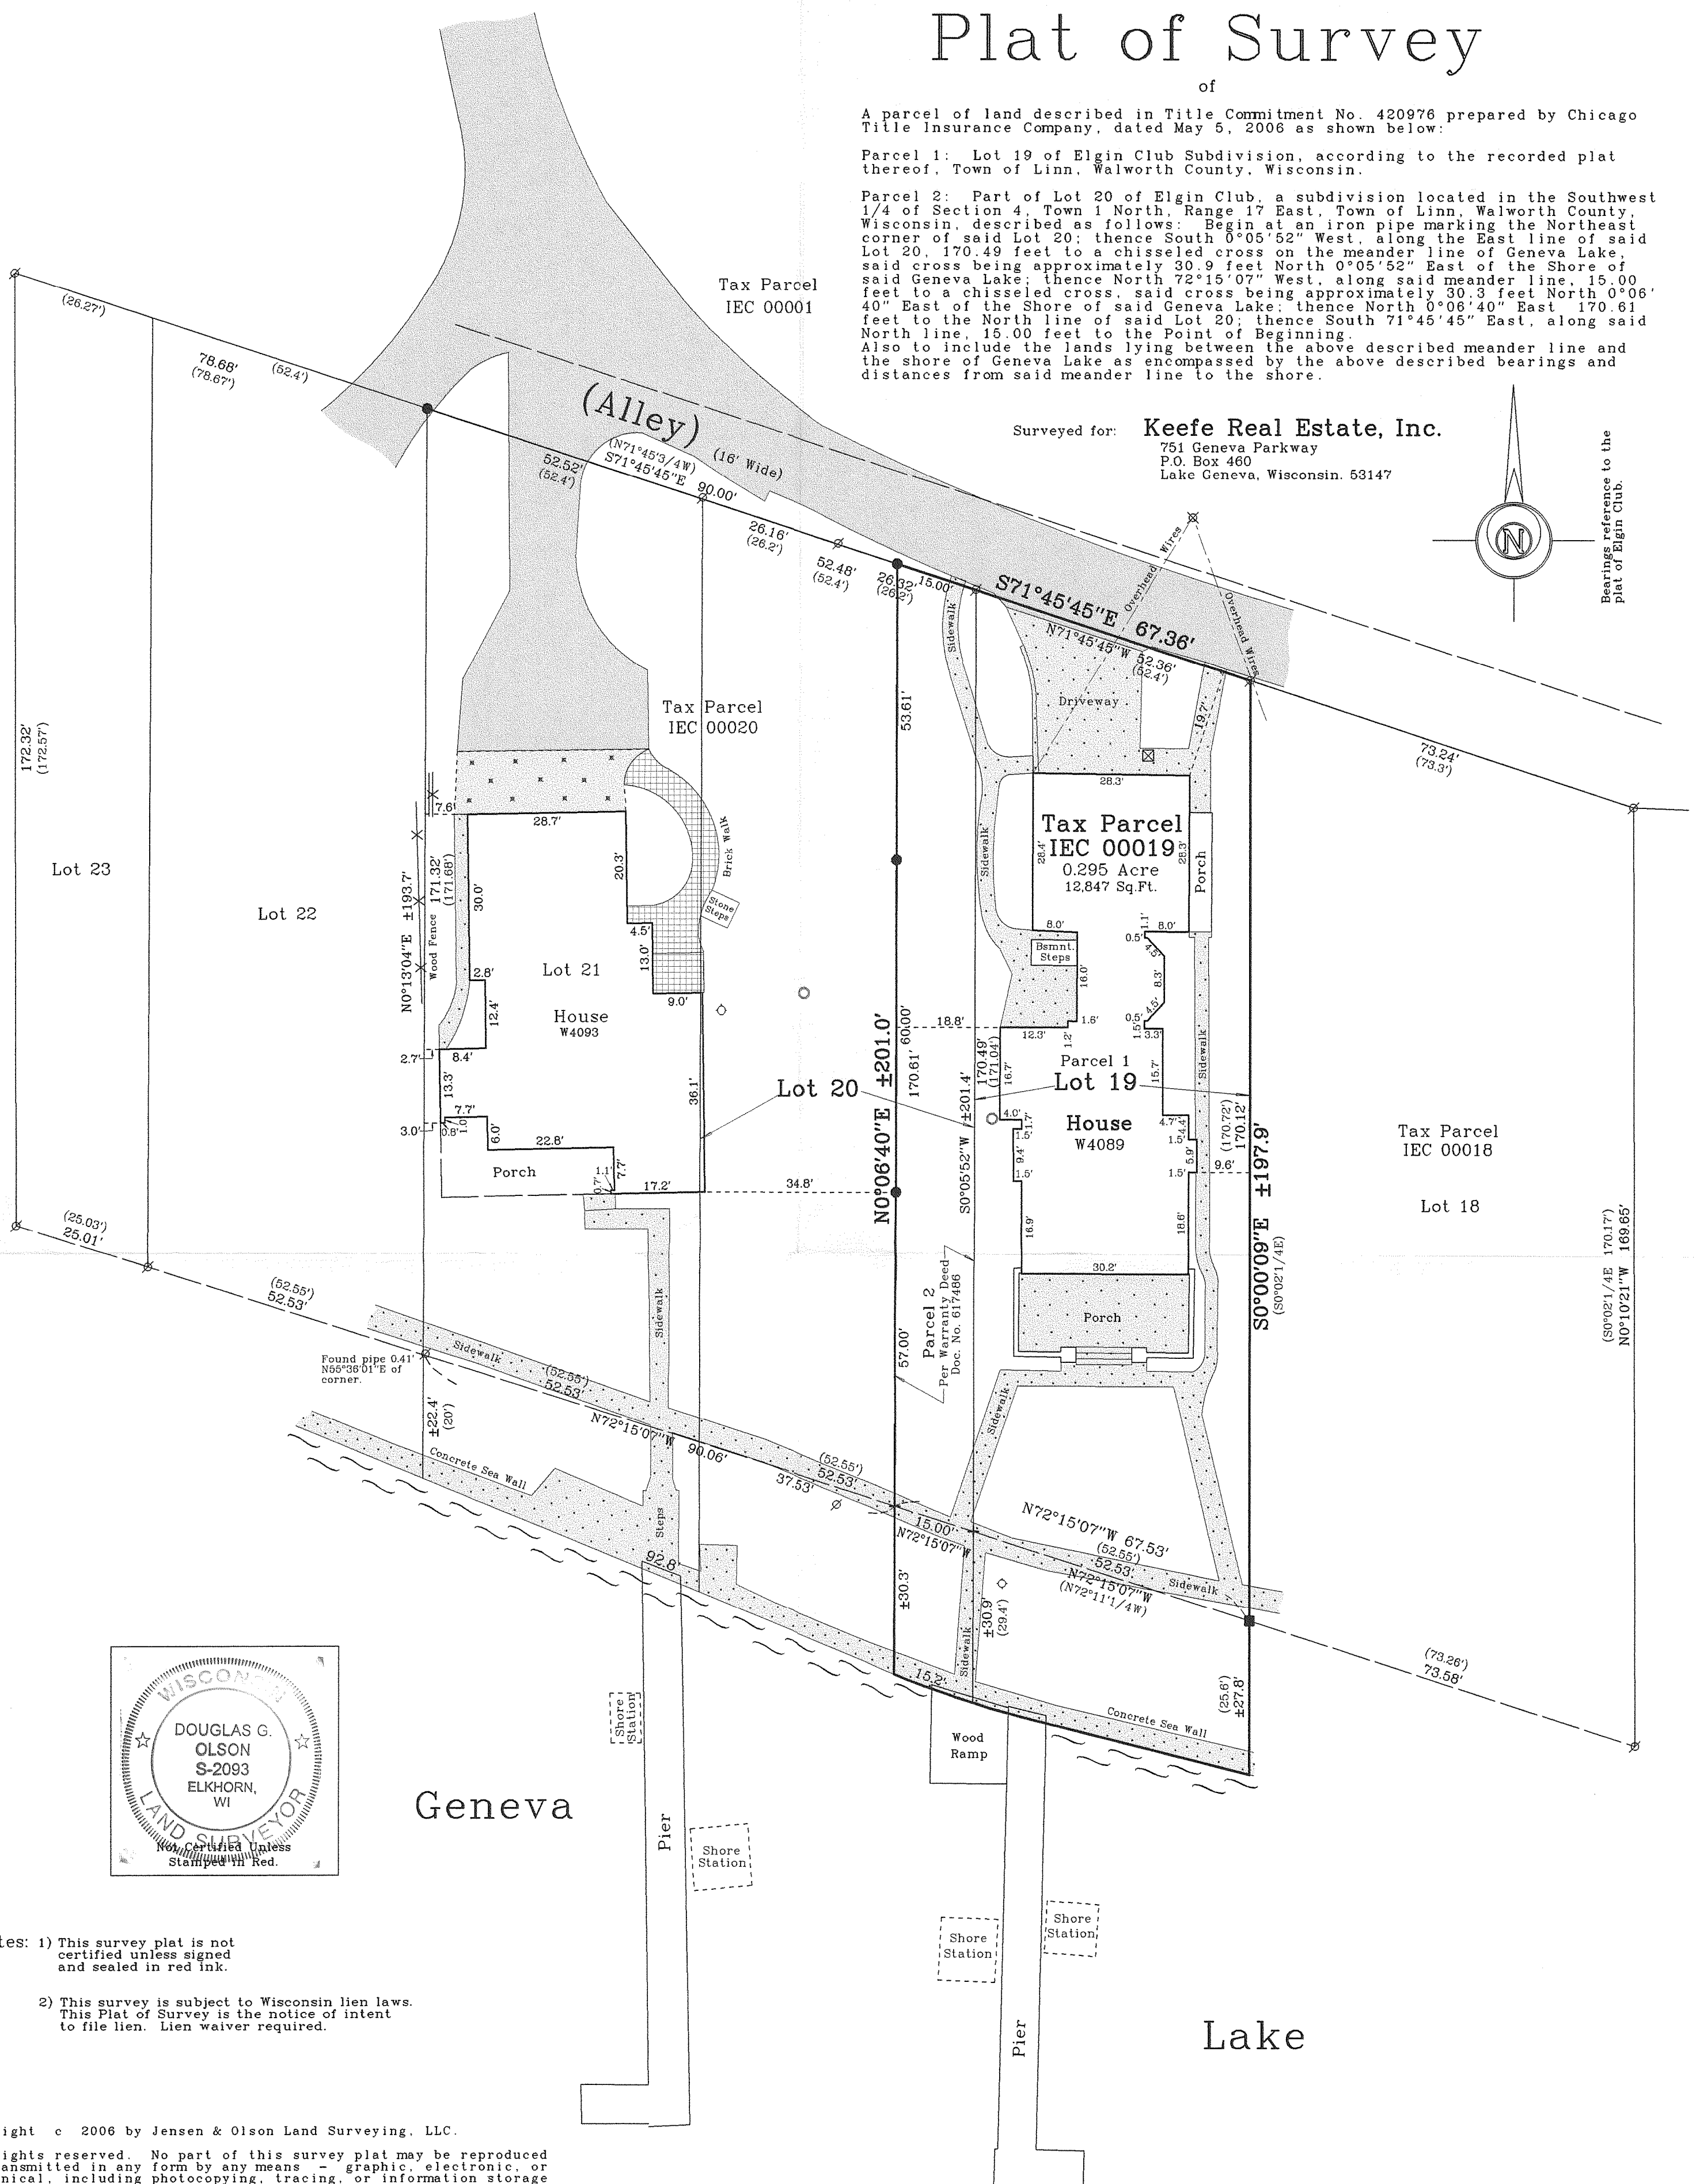

Notes: 1) This survey plat is not certified unless signed and sealed in red ink.


2) This survey is subject to Wisconsin lien laws. This Plat of Survey is the notice of intent to file lien. Lien waiver required.

Copyright © 2006 by Jensen & Olson Land Surveying, LLC.
All rights reserved. No part of this survey plat may be reproduced or transmitted in any form by any means - graphic, electronic, or mechanical, including photocopying, tracing, or information storage and retrieval systems - without permission in writing from Douglas G. Olson, Jensen & Olson Land Surveying, LLC.

I, Douglas G. Olson, Wisconsin Registered Land Surveyor, do hereby certify that this survey was performed by me or under my direction in full compliance with the provisions of the instructions and Chapter A-E 7 of the Wisconsin Administrative Code "Minimum Standards for Property Surveys"; and that this map is an accurate representation thereof to the best of my knowledge and belief.

Douglas C. Olson
Wisconsin Registered Land Surveyor - 2093

Lake

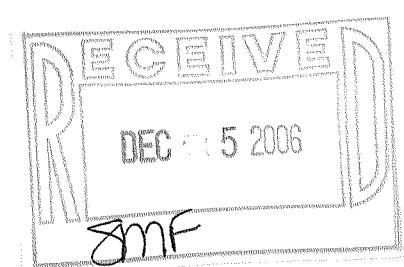


2006.099	Sheet 1 of 1 Sheets	<u>Legend</u>	
	Job Reference Number	☒ Found Stone Monument ☒ Found Iron Pipe ☒ Found Iron Rod	☒ Asphalt ☒ Concrete ☒ Gravel
	2006.099	☒ Found Cross in Concrete ☒ Recorded Information ☒ Cover ☒ Sewer Vent ☒ Lamp ☒ Utility Pole ☒ Catch Basin	



Jensen & Olson Land Surveying, LLC

45 South Wisconsin Street P.O. Box 322
Elkhorn, Wisconsin. 53121
Telephone (262) 723-3434
Facsimile (262) 723-8044

Scale in Feet
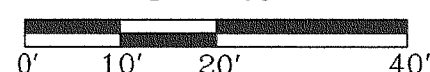
$$1'' = 20'$$


Survey Date: August 16, 2006.
Revisions:

IEC-19

117-2751