

LAND-MARK SURVEYING
Mark L. Miritz
 Wisconsin Registered Land Surveyor S-2582

N9330 Knuteson Drive
 Whitewater, WI 53190
 Phone: (262) 495-3284
 FAX : (262) 495-8421
 LAND-MARKSURVEYING.COM




PLAT OF SURVEY

SOUTH SHORE ROAD 49.5' WIDE
 N 89°07'00" E 327.04'
 (326.98')

LOT 1 OF CERTIFIED SURVEY MAP NO. 658, LOCATED IN THE SOUTHEAST 1/4 OF SECTION 15, TOWN 1 NORTH, RANGE 17 EAST, LINN TOWNSHIP, WALWORTH COUNTY, WISCONSIN.

**OWNERS: JAMES DALEEN
 JUDY DALEEN
 N1607 SHORE HAVEN RD.
 FONTANA, WI. 53125**

**ORDERED BY: KEBBEKUS CARPENTRY
 DAN KEBBEKUS
 P.O. BOX 13
 FONTANA, WI 53125**

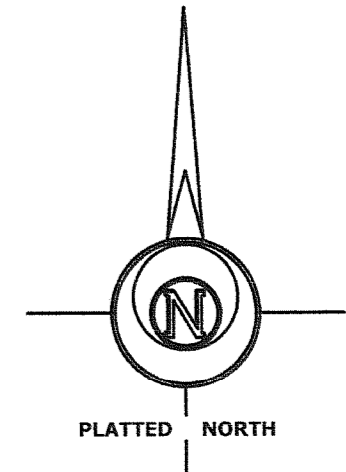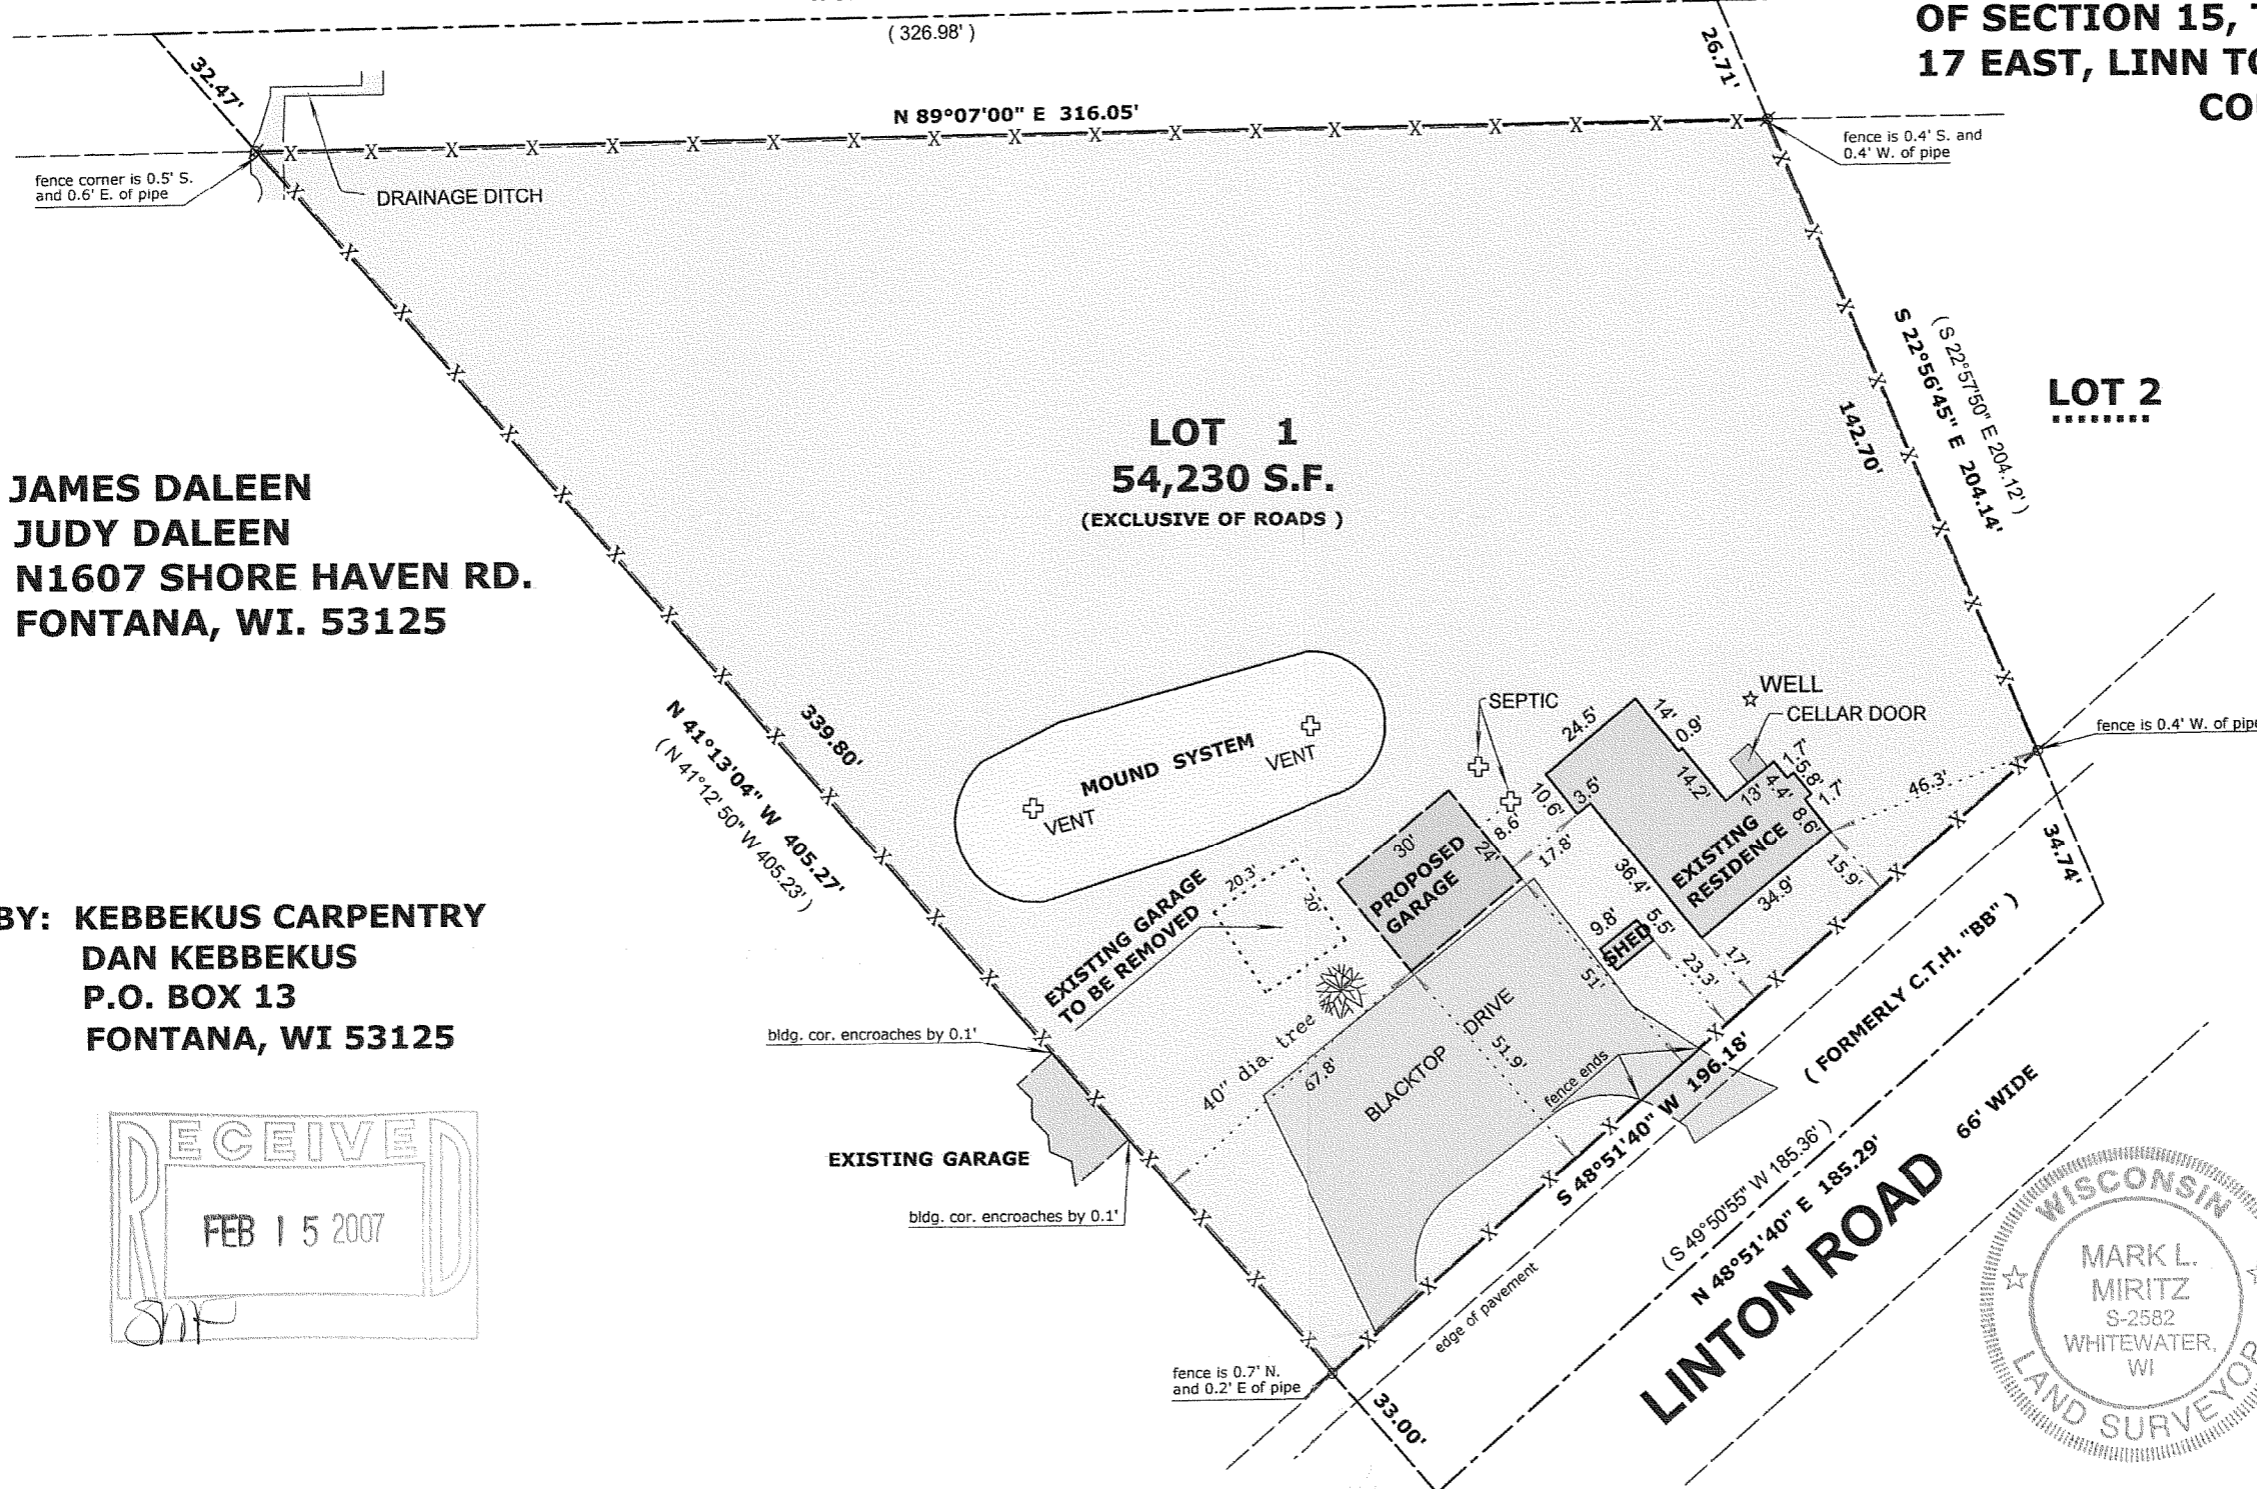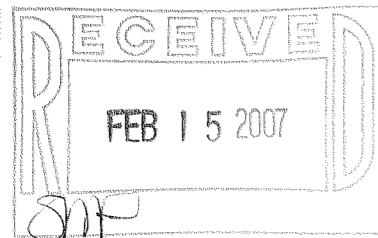


- LEGEND**
- FOUND IRON PIPE
 - FOUND IRON ROD
 - FOUND COUNTY MONUMENT
 - FOUND CONCRETE MONUMENT
 - CHISEL CUT IN CONCRETE
 - SET IRON ROD, 24" LONG, WEIGHING 1.5 LBS./LINEAL FT., 3/4" DIA.
 - (x x) RECORDED AS DIMENSION
 - x — EXISTING FENCE

SCALE: 1" = 40 FEET

"I hereby certify that the above described property has been surveyed by me or under my direction and that the above map is a true representation thereof and shows the size and location of the property, its exterior boundaries, the location of all visible structures and dimensions of all principal buildings thereon, boundary fences, apparent easements, roadways and visible encroachments, if any."
 "This survey is made for the use of the present owners of the property, and also those who purchase, mortgage, or guarantee the title thereto within one year from date hereof."

Mark L. Miritz
MARK L. MIRITZ
 WISCONSIN REGISTERED
 LAND SURVEYOR S-2582

DATE: DEC. 28, 2006 JOB NO. 06.1207

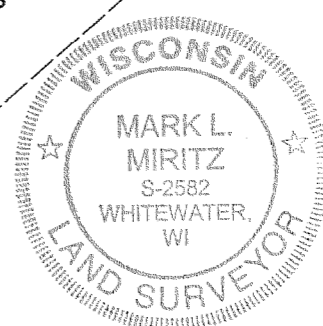

1A658-1

117-2764