

LAND-MARK SURVEYING

Mark L. Miritz

Wisconsin Registered Land Surveyor S-2582



N9330 Knuteson Drive
Whitewater, WI 53190
Phone:(262)495-3284

PLAT OF SURVEY

**LOT 19 OF ALTA VISTA ESTATES, A SUBDIVISION
LOCATED IN GOVERNMENT LOT 1, GOVERNMENT
LOT 2, AND IN THE SE 1/4 OF THE NE 1/4 OF
SECTION 4, TOWN 1 NORTH, RANGE 17 EAST,
LINN TOWNSHIP, WALWORTH COUNTY, WISCONSIN.**

OWNERS:

**JOHN E. SULLIVAN TRUST
VIRGINIA M. SULLIVAN TRUST
1313 CUMBERLAND CIRLCE EAST
ELK GROVE VILLAGE, IL 60007**

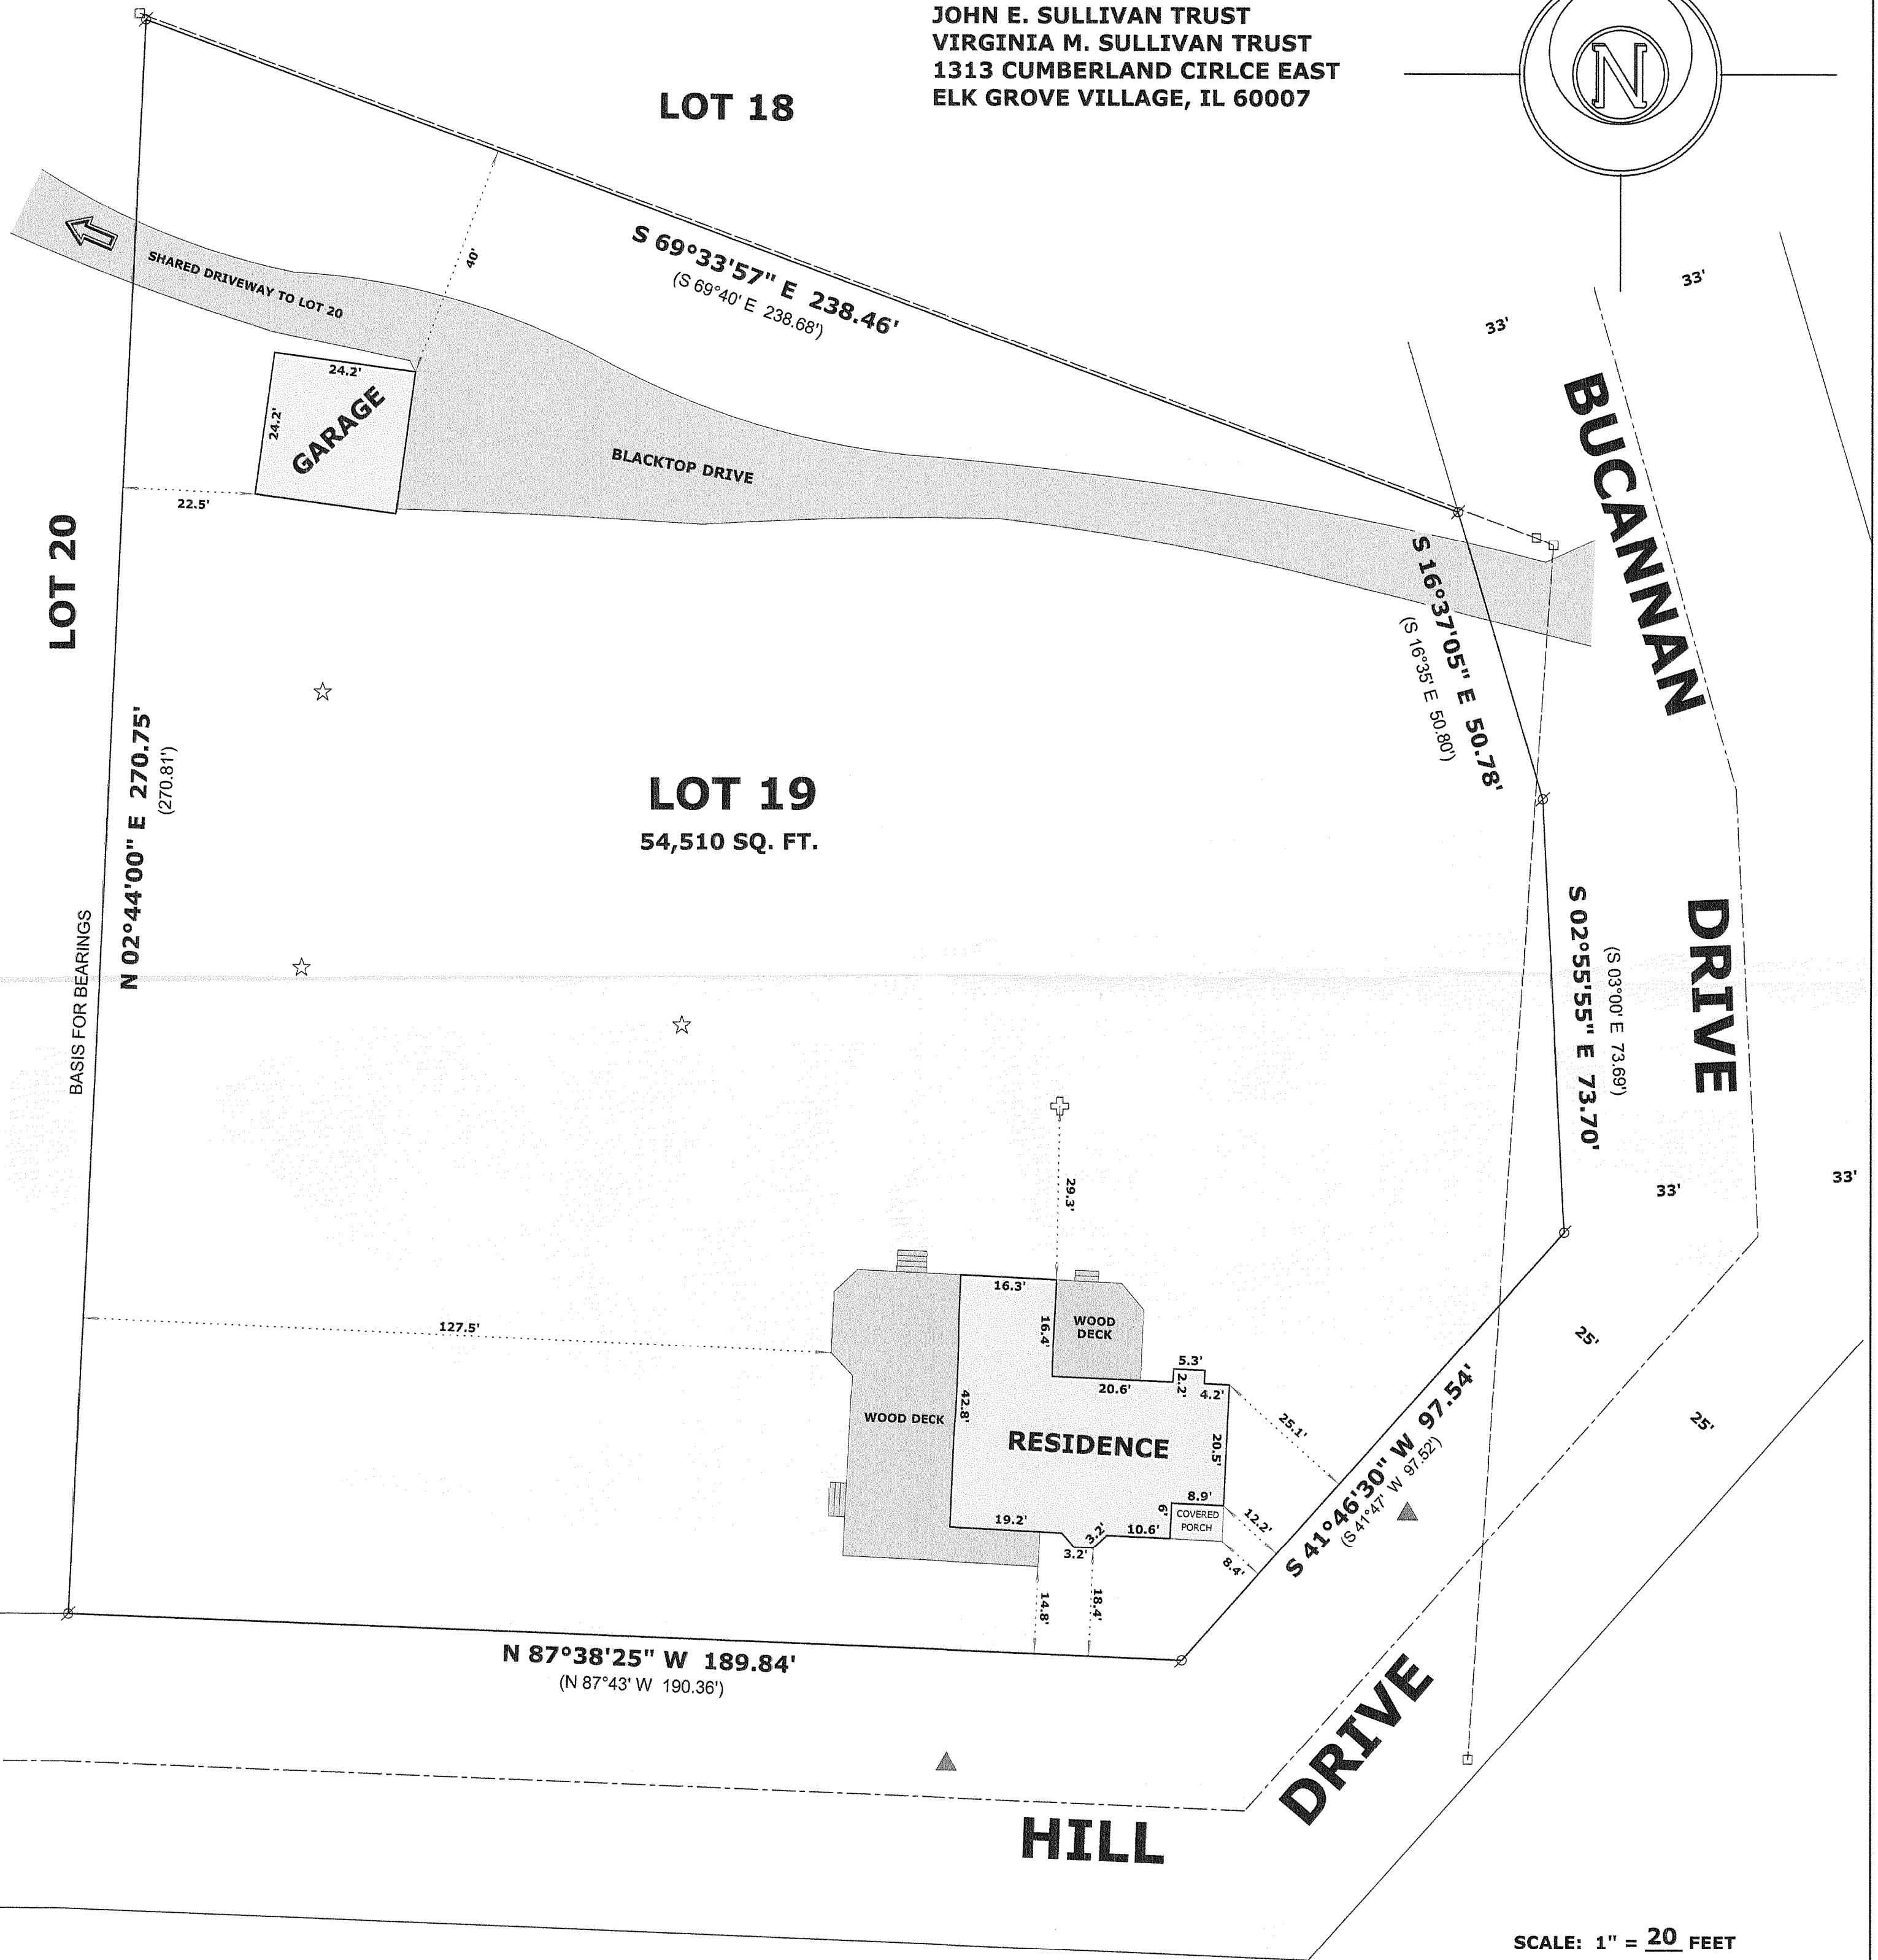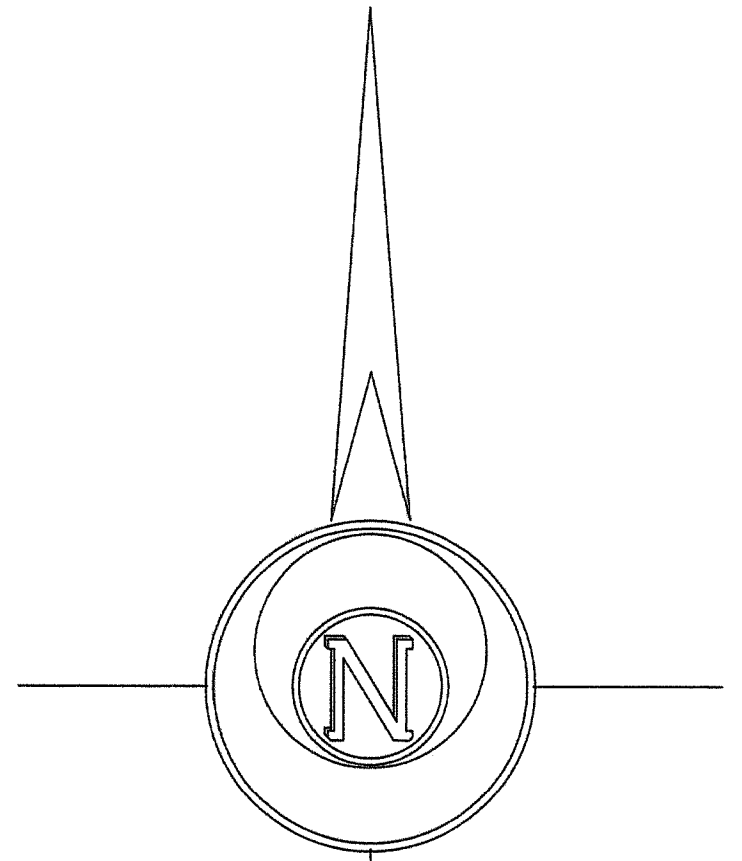


SCALE: 1" = 20 FEET

"I hereby certify that the above described property has been surveyed by me or under my direction and that the above map is a true representation thereof and shows the size and location of the property, its exterior boundaries, the location of all visible structures and dimensions of all principal buildings thereon, boundary fences, apparent easements, roadways and visible encroachments, if any." "This survey is made for the use of the present owners of the property, and also those who purchase, mortgage, or guarantee the title thereto within one year from date hereof."

LEGEND

- ▲ YARD LIGHT
- ⊗ FOUND IRON PIPE
- ⊕ WELL
- ☆ SEPTIC
- (x x) RECORDED AS DIMENSION
- OVERHEAD UTILITY LINES WITH POLES

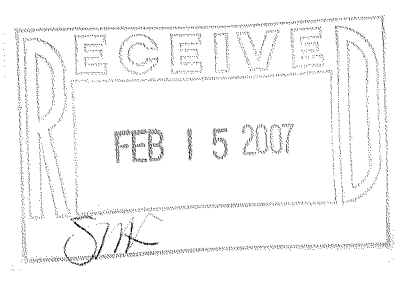

Mark L. Miritz
MARK L. MIRITZ
WISCONSIN REGISTERED
LAND SURVEYOR S-2582

DATE: DEC. 12, 2006 JOB NO. 06.1202

IAV-17

117 2700