


Lot 84 of Robinson's Second Subdivision,
located in the Northwest 1/4 of Section 14, Town 1 North, Range
17 East, Town of Linn, Walworth County, Wisconsin.

Surveyed for: **Sam Desimone**
184 South Street
Elmhurst, Illinois. 60126

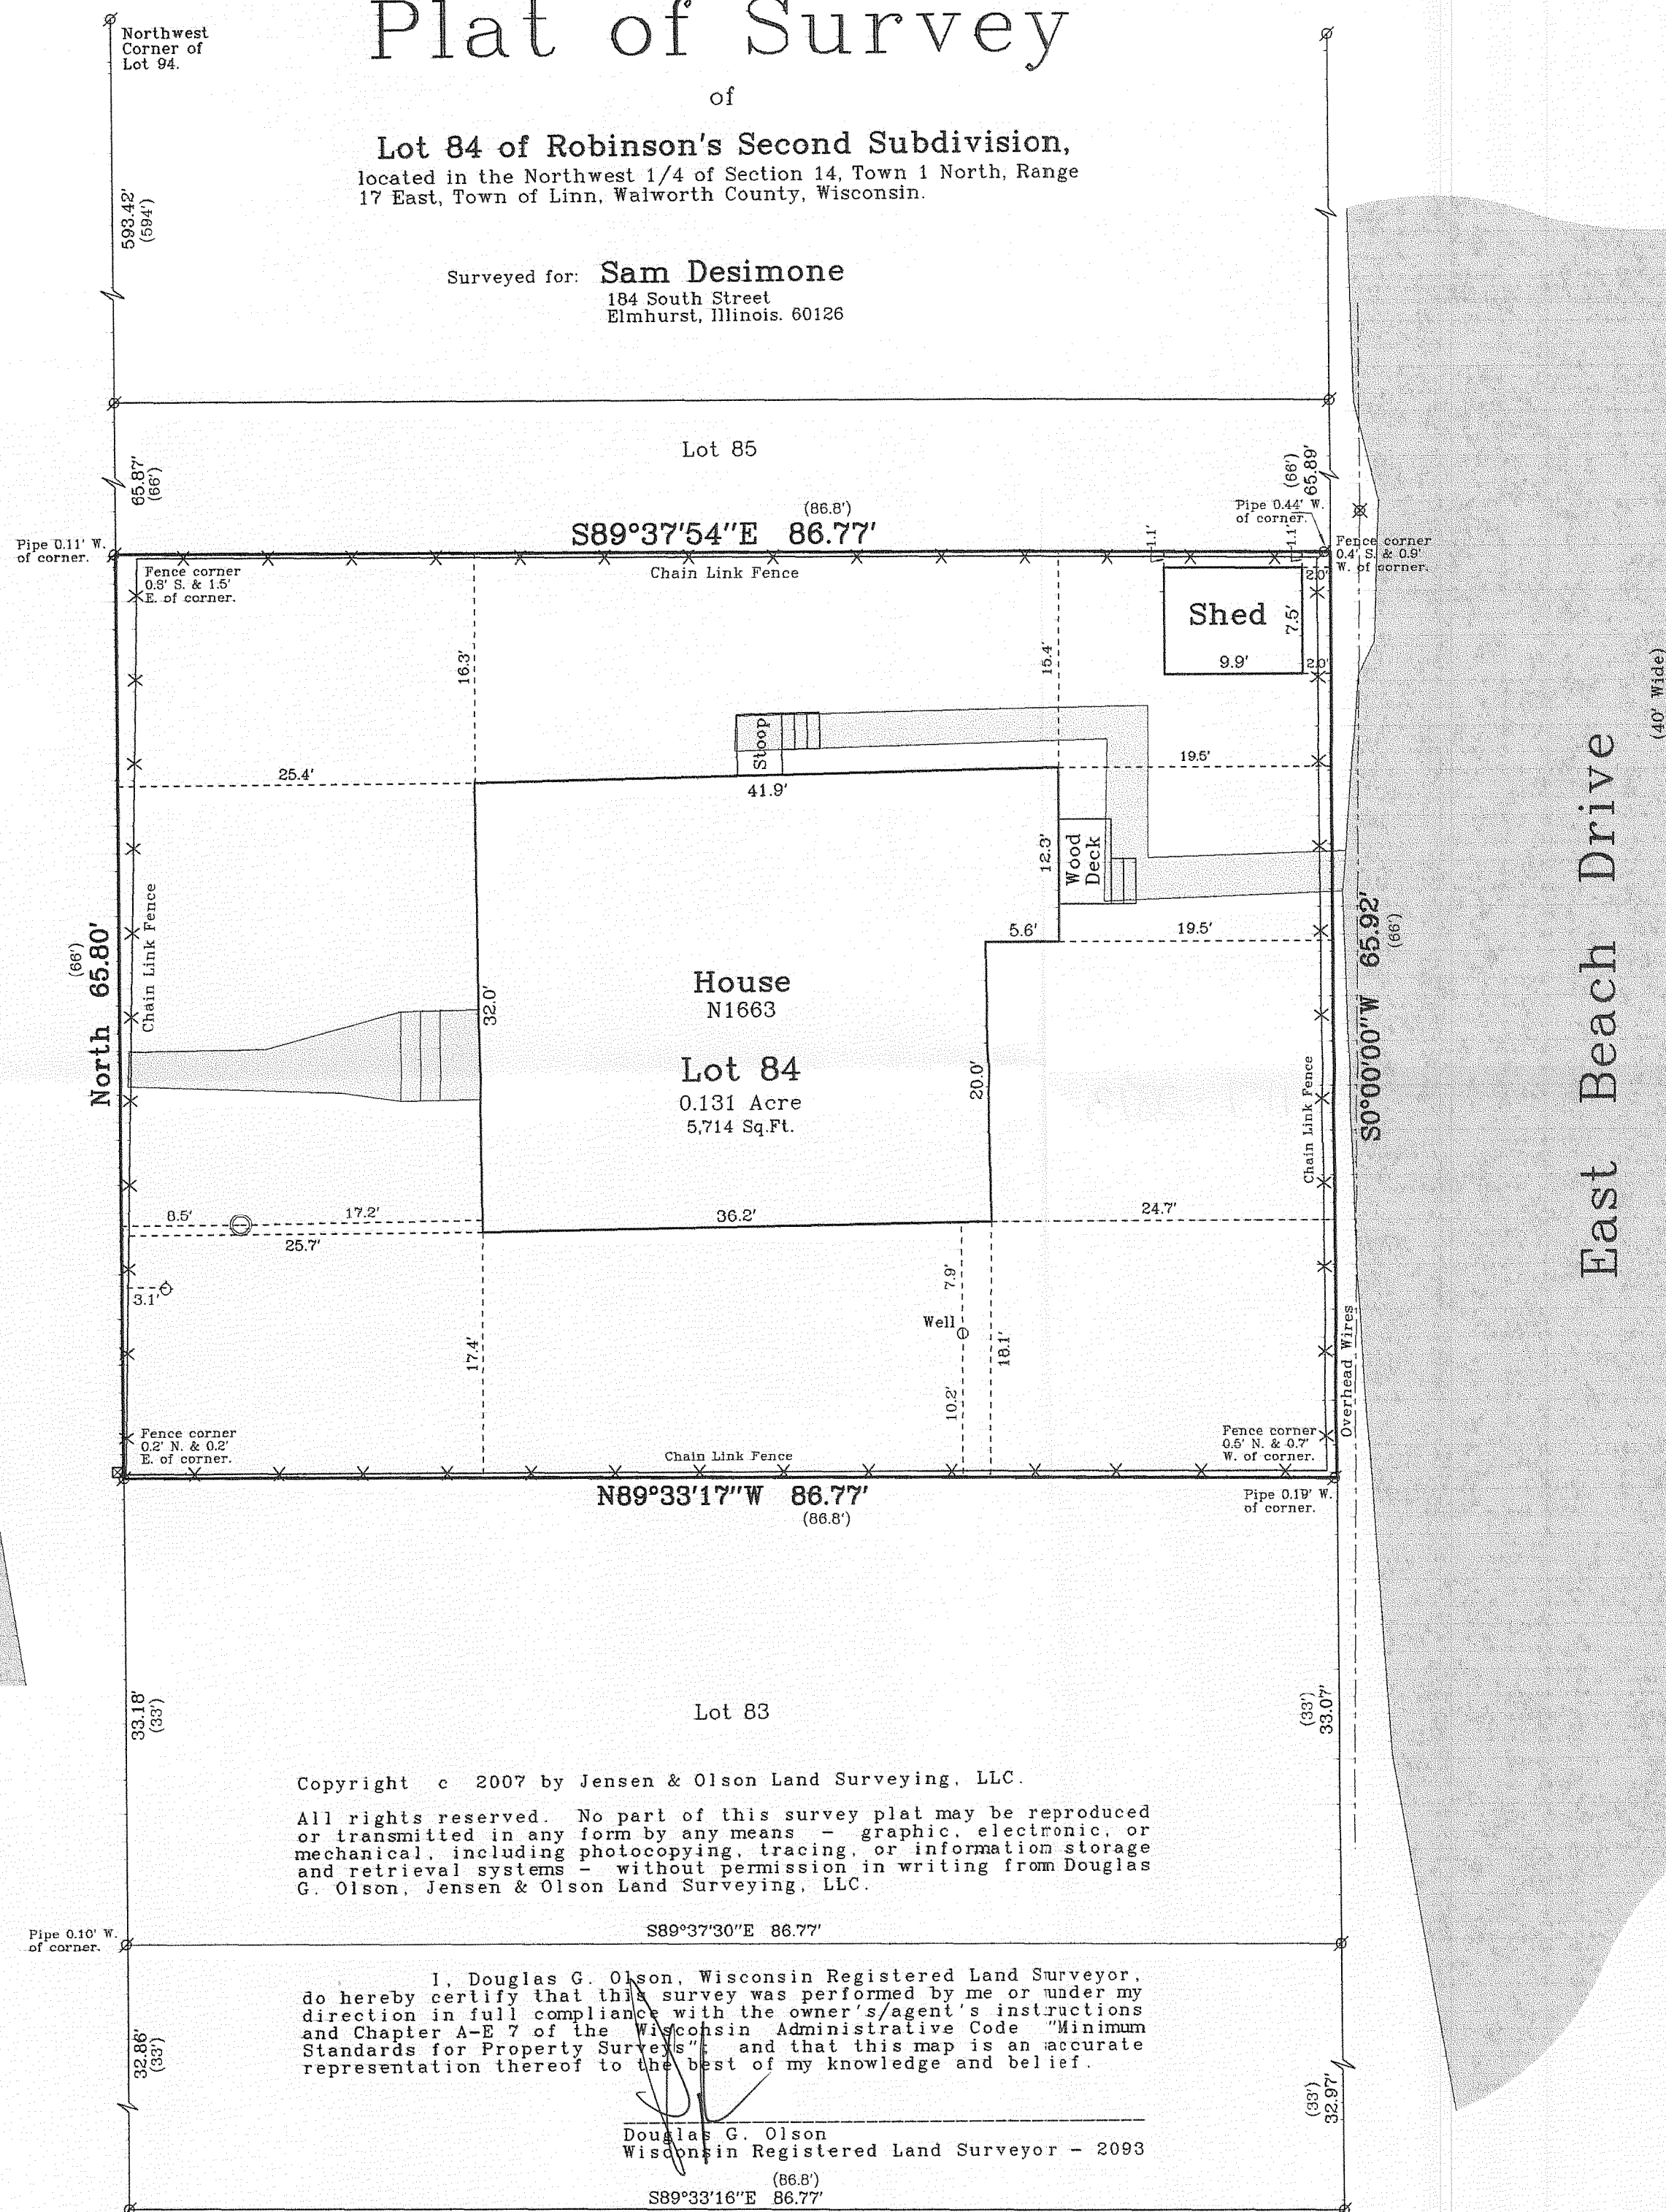

The logo of the National Bureau of Standards (NBS) is a circular emblem. It features a stylized compass rose with four points. The top point is a long, thin needle. The bottom point is a shorter, wider needle. The left and right points are represented by horizontal lines. In the center of the circle is a smaller circle containing the letters "NBS".

Bearings are assumed.

Jensen & Olson Land Surveying, LLC

45 South Wisconsin Street P.O. Box 322
Elkhorn, Wisconsin. 53121
Telephone (262) 723-3434
Facsimile (262) 723-8044

Survey Date: May 25, 2007.
Revisions:

Scale in Feet

Scale in Feet
1" = 10'
0' 5' 10' 20'

Legend

- Found Stone Monument
- Found Iron Pipe
- () Recorded Information
- ⊗ Utility Pedestal
- ⊗ Utility Concrete Cover
- ⊗ Septic Concrete Surface
- ⊗ Asphalt Surface

Sheet 1 of 1 Sheets

Job Reference Number

2007.066

Notes:

- 1) This survey plat is not certified unless signed and sealed in red ink.
- 2) This survey is subject to Wisconsin lien laws. This Plat of Survey is the notice of intent to file lien. Lien waiver required.

Copyright c 2007 by Jensen & Olson Land Surveying, LLC.

All rights reserved. No part of this survey plat may be reproduced or transmitted in any form by any means - graphic, electronic, or mechanical, including photocopying, tracing, or information storage and retrieval systems - without permission in writing from Douglas G. Olson, Jensen & Olson Land Surveying, LLC.

I, Douglas G. Olson, Wisconsin Registered Land Surveyor, do hereby certify that this survey was performed by me or under my direction in full compliance with the owner's/agent's instructions and Chapter A-E 7 of the Wisconsin Administrative Code "Minimum Standards for Property Surveys" and that this map is an accurate representation thereof to the best of my knowledge and belief.

Douglas G. Olson
Wisconsin Registered Land Surveyor - 2093

S89°33'16"E 86.77' (86.8')

IRB2-68

117-2813