


FARRIS, HANSEN & ASSOCIATES, INC.
 ENGINEERING - ARCHITECTURE - SURVEYING
 7 RIDGWAY COURT - P.O. BOX 437 - ELKHORN, WISCONSIN 53121
 PHONE: (262) 723-2098 FAX: (262) 723-5886

PLAT OF SURVEY OF

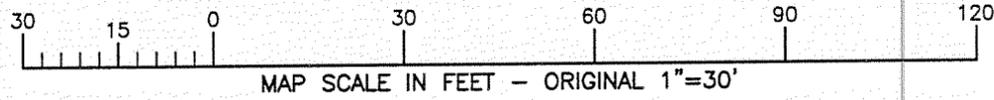


All that part of Lot 3 of Certified Survey Map No. 43 recorded in the office of the Register of Deeds for Walworth County, Wisconsin, in Volume 1 of Certified Survey Maps, on Page 43, as Document No. 632045, being a redivision of part of Lots 6 and 7, Block 1, Rowena Park Subdivision, in Section 5, Town 1 North, Range 17 East, Town of Linn, Walworth County, Wisconsin, described as follows, to-wit: Beginning at the most Westerly corner of said Lot 3; thence North 20° 57' East 7.00 feet; thence South 85° 49' East 233.77 feet; thence South 31° 49' East 60.04 feet; thence South 57° 56' 40" West 89.57 feet; thence South 86° 42' 20" West 97.23 feet; thence North 39° 27' West 148.51 feet to the place of beginning. Subject to an easement 5 feet in width over and across the most Easterly part and most Southerly part of the real estate above described.

Tax Key No. IA 4300003A

NOTE: TITLE REFERS TO A "RESERVATION FOR EASEMENT" RECORDED IN VOLUME 475 OF DEEDS ON PAGE 21 AS DOCUMENT NO. 465180. THIS EASEMENT APPEARS TO BE SOUTHWESTERLY OF THE PARCEL SURVEYED HEREON AND DOES NOT APPEAR TO AFFECT SAID PARCEL.


NOTE: TITLE REFERS TO A "UTILITY EASEMENT GRANTED...TO THE WISCONSIN SOUTHERN GAS COMPANY" RECORDED IN VOLUME 596 OF DEEDS ON PAGES 93 & 94 AS DOCUMENT NO. 552632. THIS EASEMENT DOES NOT HAVE A SPECIFIC WIDTH OR LOCATION BUT APPEARS TO BE A BLANKET EASEMENT THAT COVERS THE PARCEL SURVEYED HEREON AND OTHER LANDS EASTERLY AND SOUTHERLY OF SAID PARCEL.

RECORD LEGAL DESCRIPTION FROM TITLE COMMITMENT PROVIDED BY CLIENT

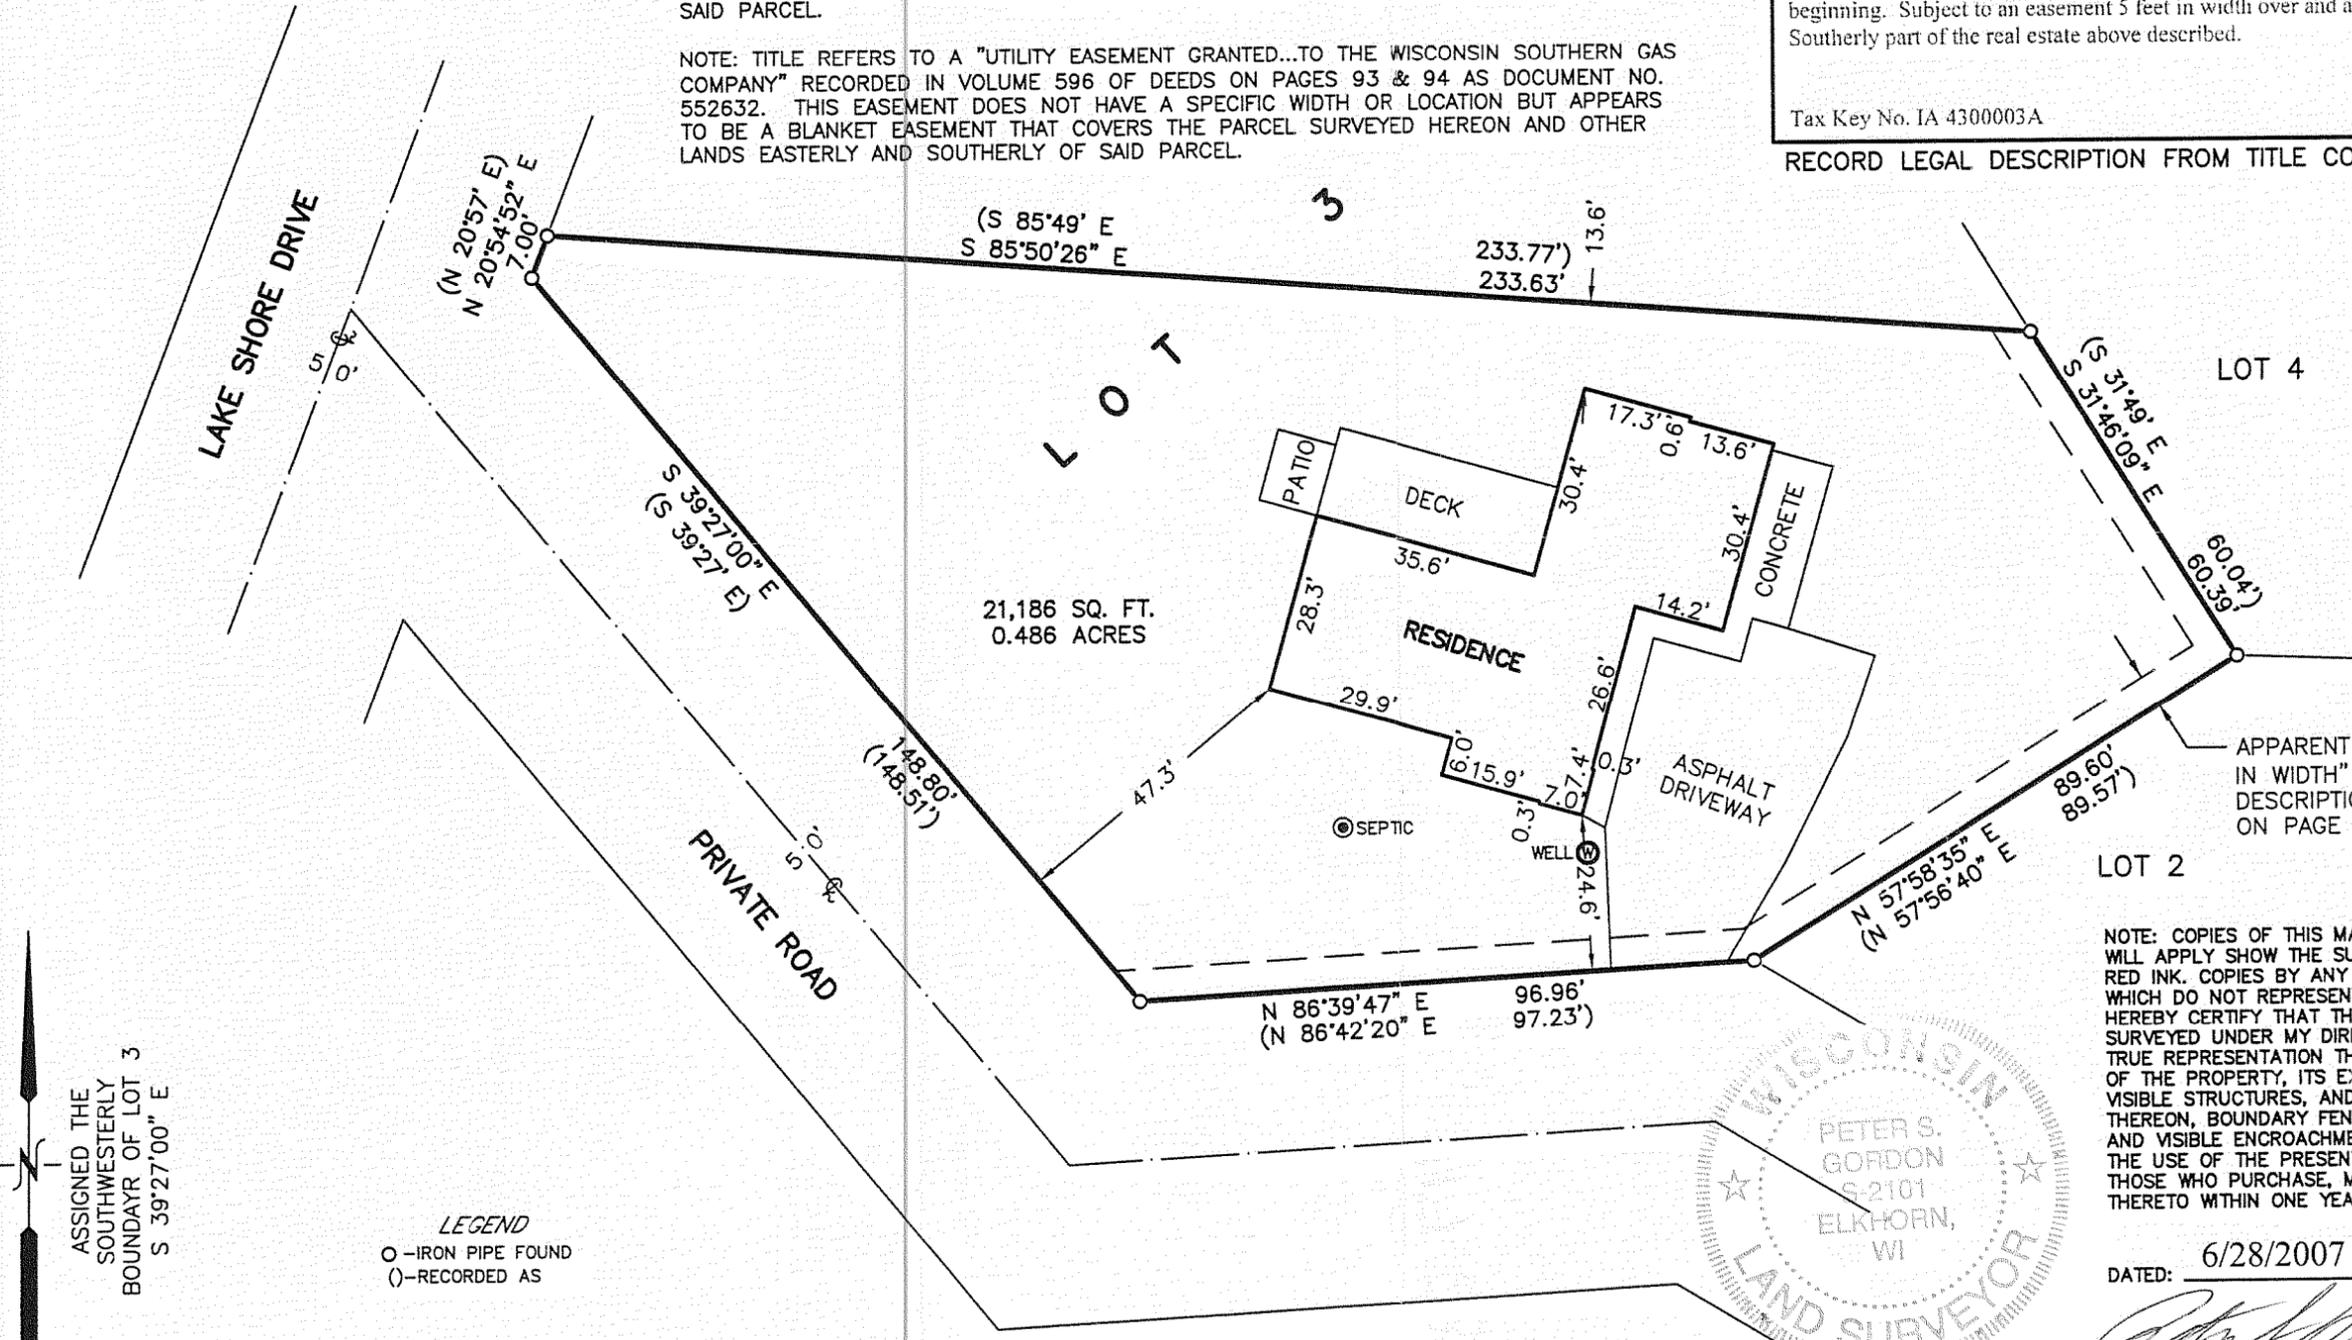

APPARENT LOCATION OF "EASEMENT 5 FEET IN WIDTH" REFERENCED IN LEGAL DESCRIPTION AND IN VOL. 650 OF RECORDS ON PAGE 6289 AS DOCUMENT NO. 367569

NOTE: COPIES OF THIS MAP TO WHICH THE FOLLOWING CERTIFICATE WILL APPLY SHOW THE SURVEYOR'S ORIGINAL SEAL AND SIGNATURE IN RED INK. COPIES BY ANY OTHER MEANS MAY HAVE ALTERATIONS WHICH DO NOT REPRESENT THE SURVEYOR'S WORK PRODUCT. I HEREBY CERTIFY THAT THE ABOVE DESCRIBED PROPERTY HAS BEEN SURVEYED UNDER MY DIRECTION AND THAT THE ABOVE MAP IS A TRUE REPRESENTATION THEREOF AND SHOWS THE SIZE AND LOCATION OF THE PROPERTY, ITS EXTERIOR BOUNDARIES, THE LOCATION OF ALL VISIBLE STRUCTURES, AND DIMENSIONS OF ALL PRINCIPLE BUILDINGS THEREON, BOUNDARY FENCES, APPARENT EASEMENTS, ROADWAYS, AND VISIBLE ENCROACHMENTS, IF ANY. THIS SURVEY IS MADE FOR THE USE OF THE PRESENT OWNERS OF THE PROPERTY, AND ALSO THOSE WHO PURCHASE, MORTGAGE, OR GUARANTEE THE TITLE THERETO WITHIN ONE YEAR FROM THE DATE HEREOF.

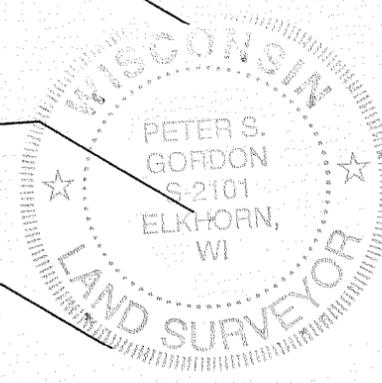

DATED: 6/28/2007
 PETER S. GORDON

PROJECT: 7361
 DATE: 06/28/2007
 SHEET 1 OF 1

ASSIGNED THE SOUTHWESTERLY BOUNDARY OF LOT 3 S 39°27'00" E

LEGEND
 O - IRON PIPE FOUND
 () - RECORDED AS

IA43-3

117-2830