

PREPARED FOR : STEVE SCHWEFEL
1558 N. CREEKSIDE LN.
LAKE GENEVA WI. 53147


PLAT OF SURVEY

- OF -

PATHFINDER SURVEYING INC.
W2888 KRUEGER RD. UNIT "D"
LAKE GENEVA WI. 53147
(262) 248-3697

LOT 4 ACADEMY ESTATES, BEING A PART OF THE NORTHEAST
FRACTIONAL 1/4 AND PART OF THE SOUTHEAST 1/4 OF SECTION
18, TOWNSHIP 1 NORTH, RANGE 17 EAST, TOWN OF LINN,
WALWORTH COUNTY, WISCONSIN.

C.L. CREEKSIDE LANE
(66' WIDE ROAD)

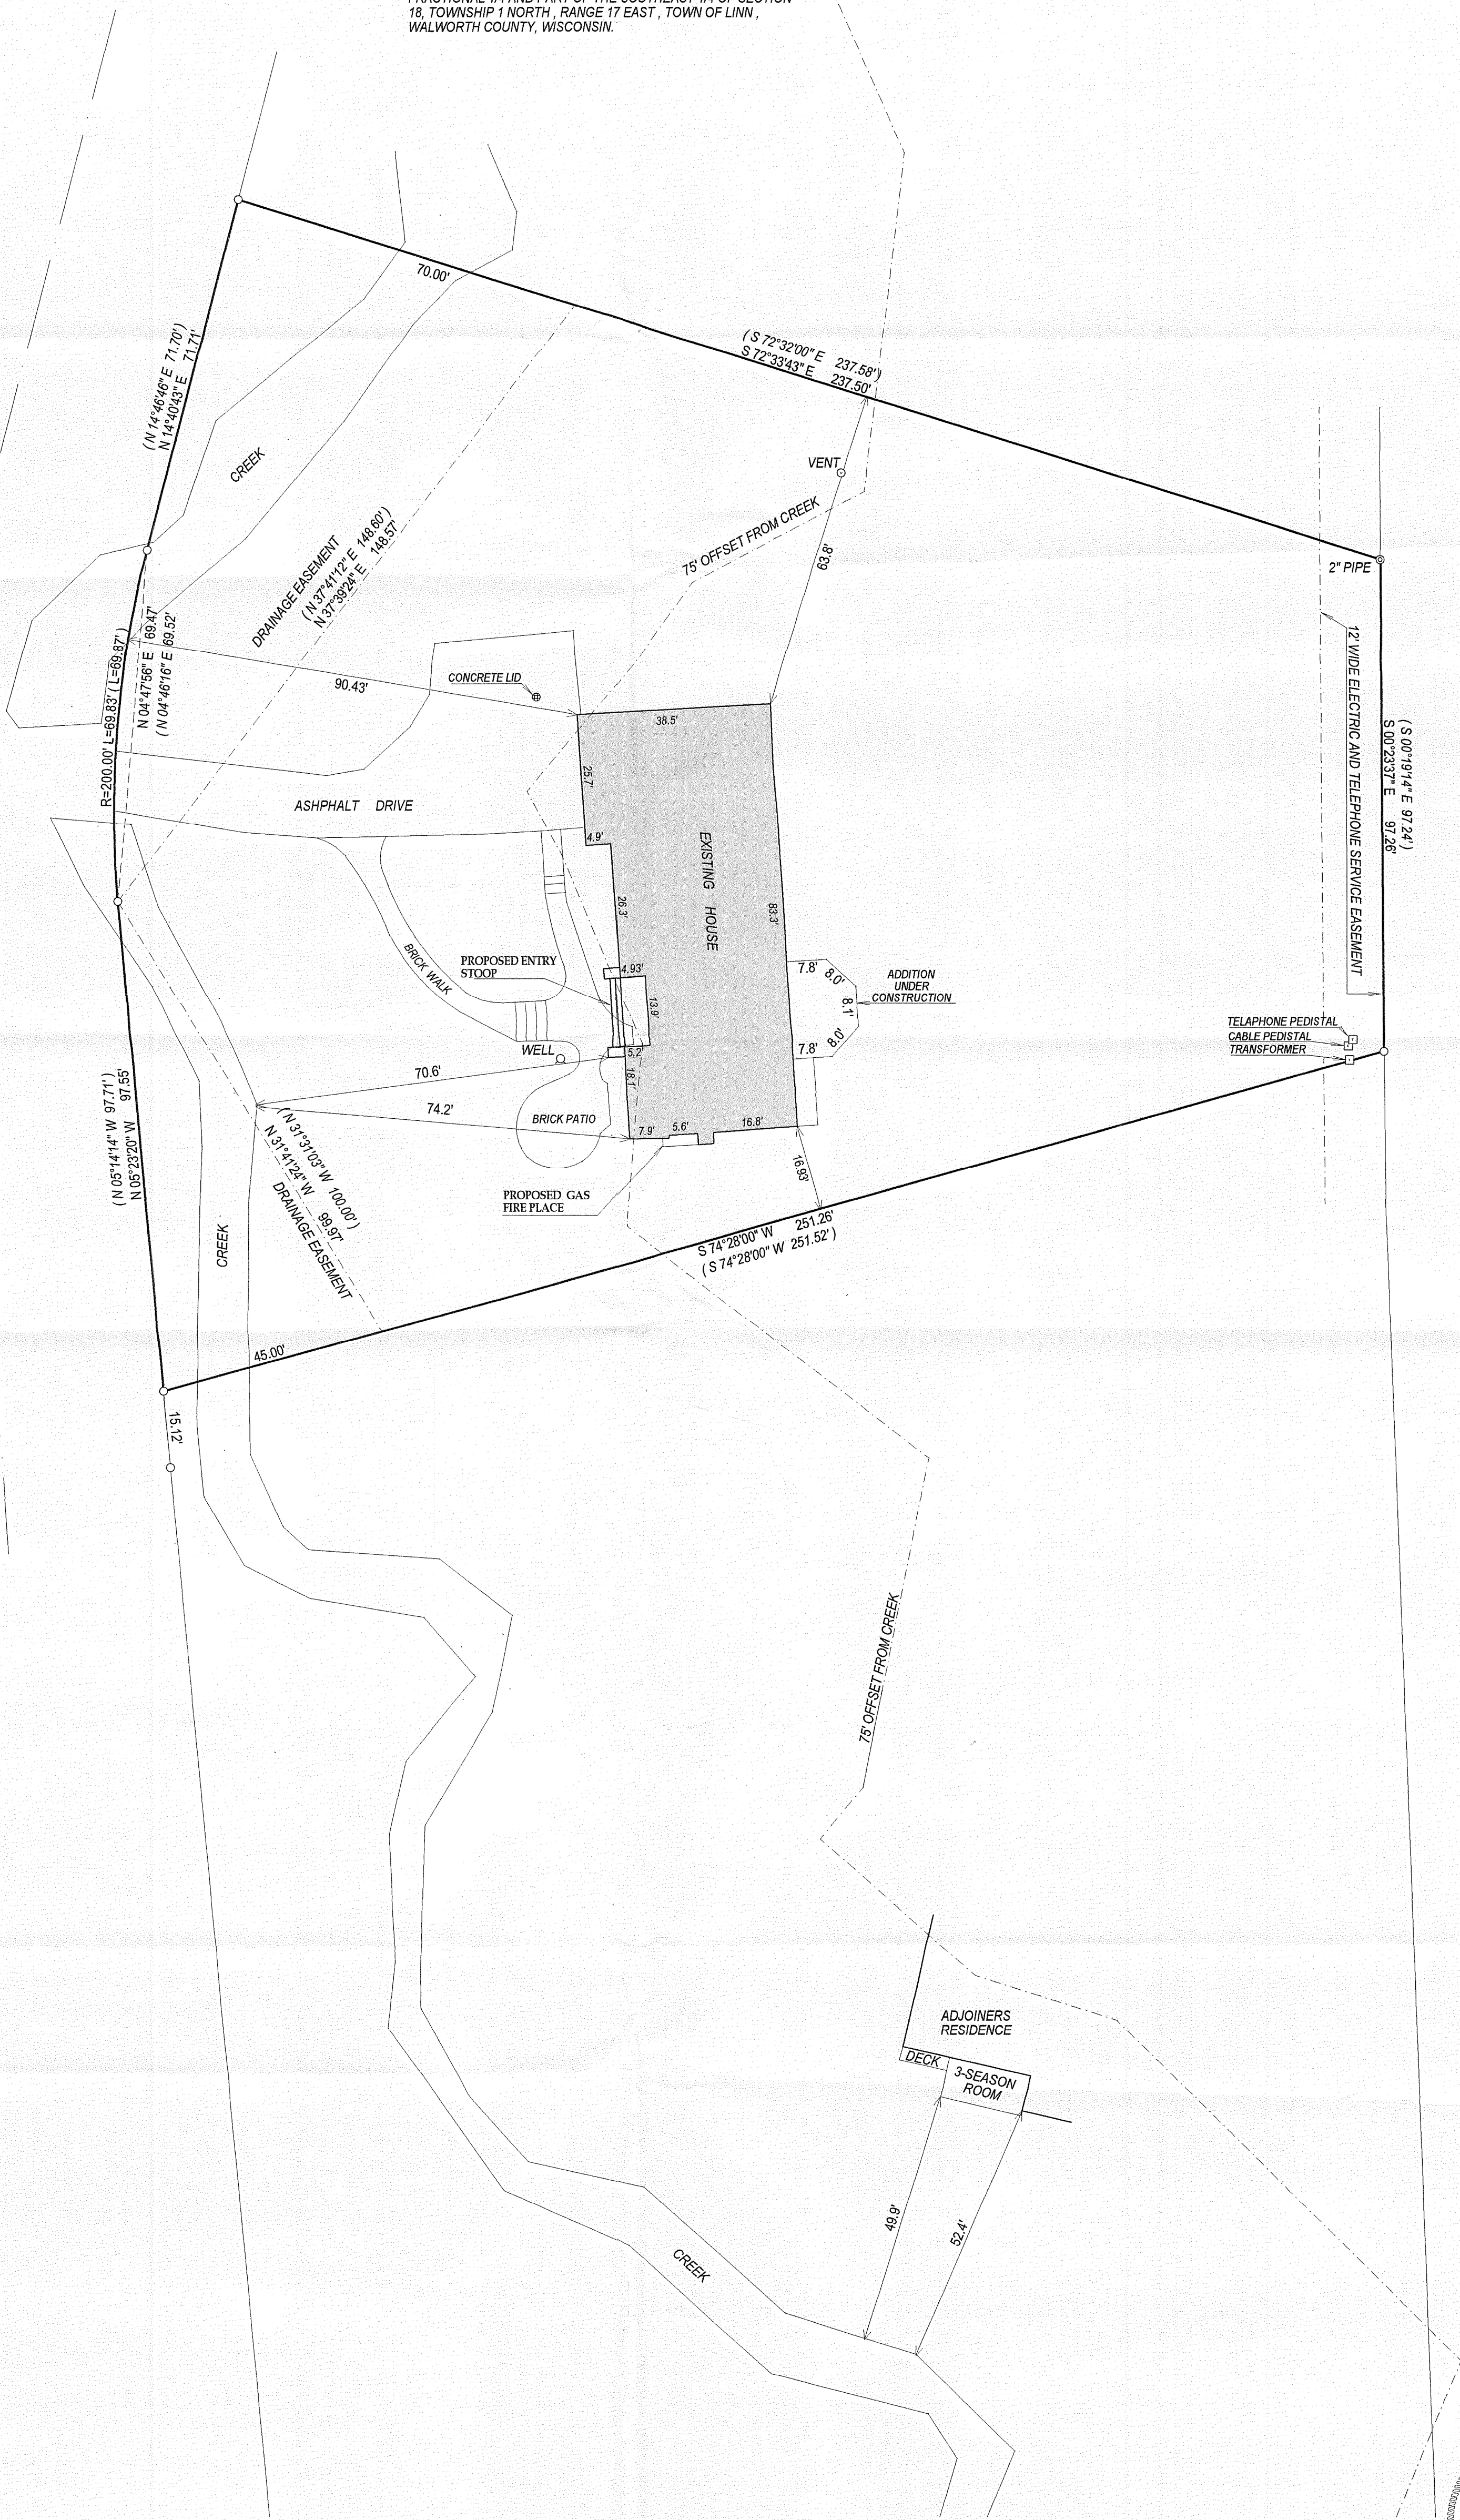


- () = recorded as
- = found iron bar
- = found iron pipe
- = set iron pipe
- = set iron bar

SCALE 1" = 20'


JOB # 03-781ADD

TAX ID # 1AE00004

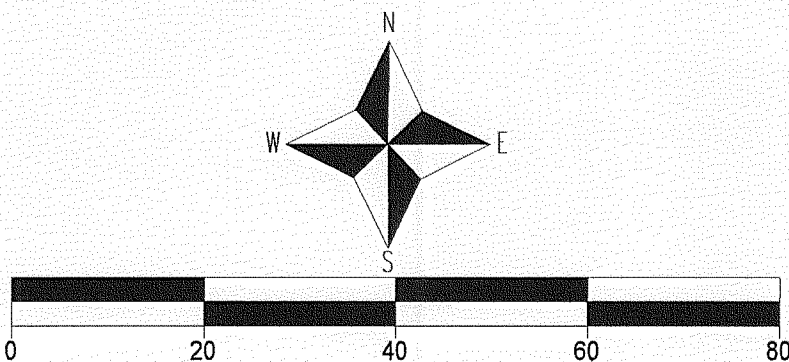

COMPARE LEGAL DESCRIPTION ABOVE AND DRAWING WITH DEED, FOR BUILDING RESTRICTIONS AND
EASEMENTS NOT SHOWN, REFER TO DEED, ABSTRACT SOURCES AND LOCAL MUNICIPAL CODES. NOTIFY
THE SURVEYOR IMMEDIATELY OF ANY DISCREPANCY.

"I hereby certify that I have surveyed the above described property and that,
to the best of my knowledge and belief the above map is a true
representation thereof and shows the size and location of all visible
structures, apparent easements and encroachments if any."
This survey is made for the present owners of the property, and those who
purchase, mortgage, or guarantee the title thereto, within one year from the
date hereof.

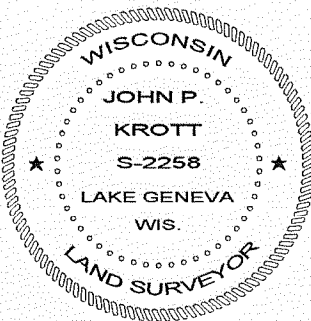

JOHN KROTT S - 2258
Wisconsin Registered Land Surveyor
(original if signed in red)
DATE OF LAST REVISION 5 / 30 / 2007
DATED THIS THE 31st DAY OF DECEMBER 2003.

117-2841