


94-71

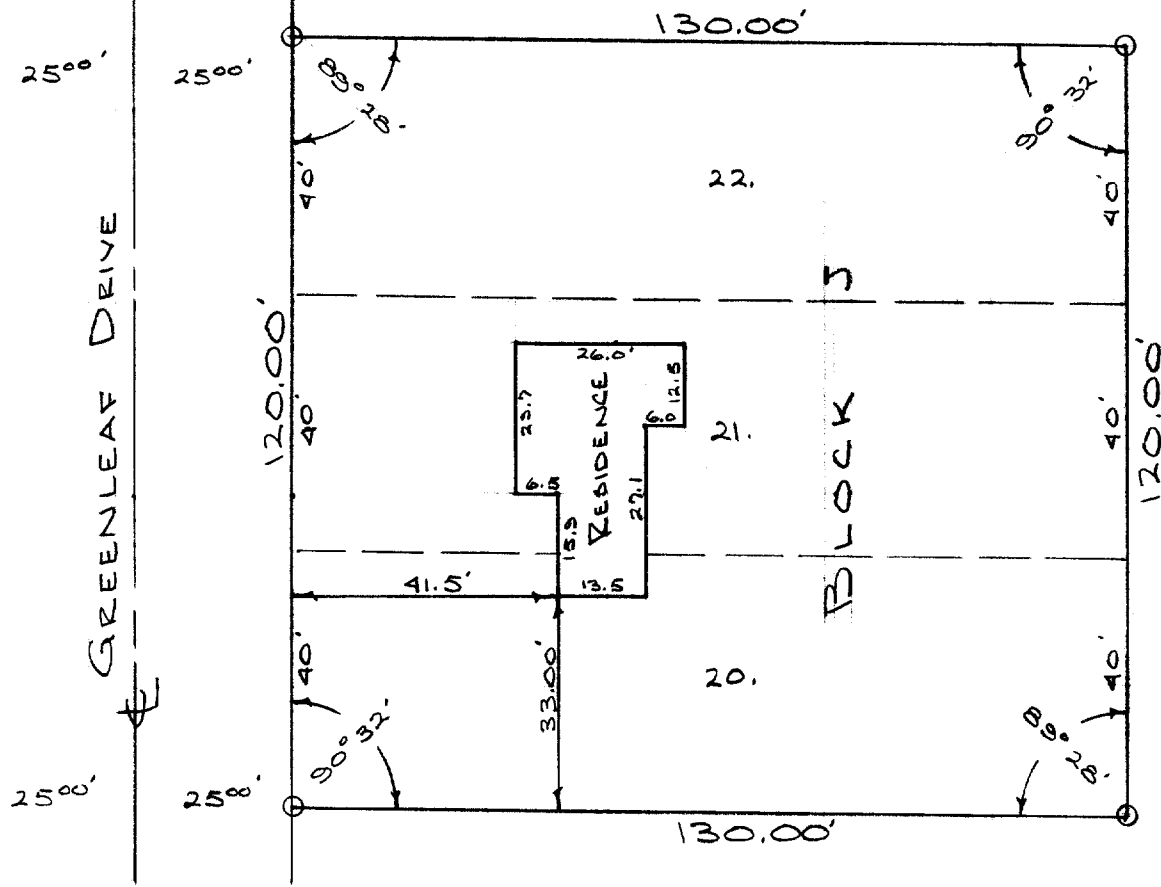

O- INDICATES IRON PIPE

DESCRIPTION:


Lots 20, 21, 22, in Block J of Cisco Beach Subdivision,
located in the NW $\frac{1}{4}$ of the NE $\frac{1}{4}$ of Section 5, T.1 N.,
R.17 E., Walworth County, Wisconsin.

CERTIFICATE:

I, James F. Biagi, surveyor, do hereby certify that I
have surveyed the property hereon described.

May 3, 1971.

James F. Biagi
James F. Biagi, RLS 272

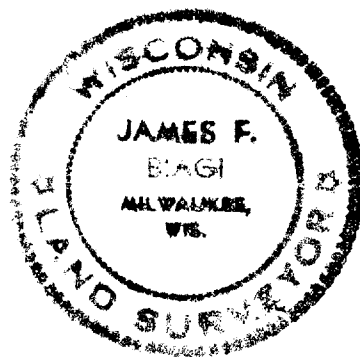

ICT-233

117-286